




SKewed
41+47

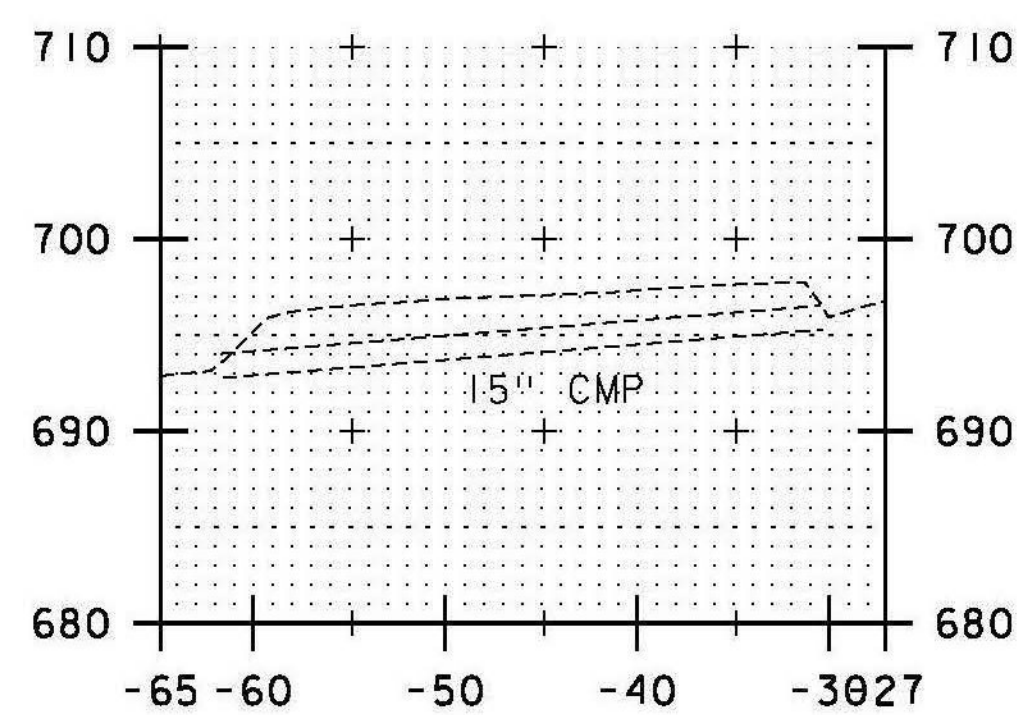

DRIVE LT
40+68

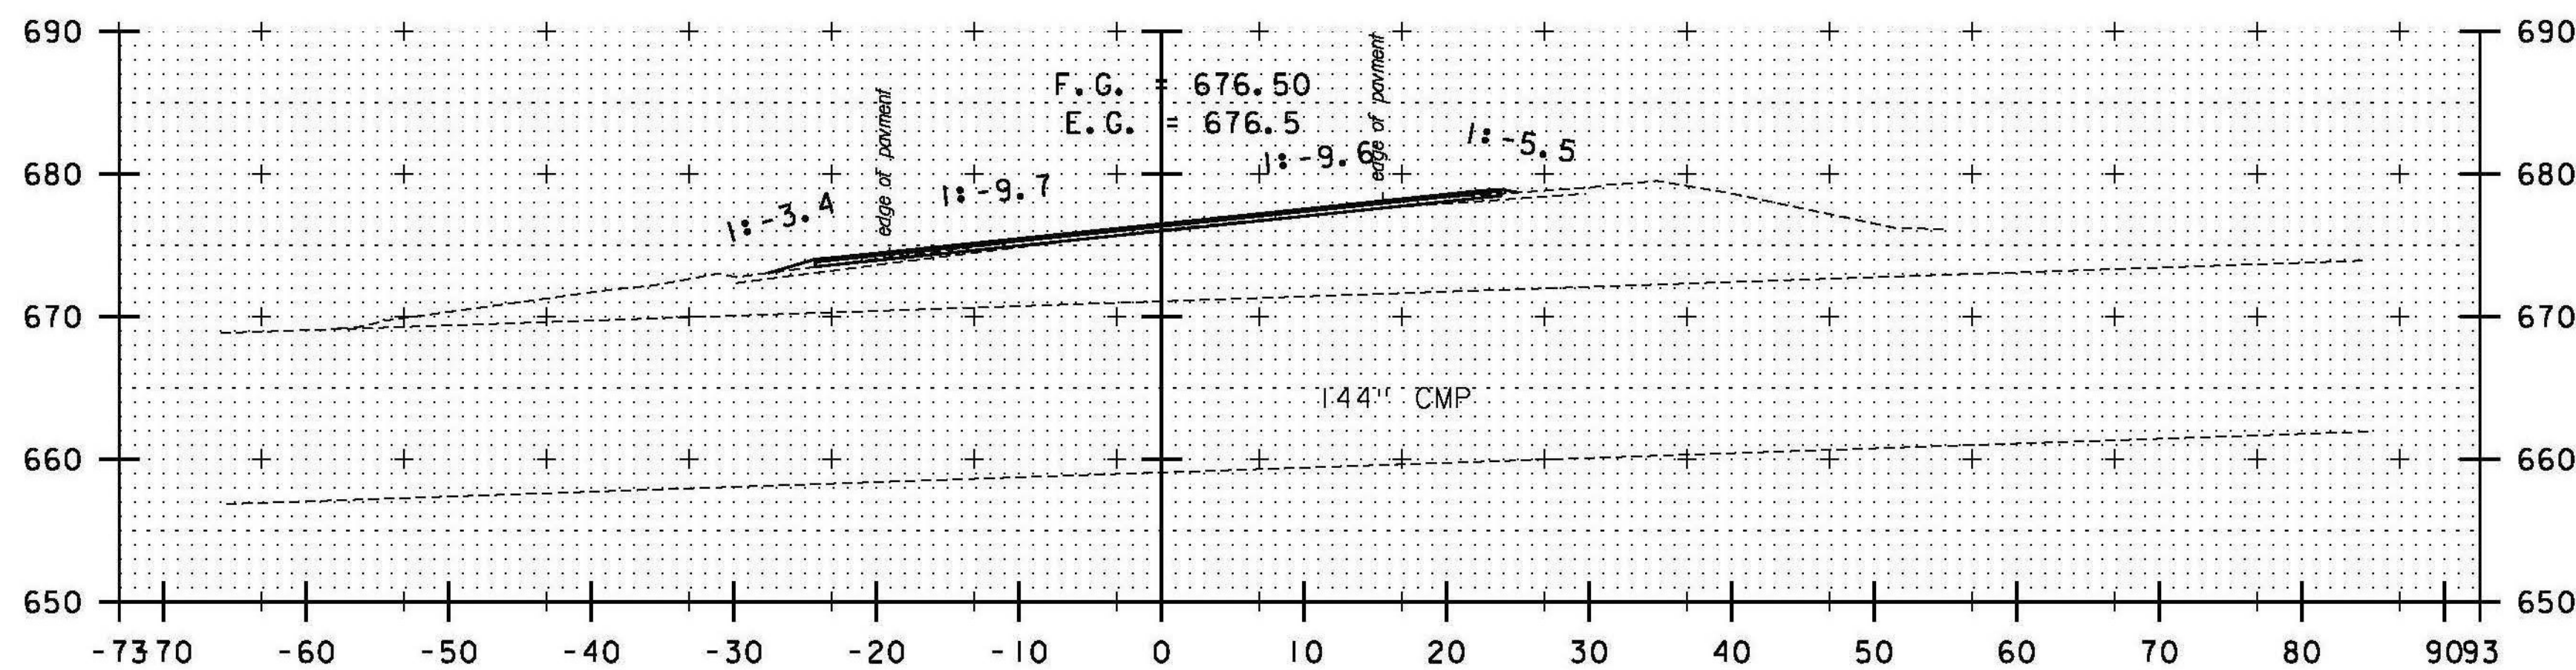


SKewed
38+24

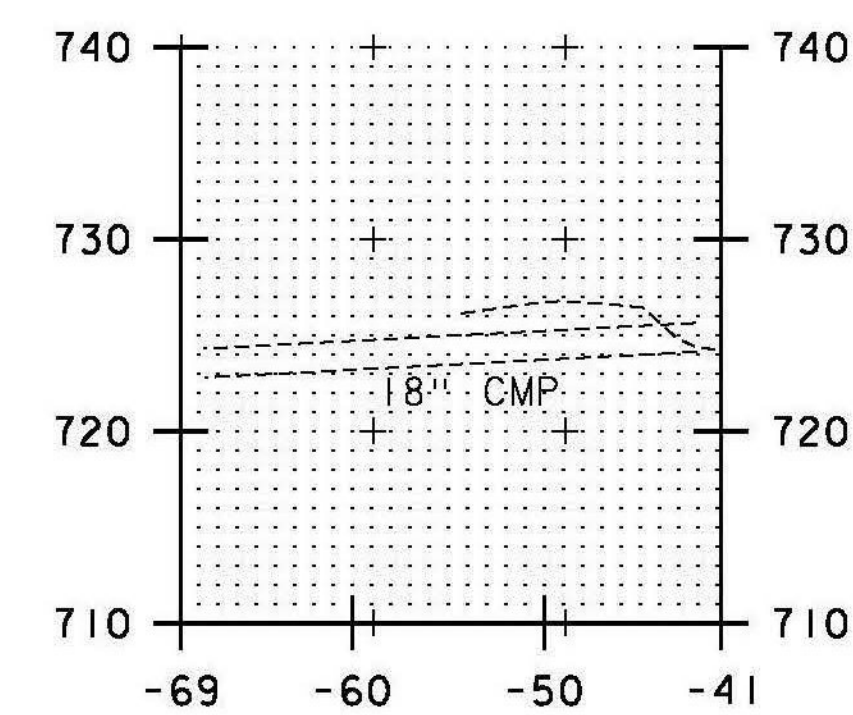

DRIVE LT
43+61

DATUM
VERTICAL NAVD 88
HORIZONTAL NAD 83

STA. 38+24 TO STA. 43+61

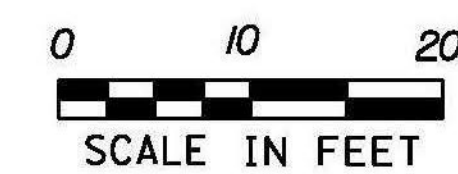

PROJECT NAME: RANDOLPH
PROJECT NUMBER: STP 2932 (1)

FILE NAME: z10c270.dgn
PROJECT LEADER: C. LATHROP
DESIGNED BY: B. BRESLEND
CULVERT CROSS SECTION SHEET 2

PLOT DATE: 6/5/2014
DRAWN BY: B. BRESLEND
CHECKED BY: C. LATHROP
SHEET 249 OF 276