




82+56

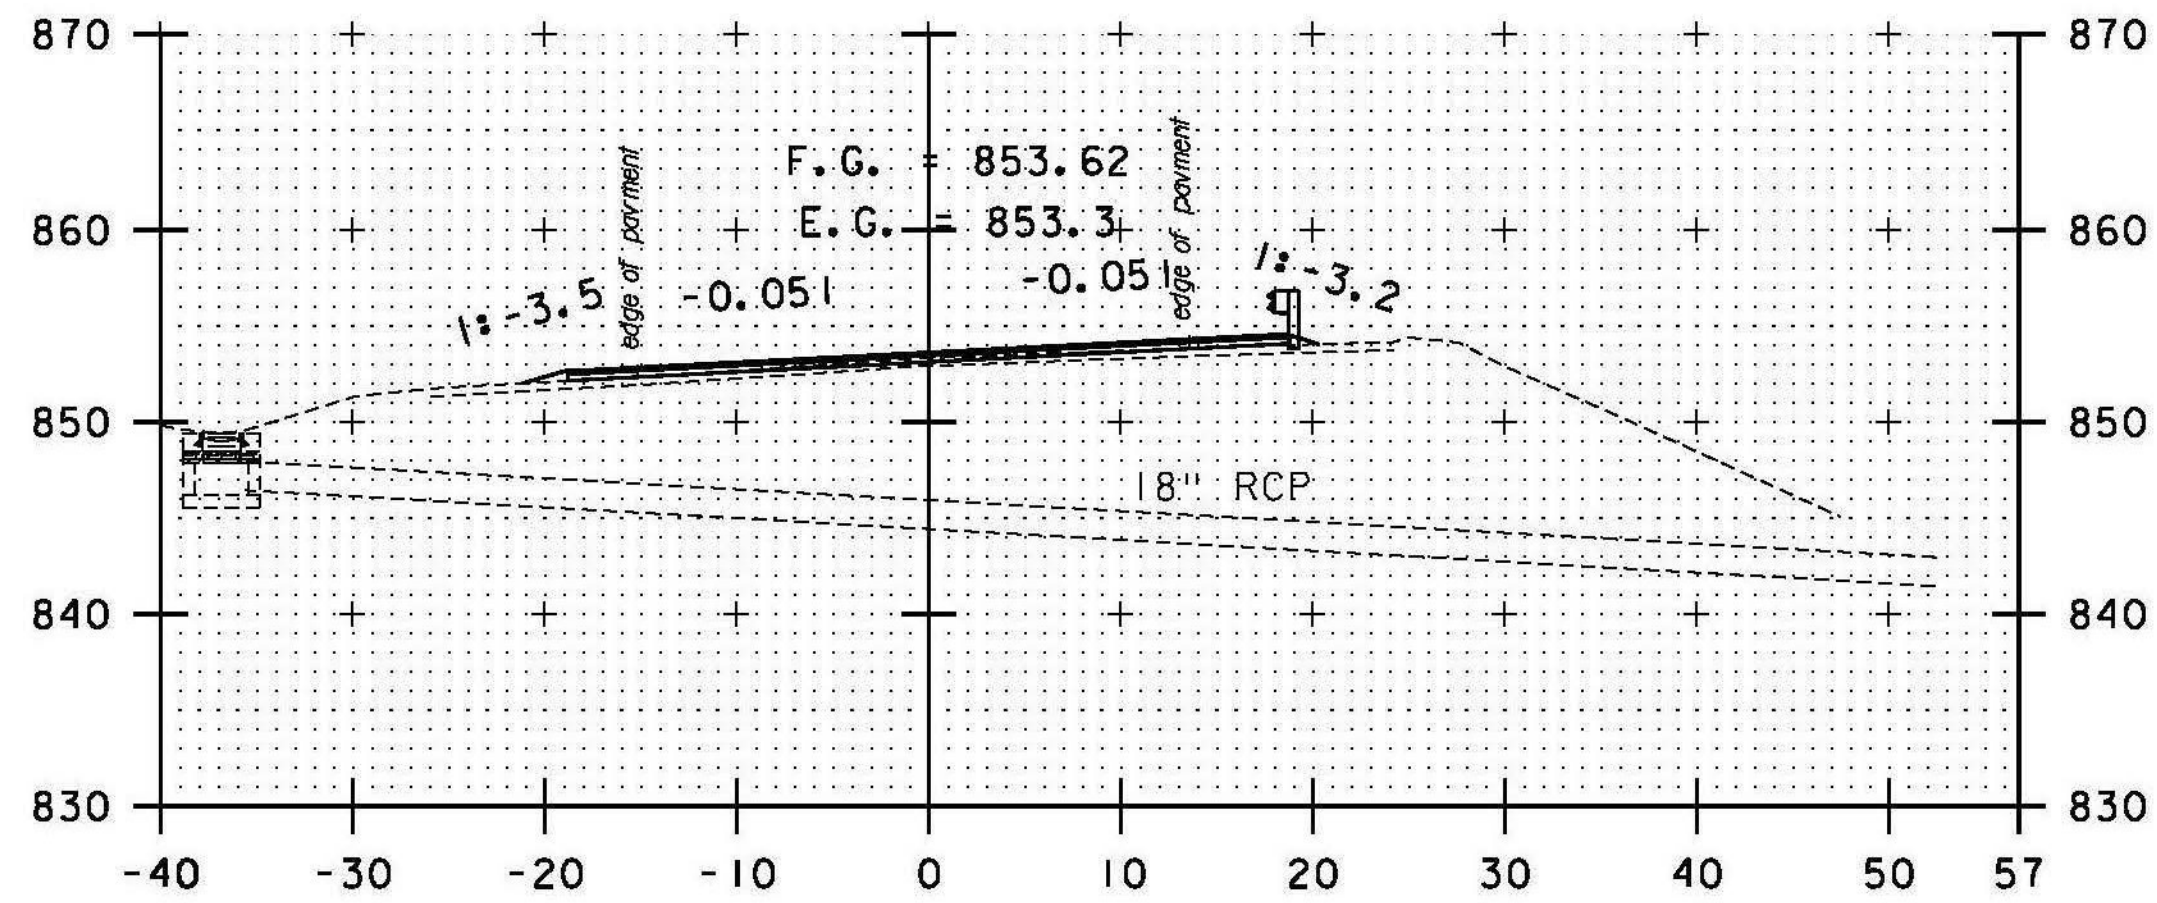


SKEWED
73+72

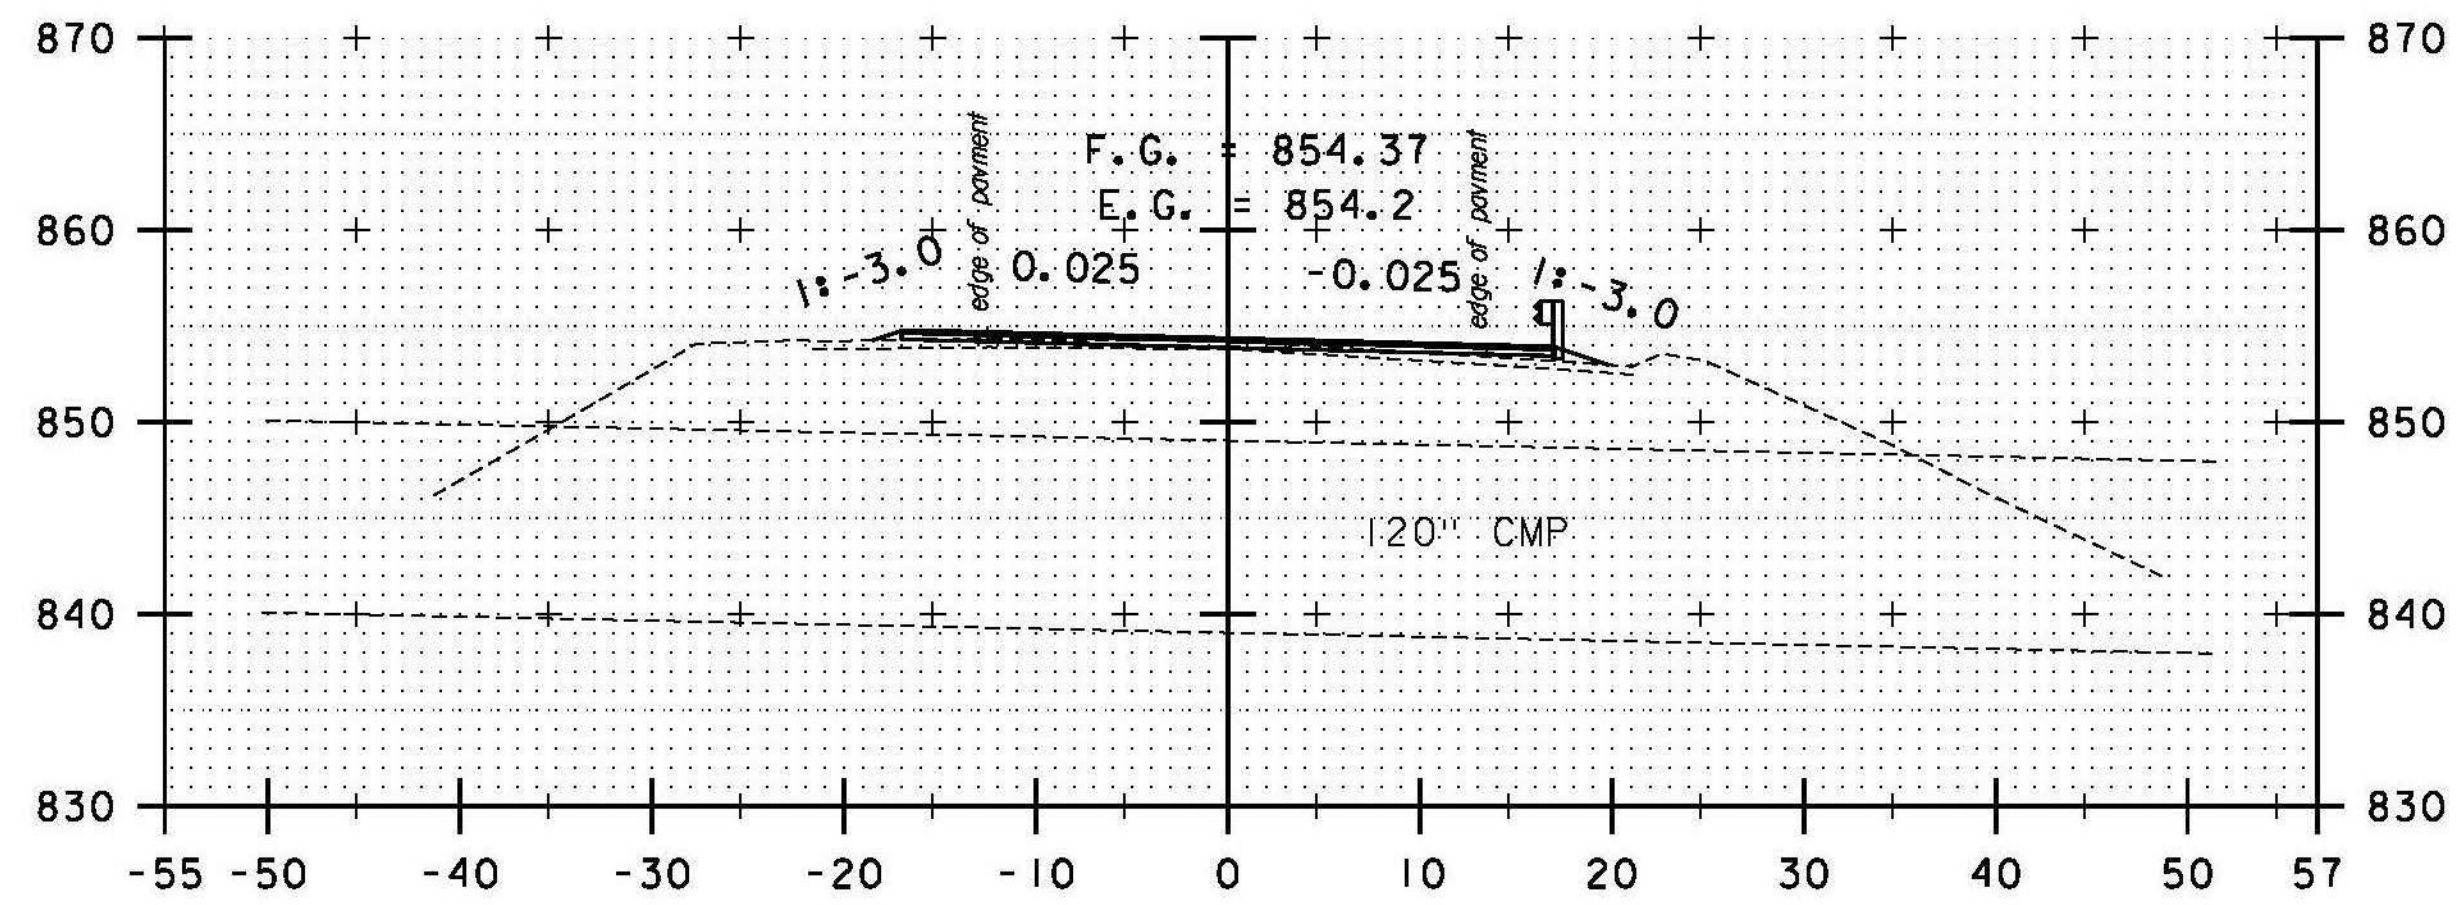

85+95

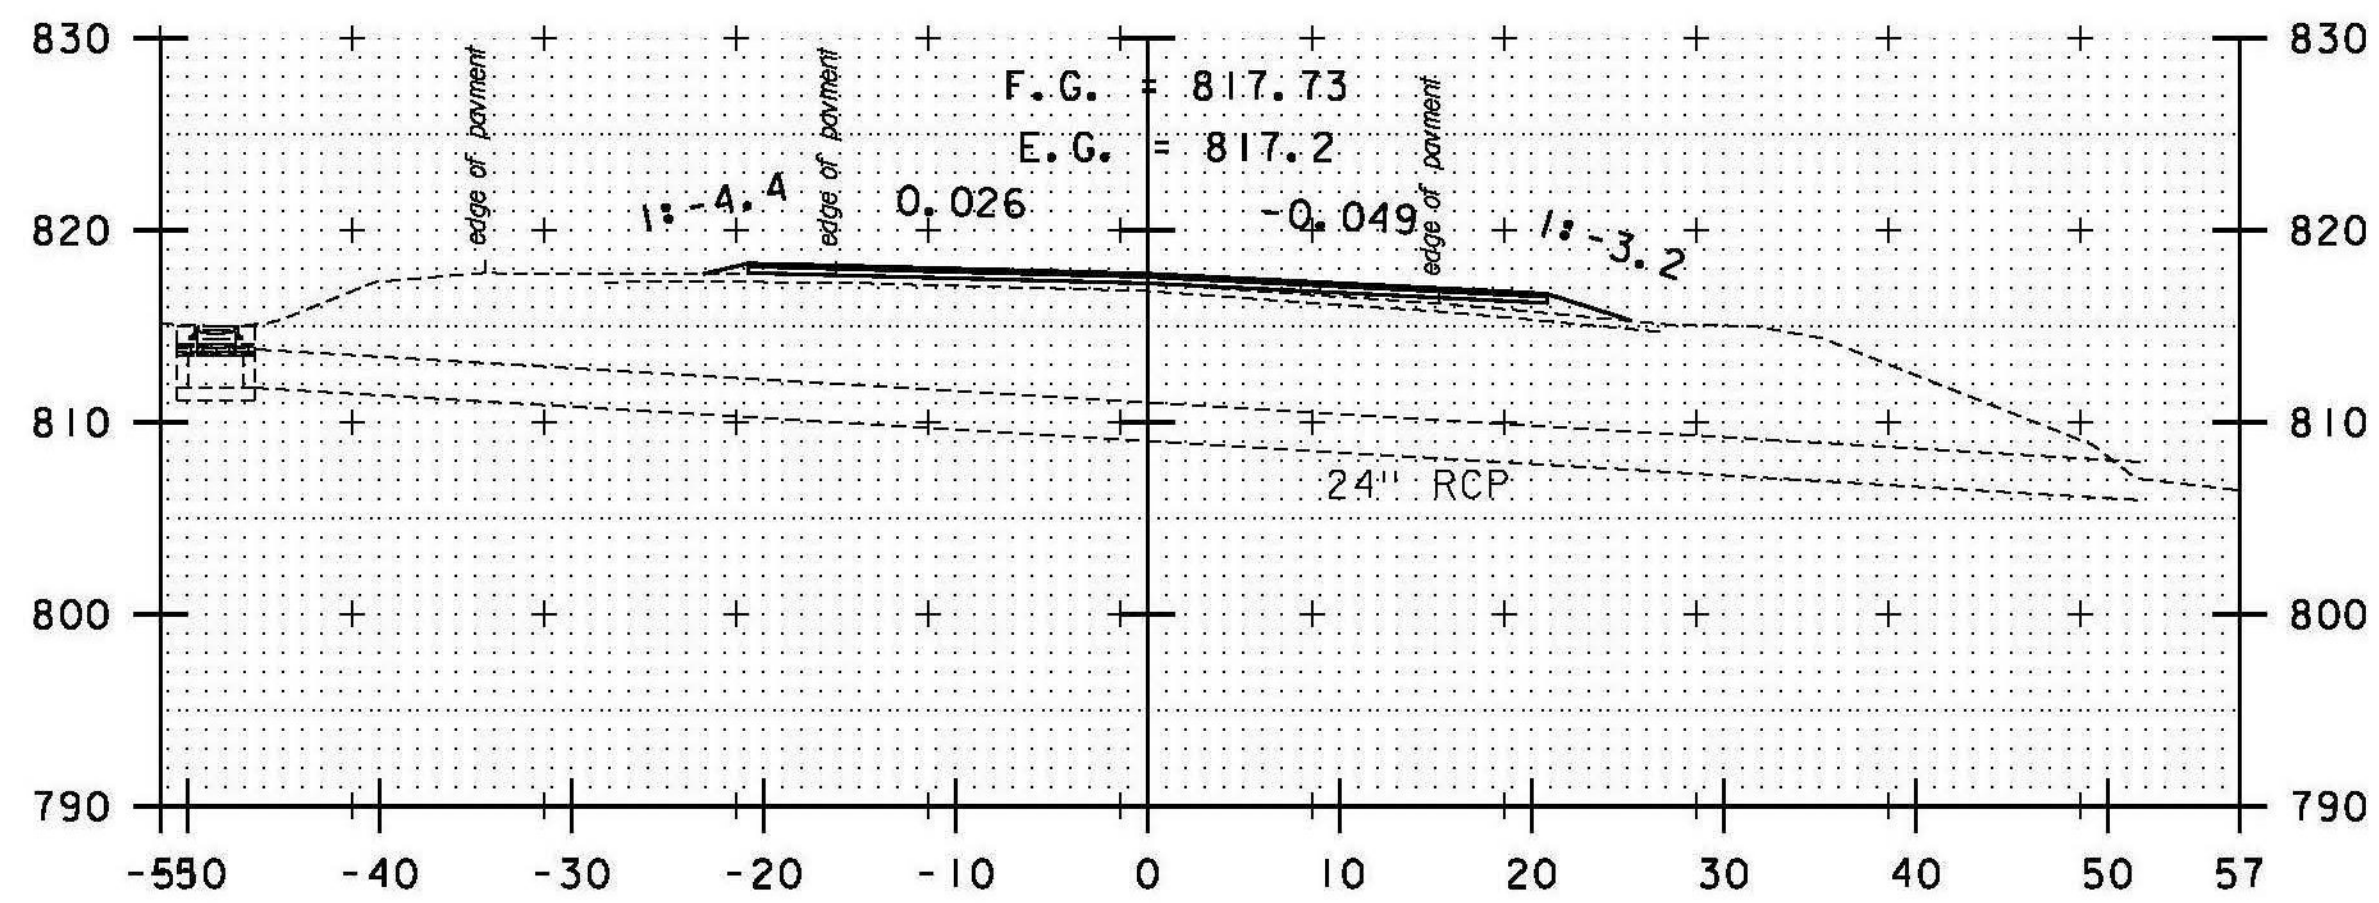


SKEWED
68+40

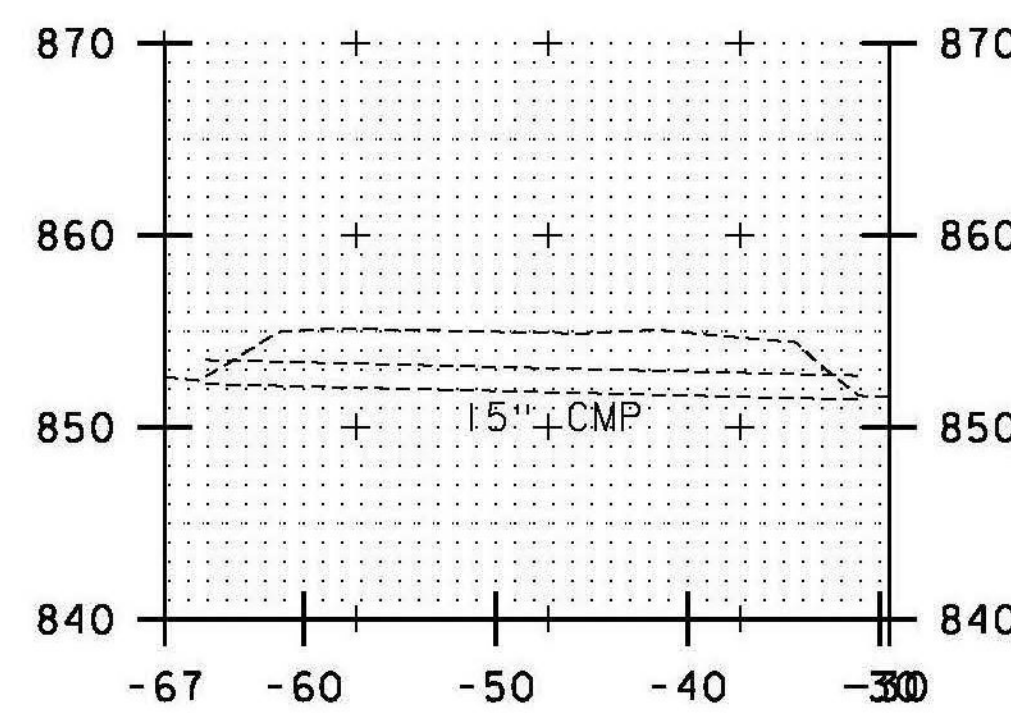

DRIVE LT
84+40

DATUM
VERTICAL NAVD 88
HORIZONTAL NAD 83

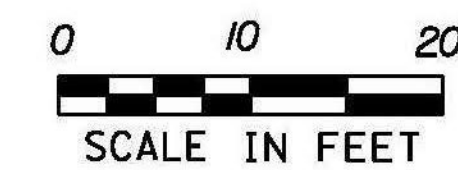

STA. 68+40 TO STA. 85+95

PROJECT NAME: RANDOLPH
PROJECT NUMBER: STP 2932 (1)

FILE NAME: z10c270.dgn
PROJECT LEADER: C. LATHROP
DESIGNED BY: B. BRESLEND
CULVERT CROSS SECTION SHEET 4

PLOT DATE: 6/5/2014
DRAWN BY: B. BRESLEND
CHECKED BY: C. LATHROP
SHEET 251 OF 276