



102+79 RT

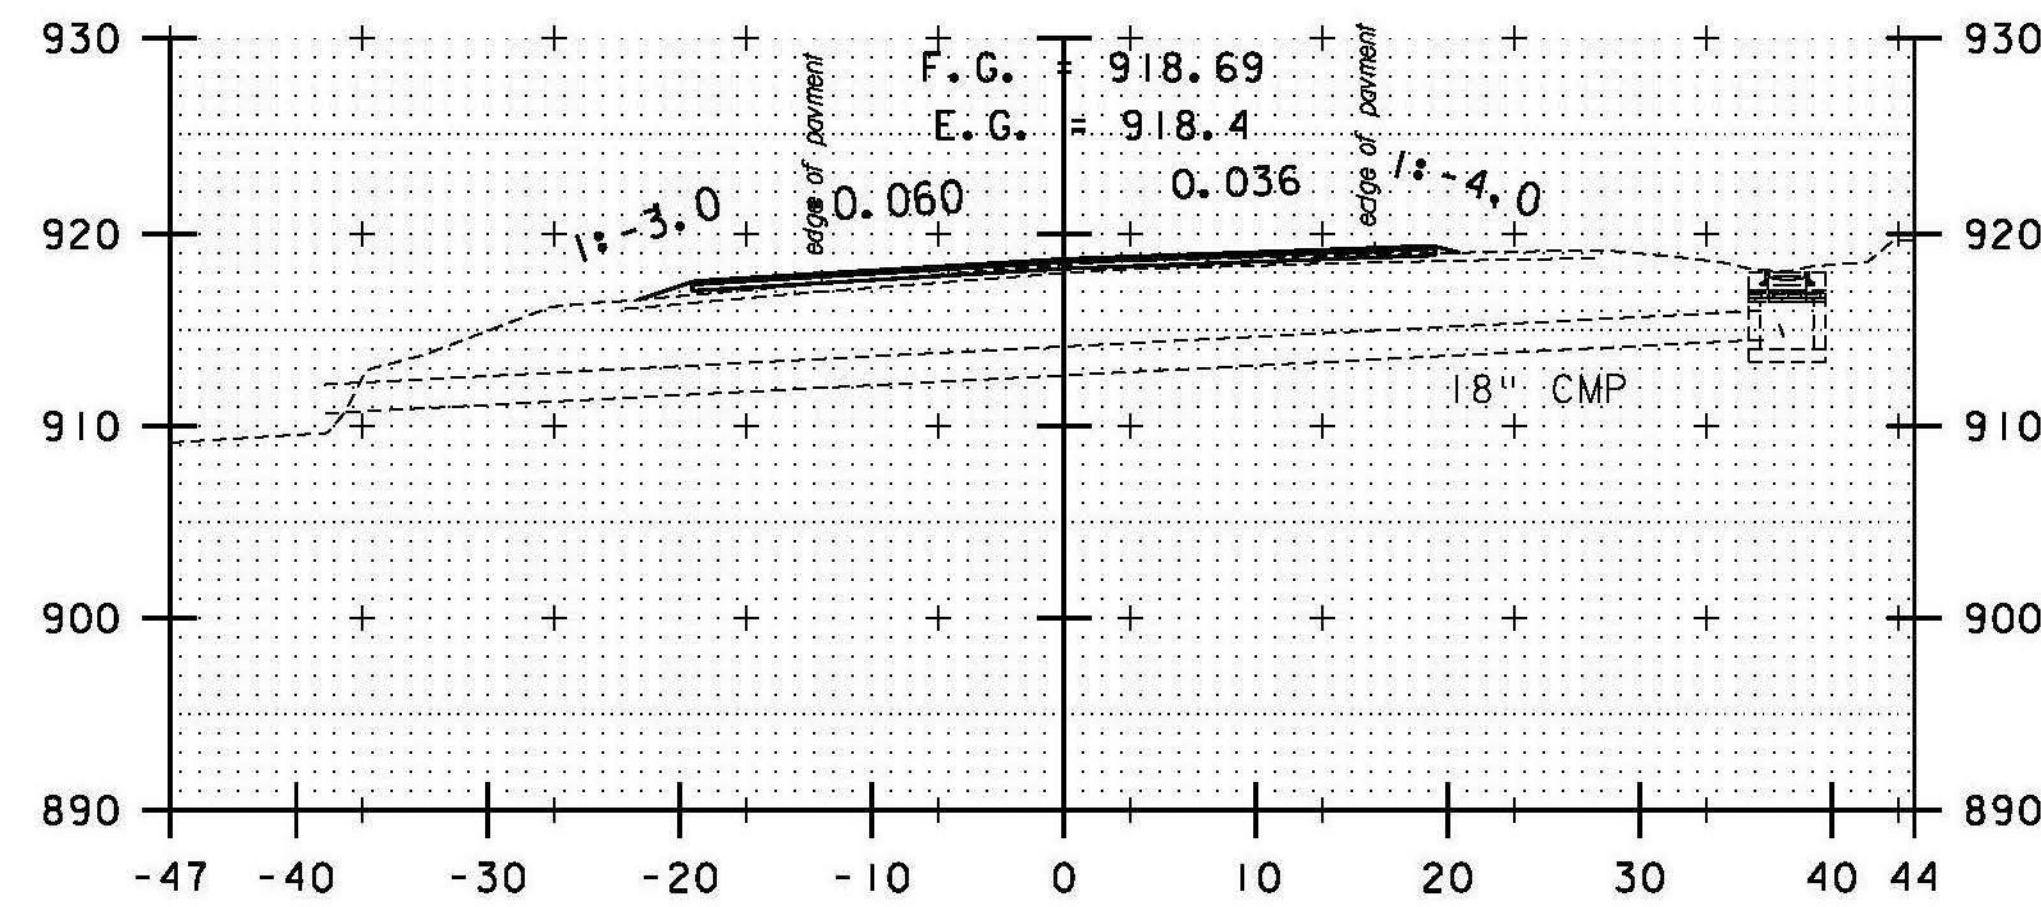


SKEWED
100+75

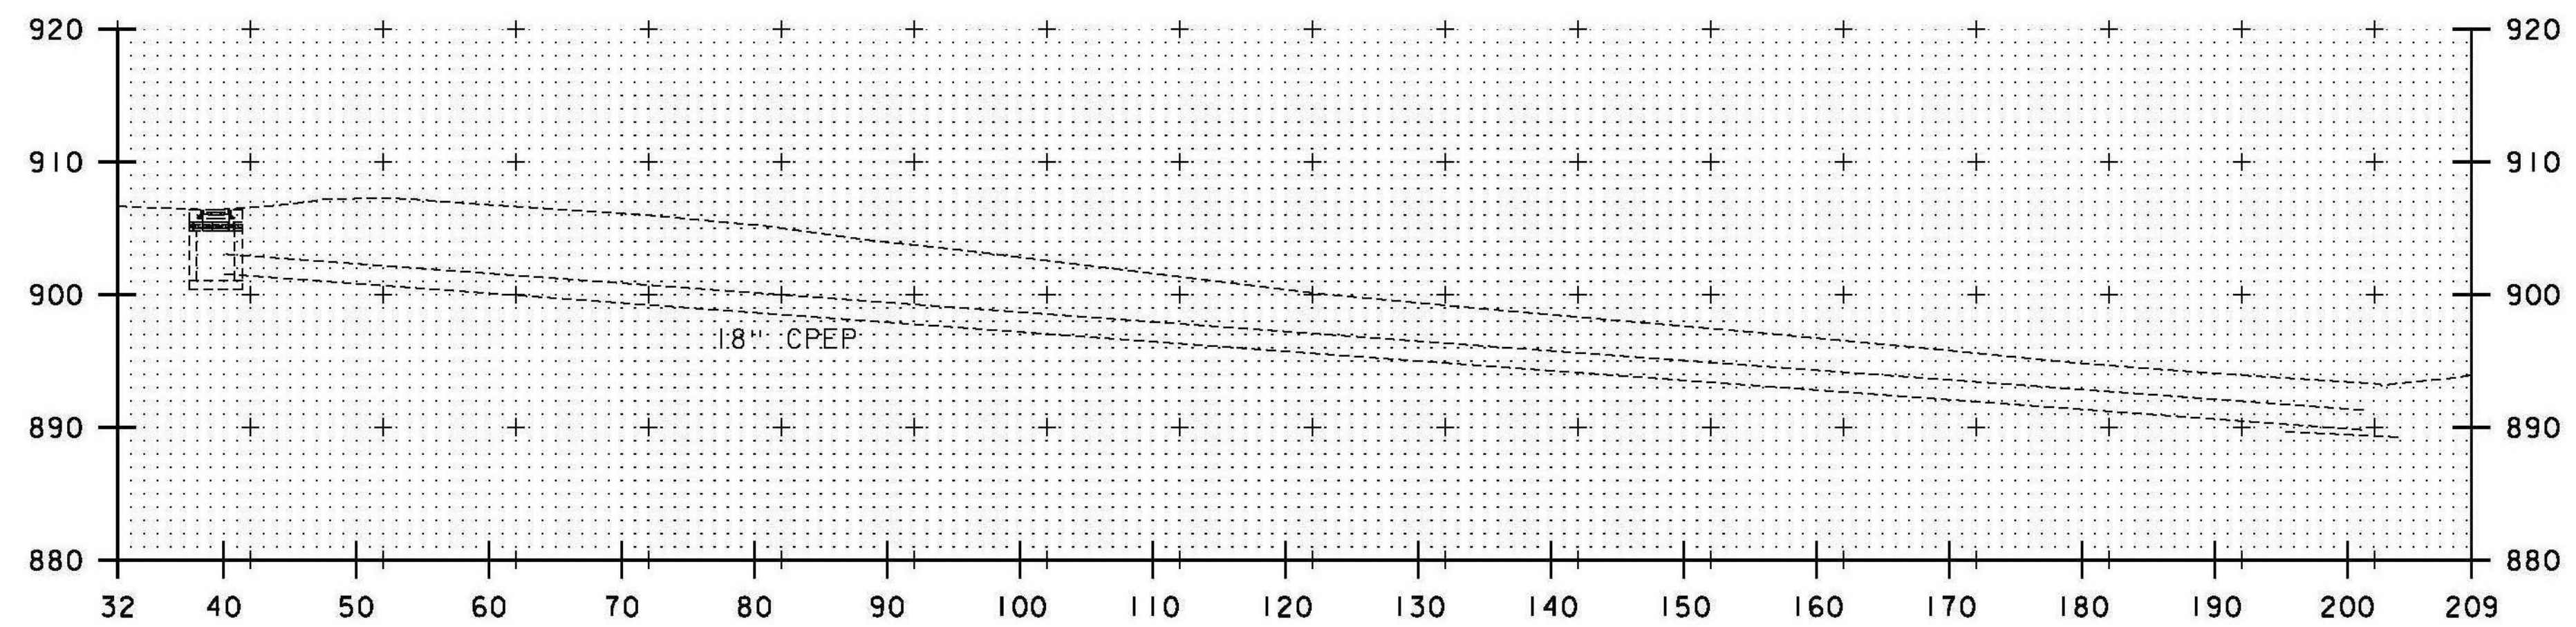

99+69 RT

DATUM
VERTICAL NAVD 88
HORIZONTAL NAD 83

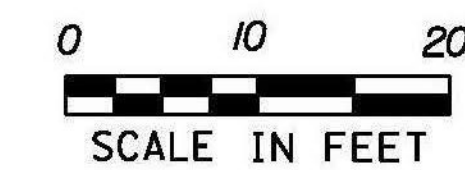

STA. 99+69 TO STA. 102+79

PROJECT NAME: RANDOLPH
PROJECT NUMBER: STP 2932 (1)

FILE NAME: z10c270.dgn
PROJECT LEADER: C. LATHROP
DESIGNED BY: B. BRESLEND
CULVERT CROSS SECTION SHEET 6

PLOT DATE: 6/5/2014
DRAWN BY: B. BRESLEND
CHECKED BY: C. LATHROP
SHEET 253 OF 276