



104+88 RT

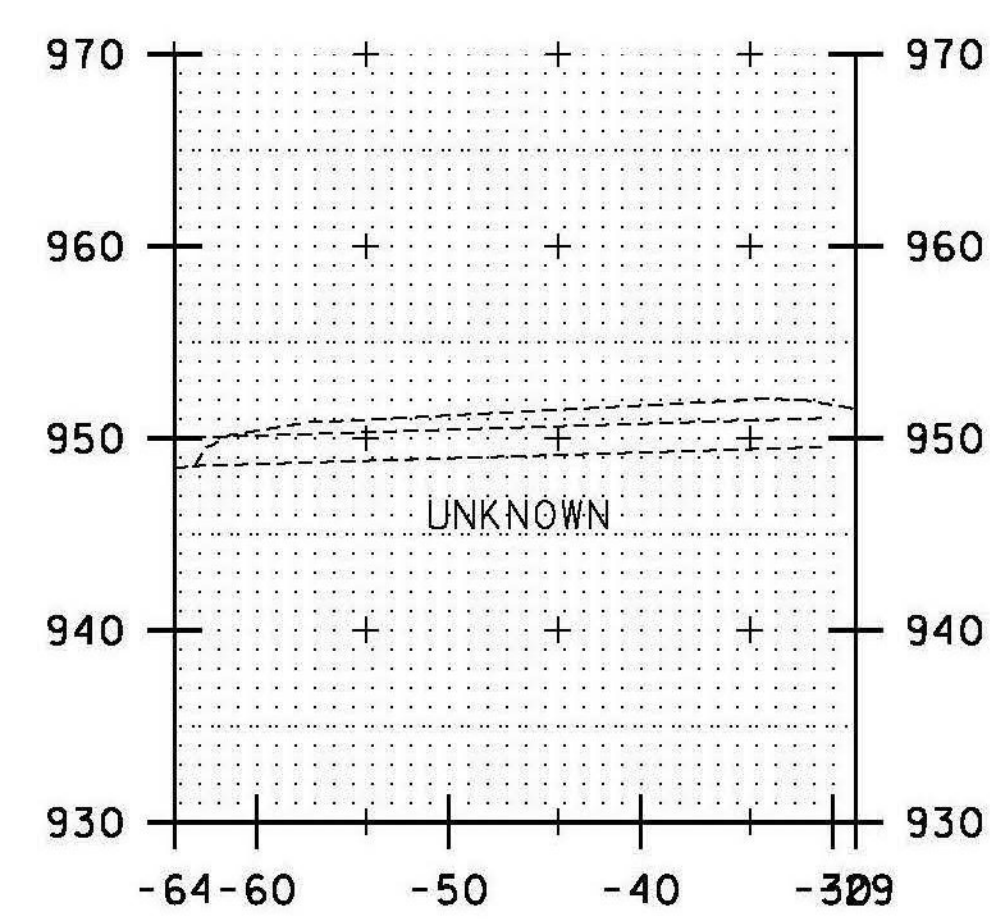

DRIVE LT
104+80

DATUM
 VERTICAL NAVD 88
 HORIZONTAL NAD 83

STA. 104+80 TO STA. 104+88

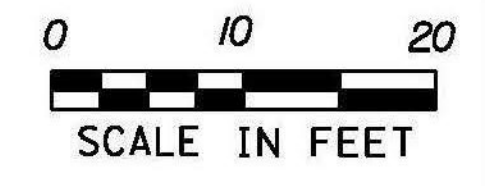

PROJECT NAME: RANDOLPH	PLOT DATE: 6/5/2014
PROJECT NUMBER: STP 2932 (1)	DRAWN BY: B. BRESLEND
FILE NAME: z10c270.dgn	CHECKED BY: C. LATHROP
PROJECT LEADER: C. LATHROP	SHEET 254 OF 276
DESIGNED BY: B. BRESLEND	CULVERT CROSS SECTION SHEET 7