



SKEWED
110+00

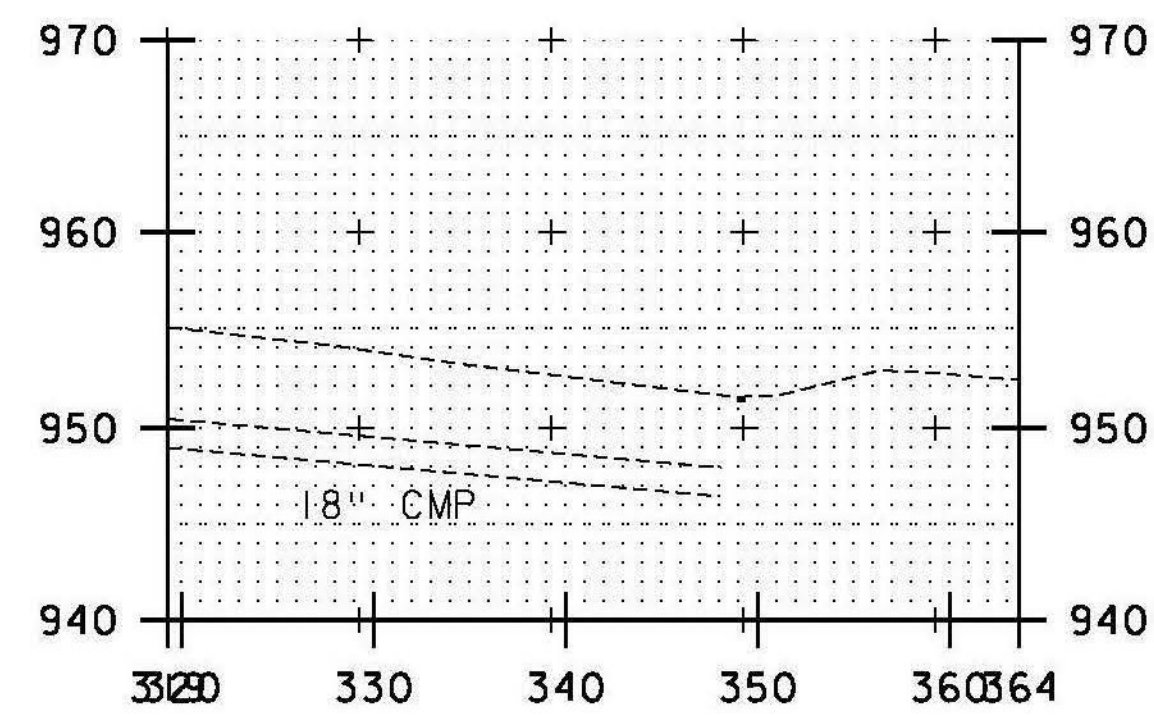


108+09 RT (+1)

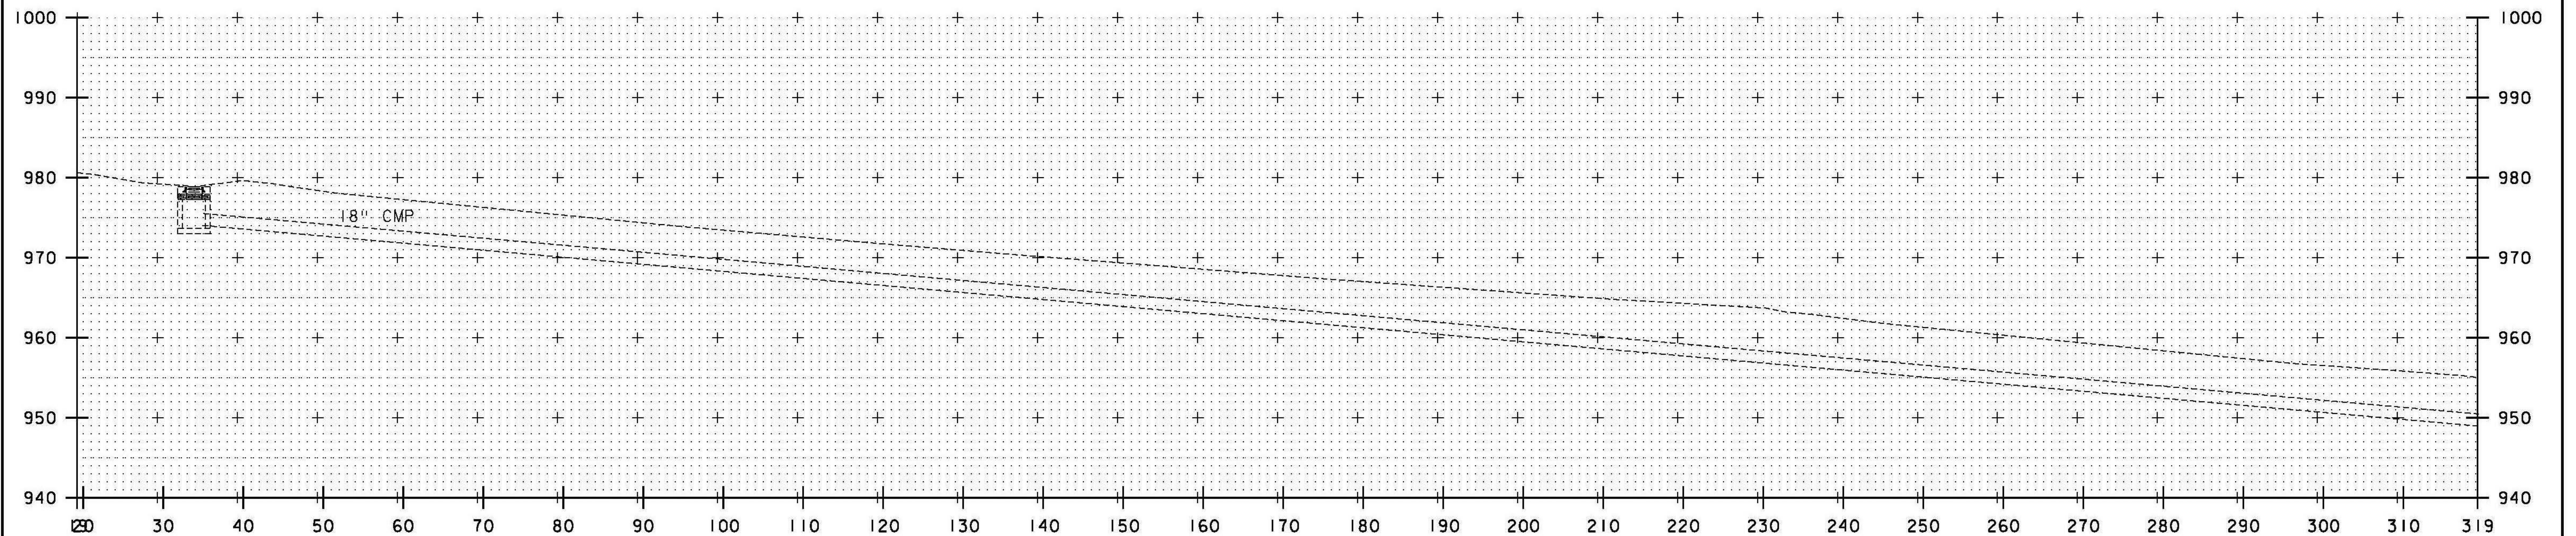

108+09 RT

DATUM
VERTICAL NAVD 88
HORIZONTAL NAD 83

STA. 108+09 TO STA. 110+00

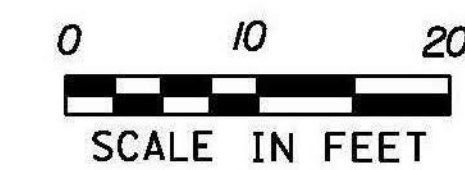

PROJECT NAME: RANDOLPH	PLOT DATE: 6/5/2014
PROJECT NUMBER: STP 2932 (1)	DRAWN BY: B. BRESLEND
FILE NAME: z10c270.dgn	CHECKED BY: C. LATHROP
PROJECT LEADER: C. LATHROP	SHEET 255 OF 276
DESIGNED BY: B. BRESLEND	
CULVERT CROSS SECTION SHEET 8	