



112+63 RT

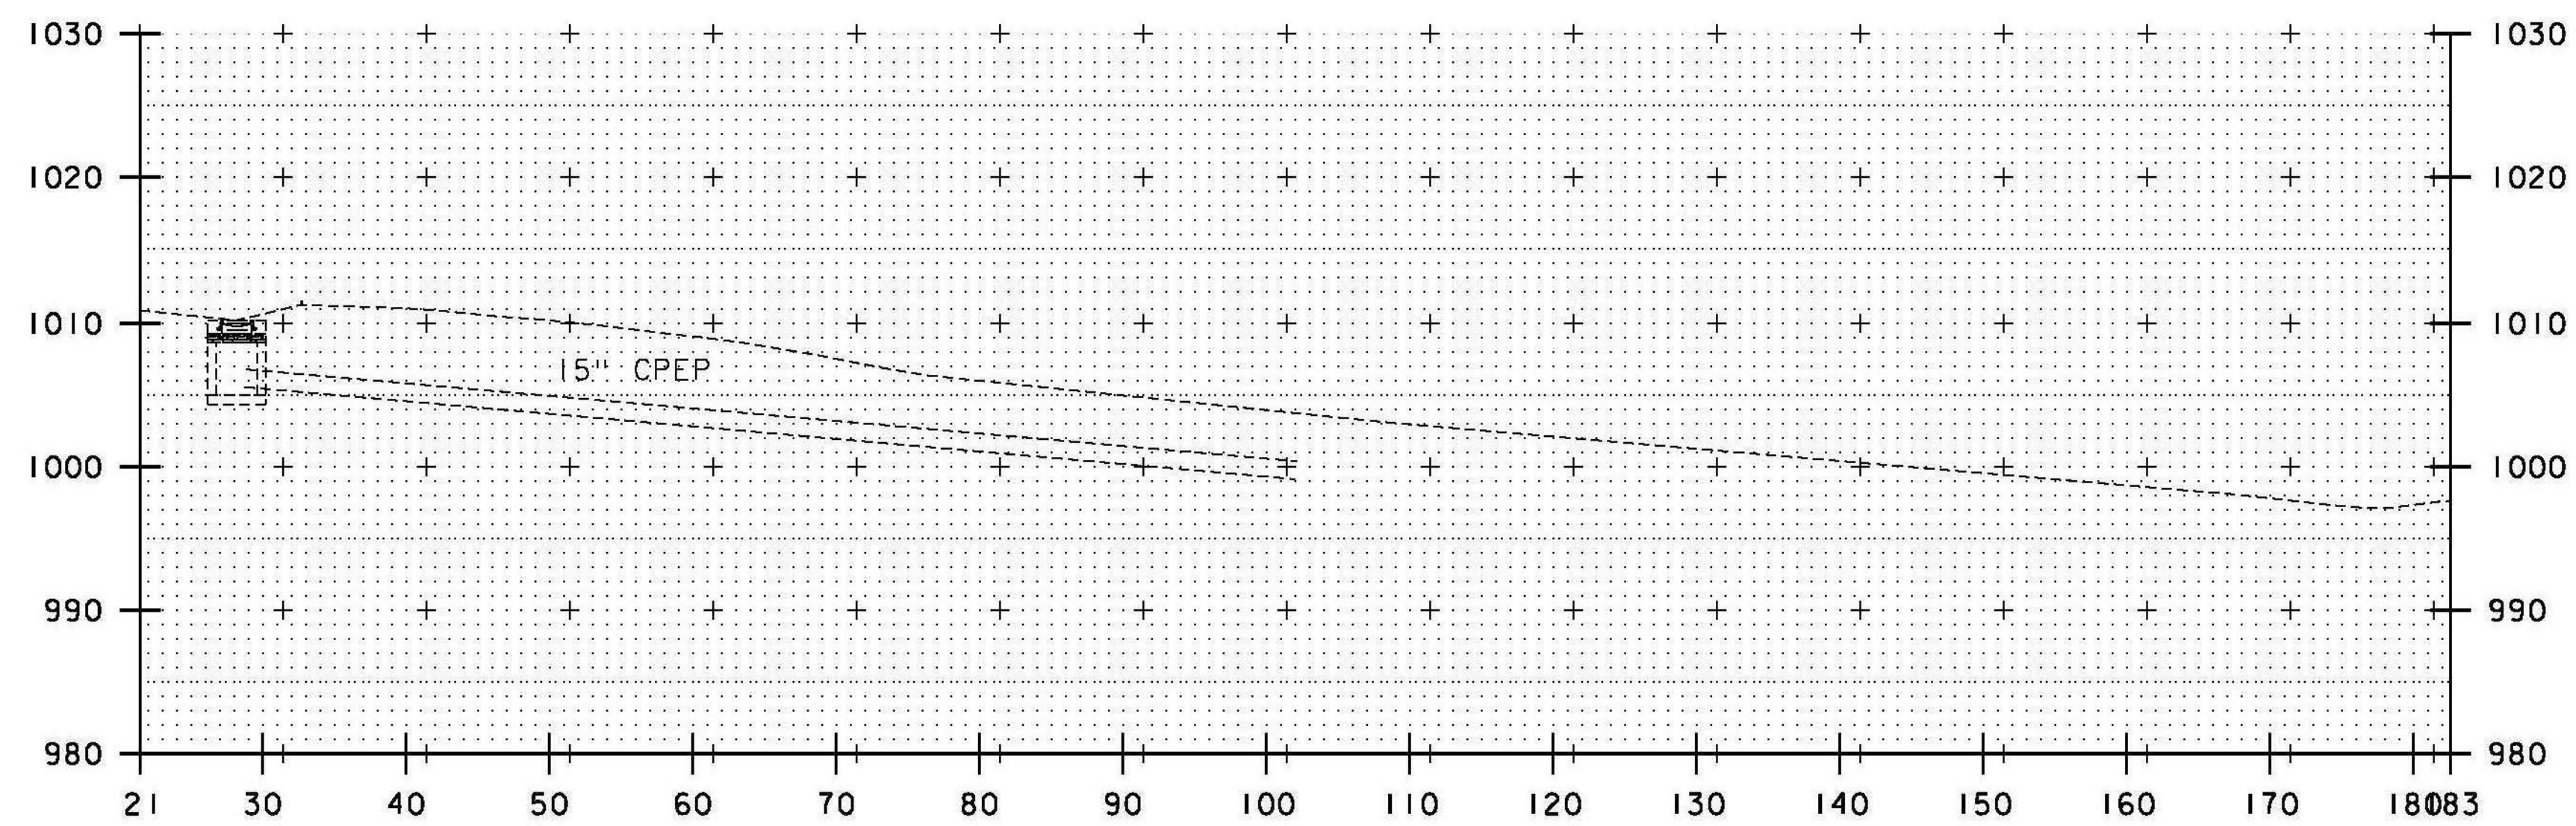


111+66 RT

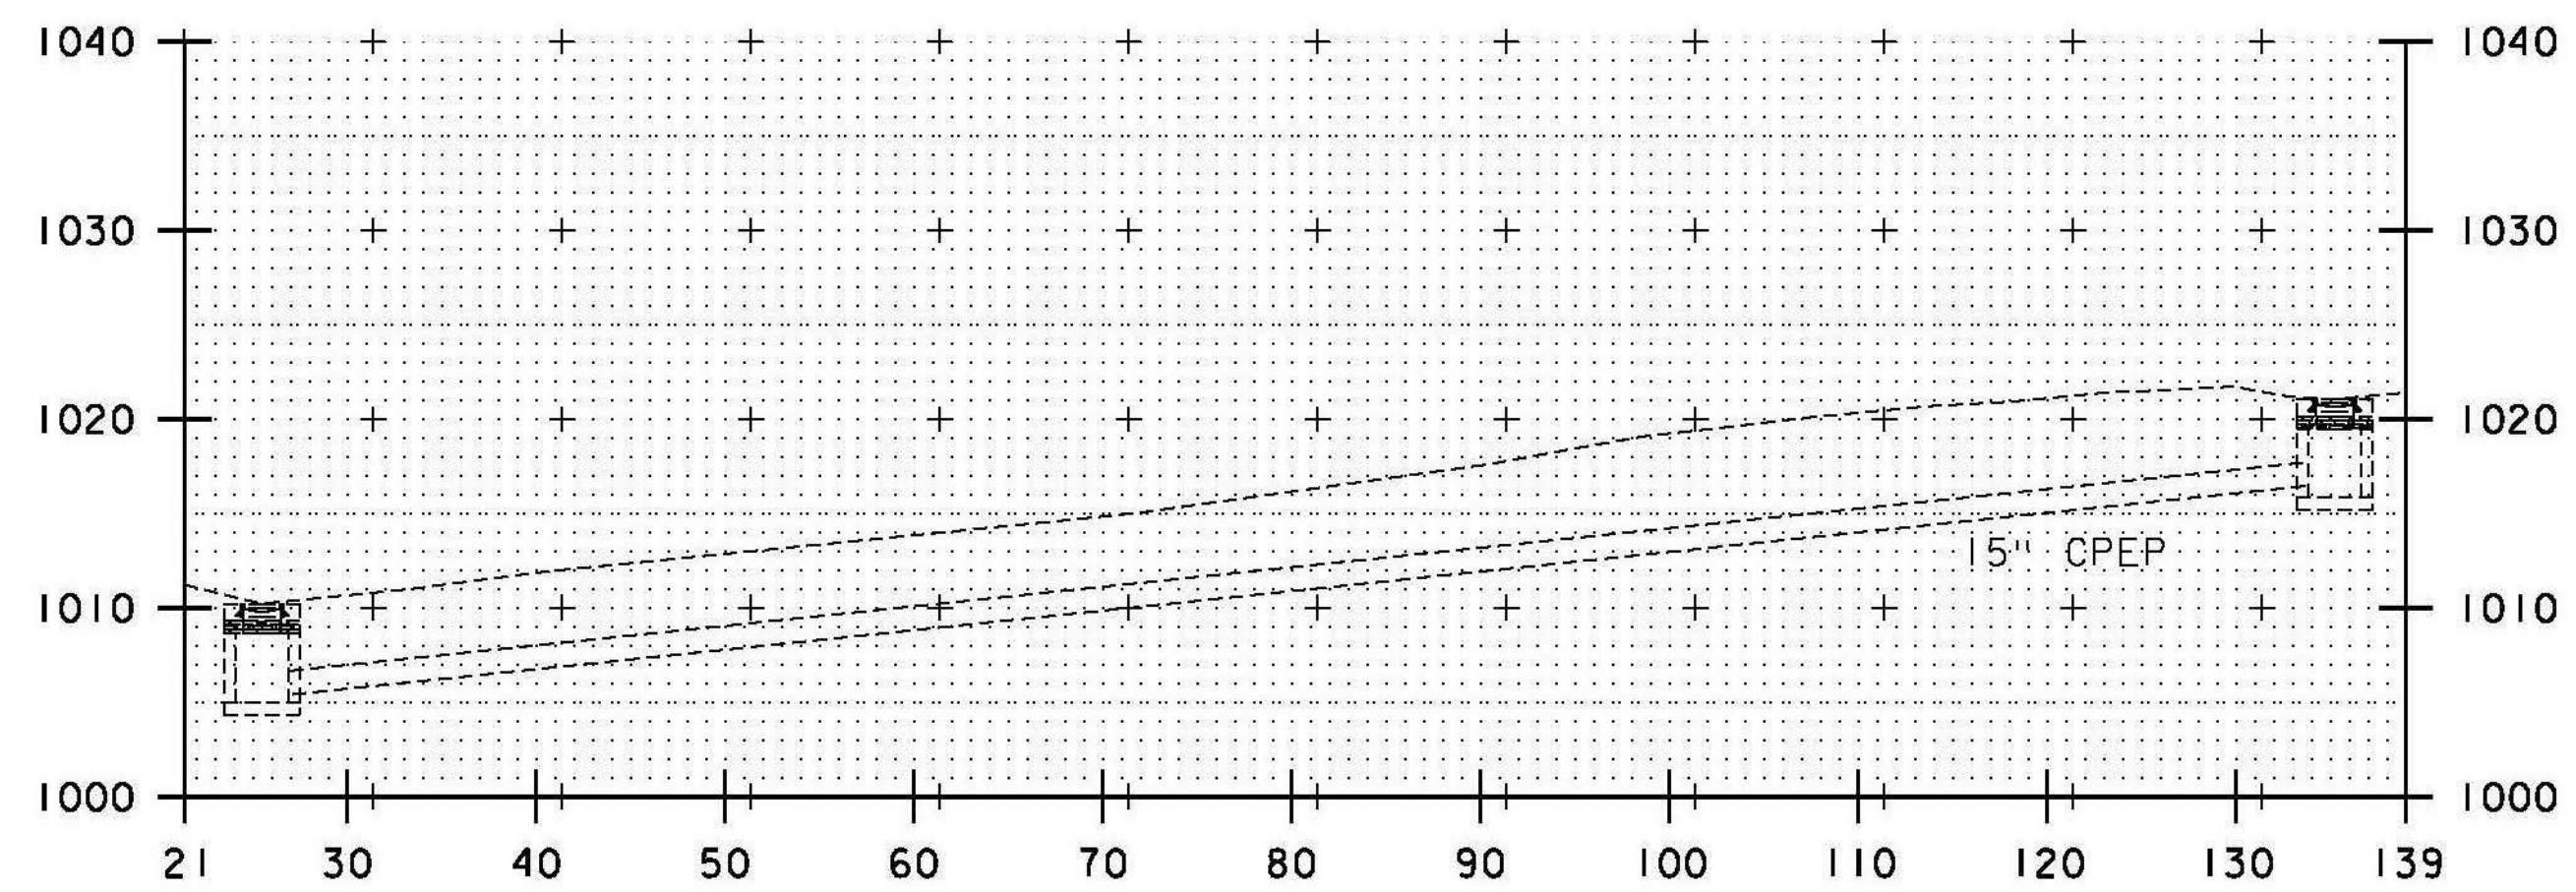

111+55 RT

DATUM  
 VERTICAL NAVD 88  
 HORIZONTAL NAD 83

STA. 111+55 TO STA. 112+63

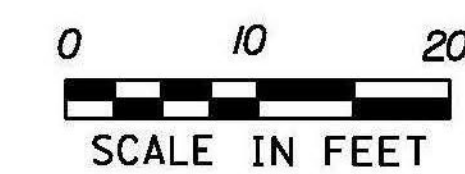

PROJECT NAME: RANDOLPH	PLOT DATE: 6/5/2014
PROJECT NUMBER: STP 2932 (1)	DRAWN BY: B. BRESLEND
FILE NAME: z10c270.dgn	CHECKED BY: C. LATHROP
PROJECT LEADER: C. LATHROP	SHEET 256 OF 276
DESIGNED BY: B. BRESLEND	CULVERT CROSS SECTION SHEET 9