




DRIVE LT
119+84

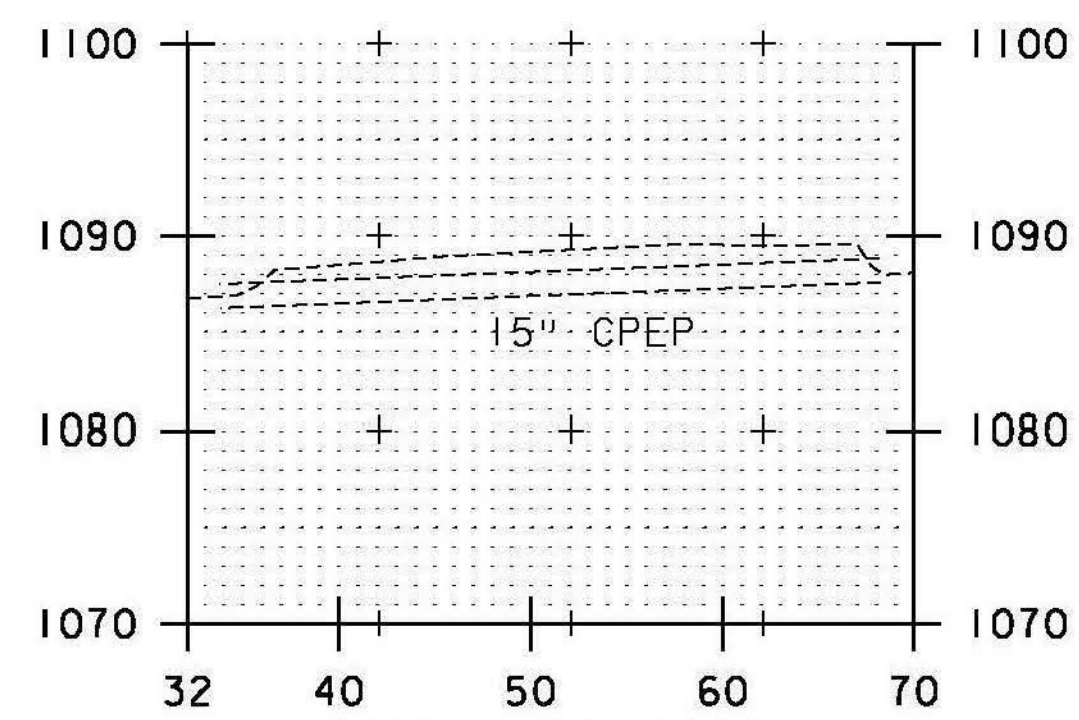

DRIVE RT
119+34

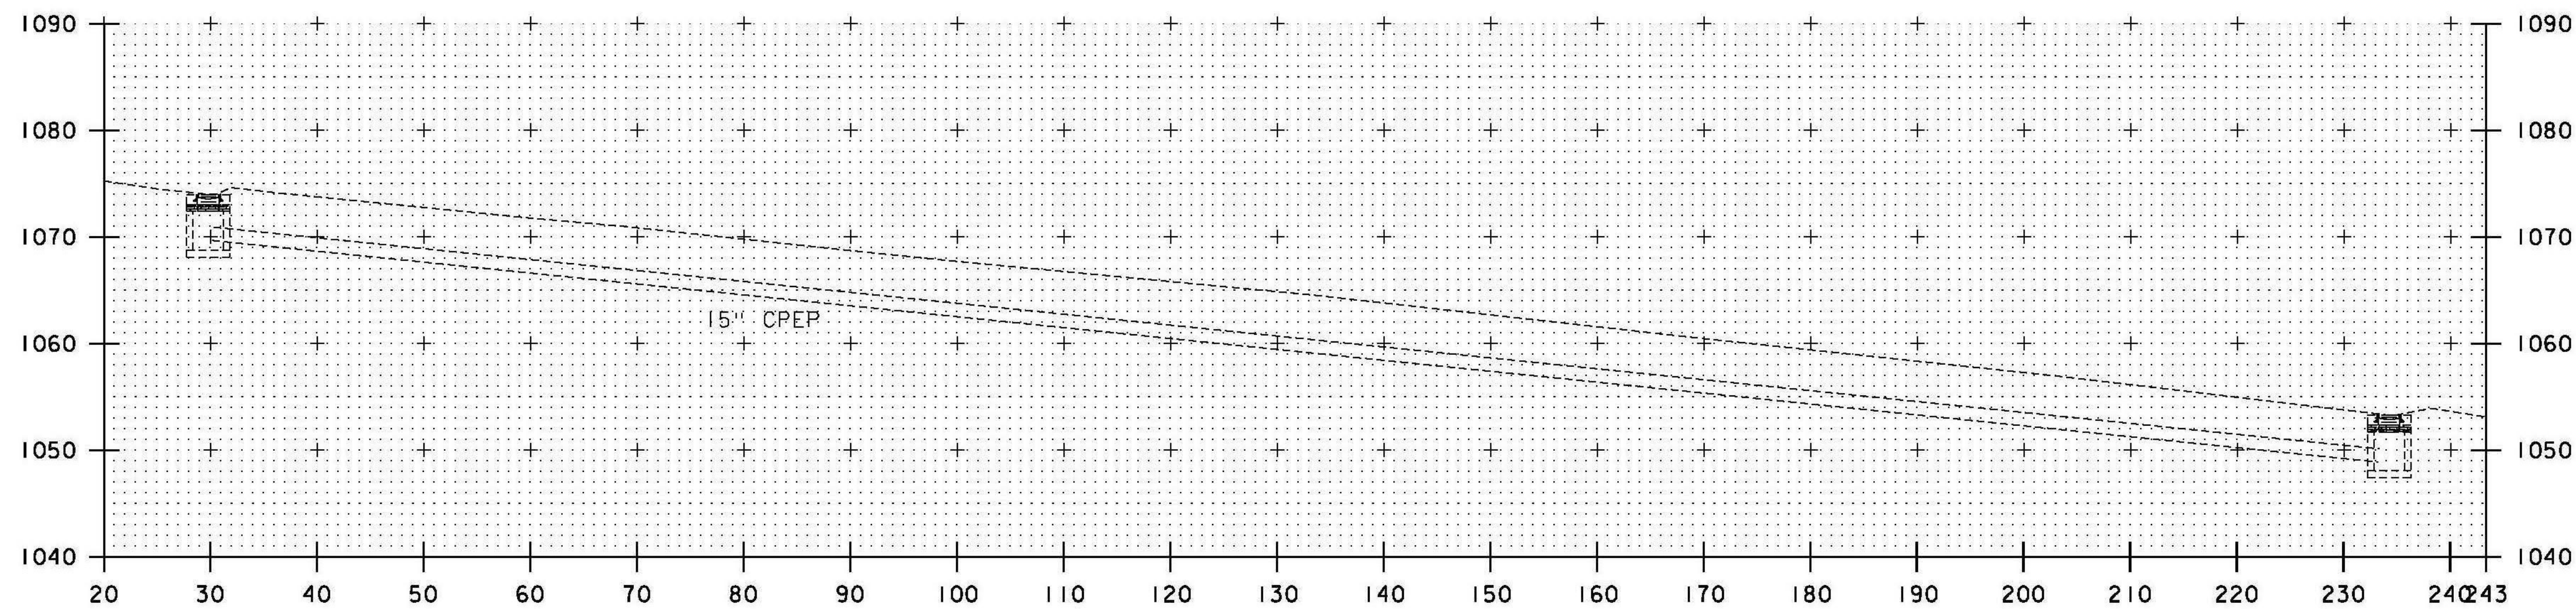


118+03 RT

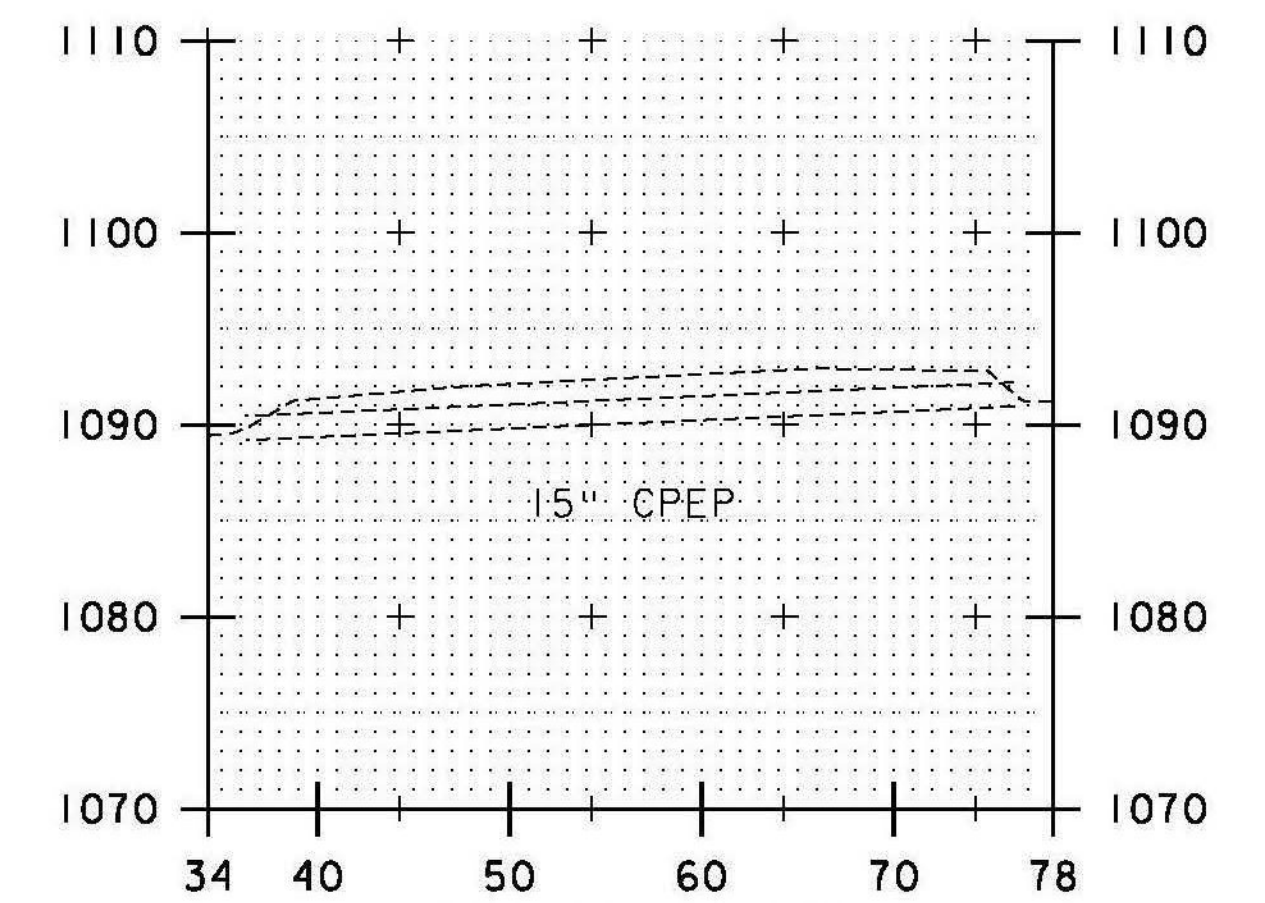

DRIVE RT
119+92

DATUM
VERTICAL NAVD 88
HORIZONTAL NAD 83

STA. 118+03 TO STA. 119+92

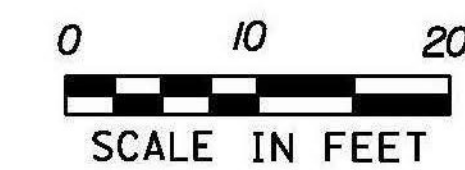

PROJECT NAME: RANDOLPH
PROJECT NUMBER: STP 2932 (1)

FILE NAME: z10c270.dgn
PROJECT LEADER: C. LATHROP
DESIGNED BY: B. BRESLEND
CULVERT CROSS SECTION SHEET 11

PLOT DATE: 6/5/2014
DRAWN BY: B. BRESLEND
CHECKED BY: C. LATHROP
SHEET 258 OF 276