




DRIVE LT  
123+59

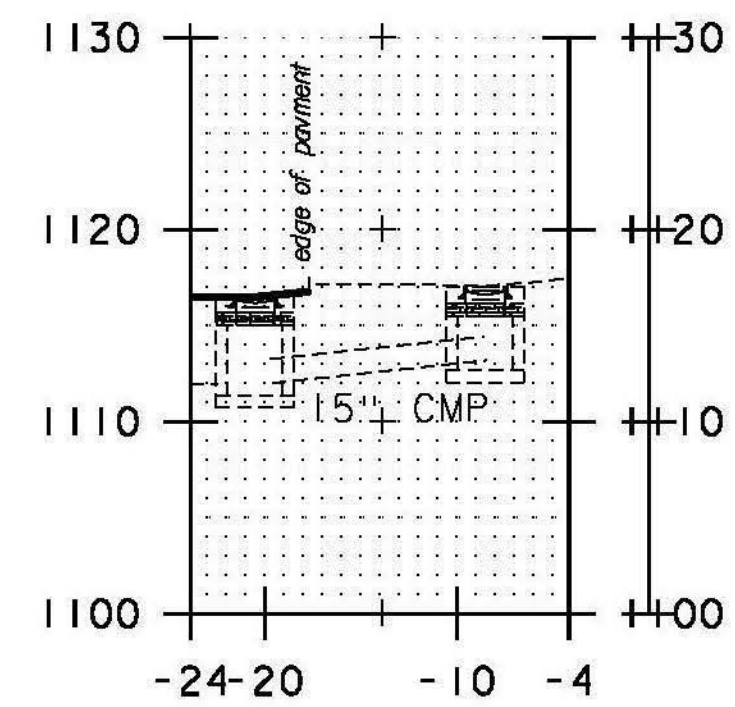


127+71

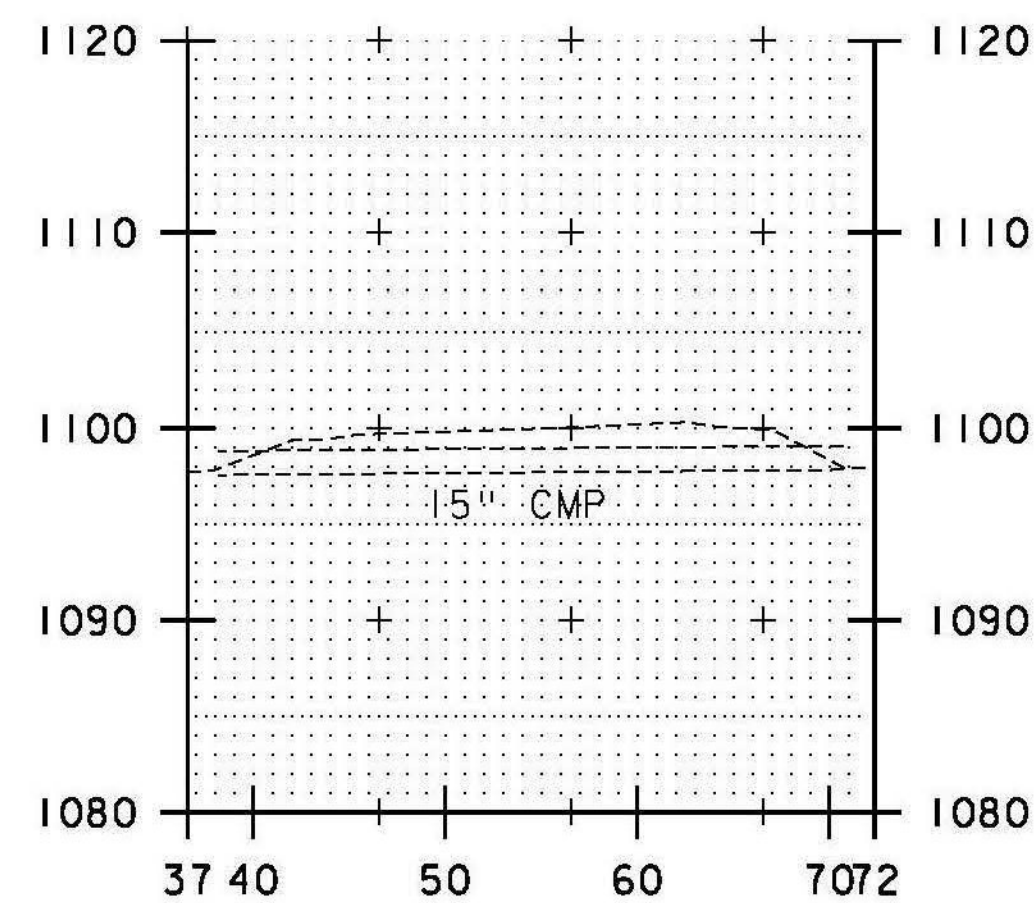


DRIVE RT  
123+37

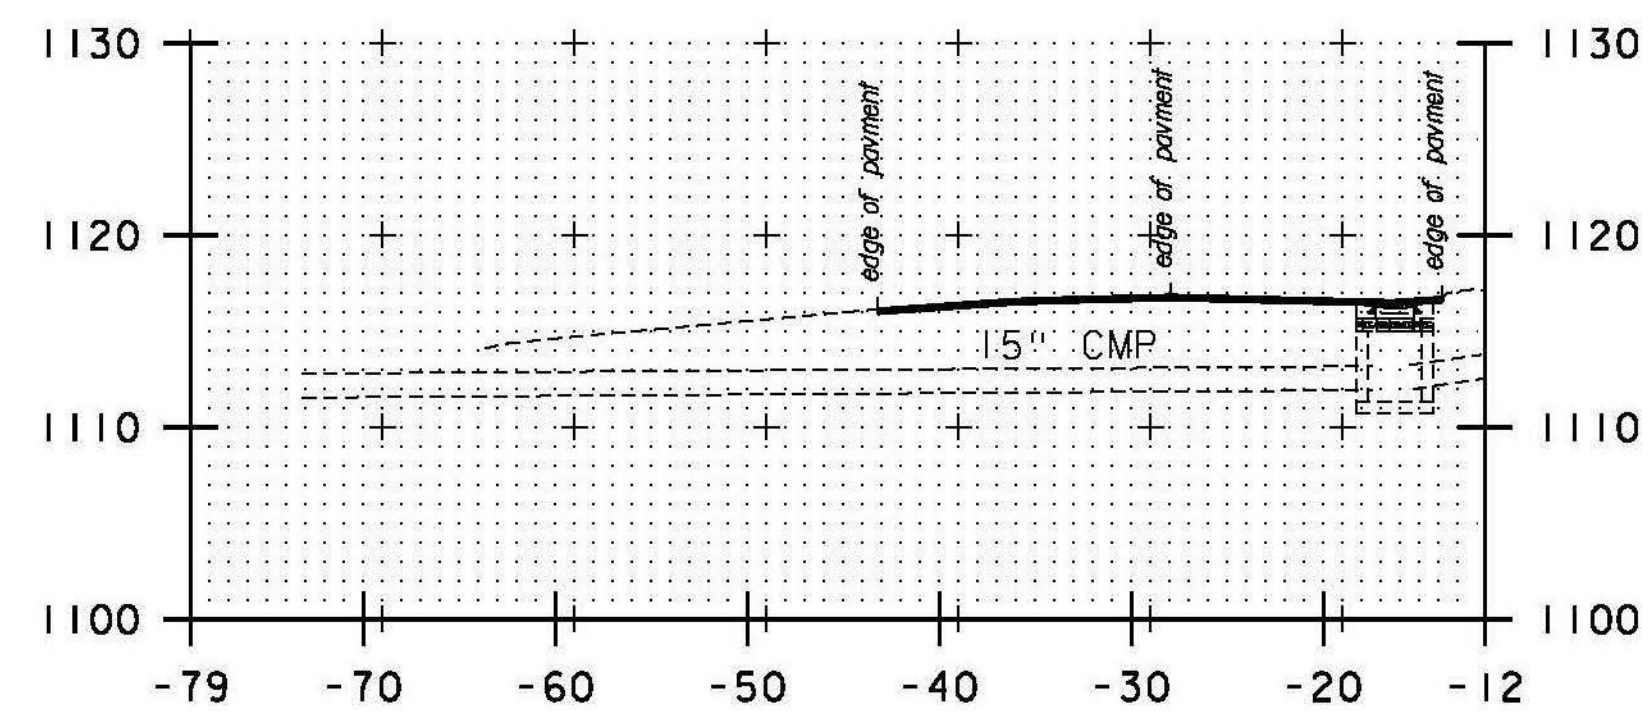


127+60

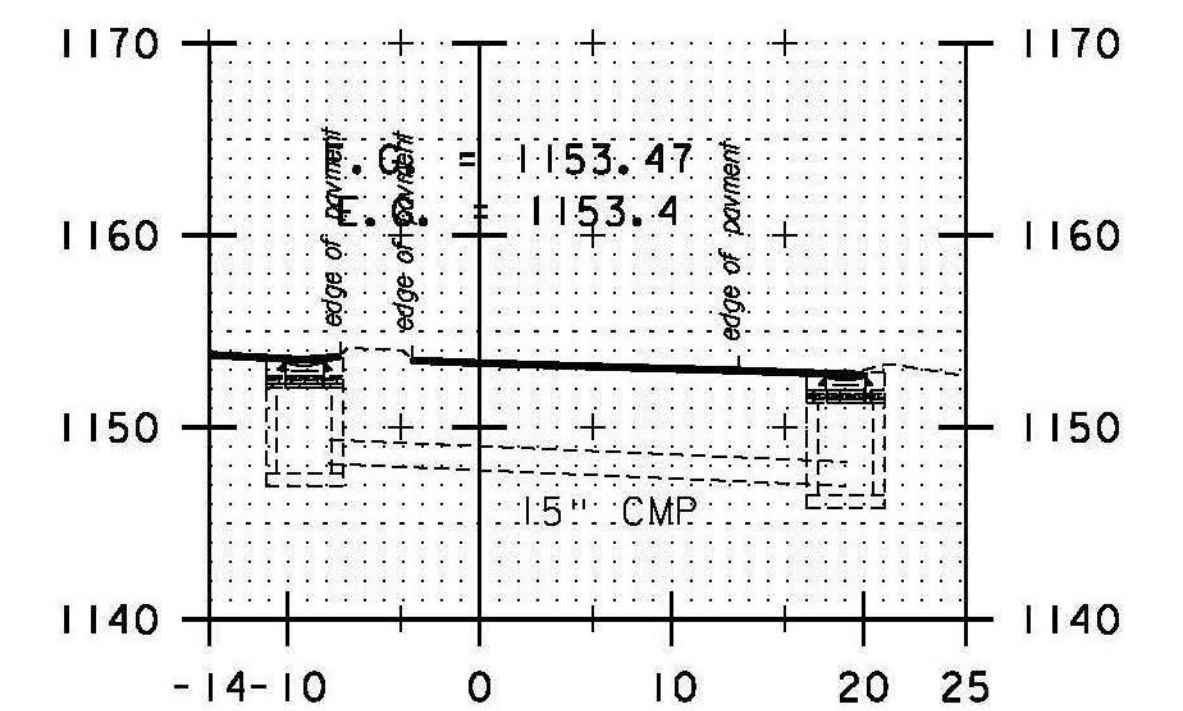


133+42

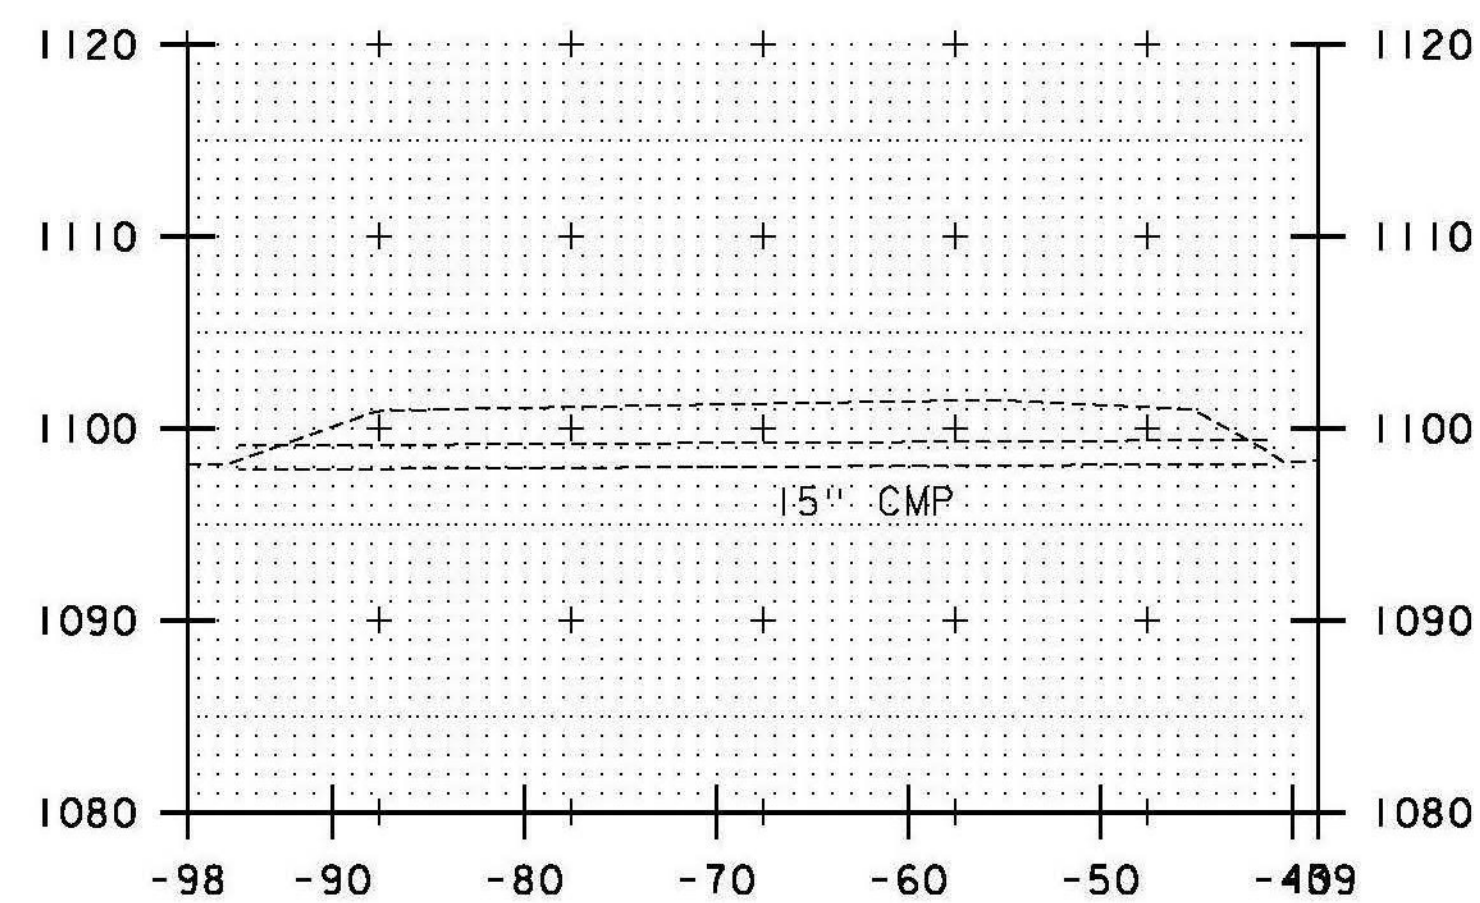

DRIVE LT  
123+26

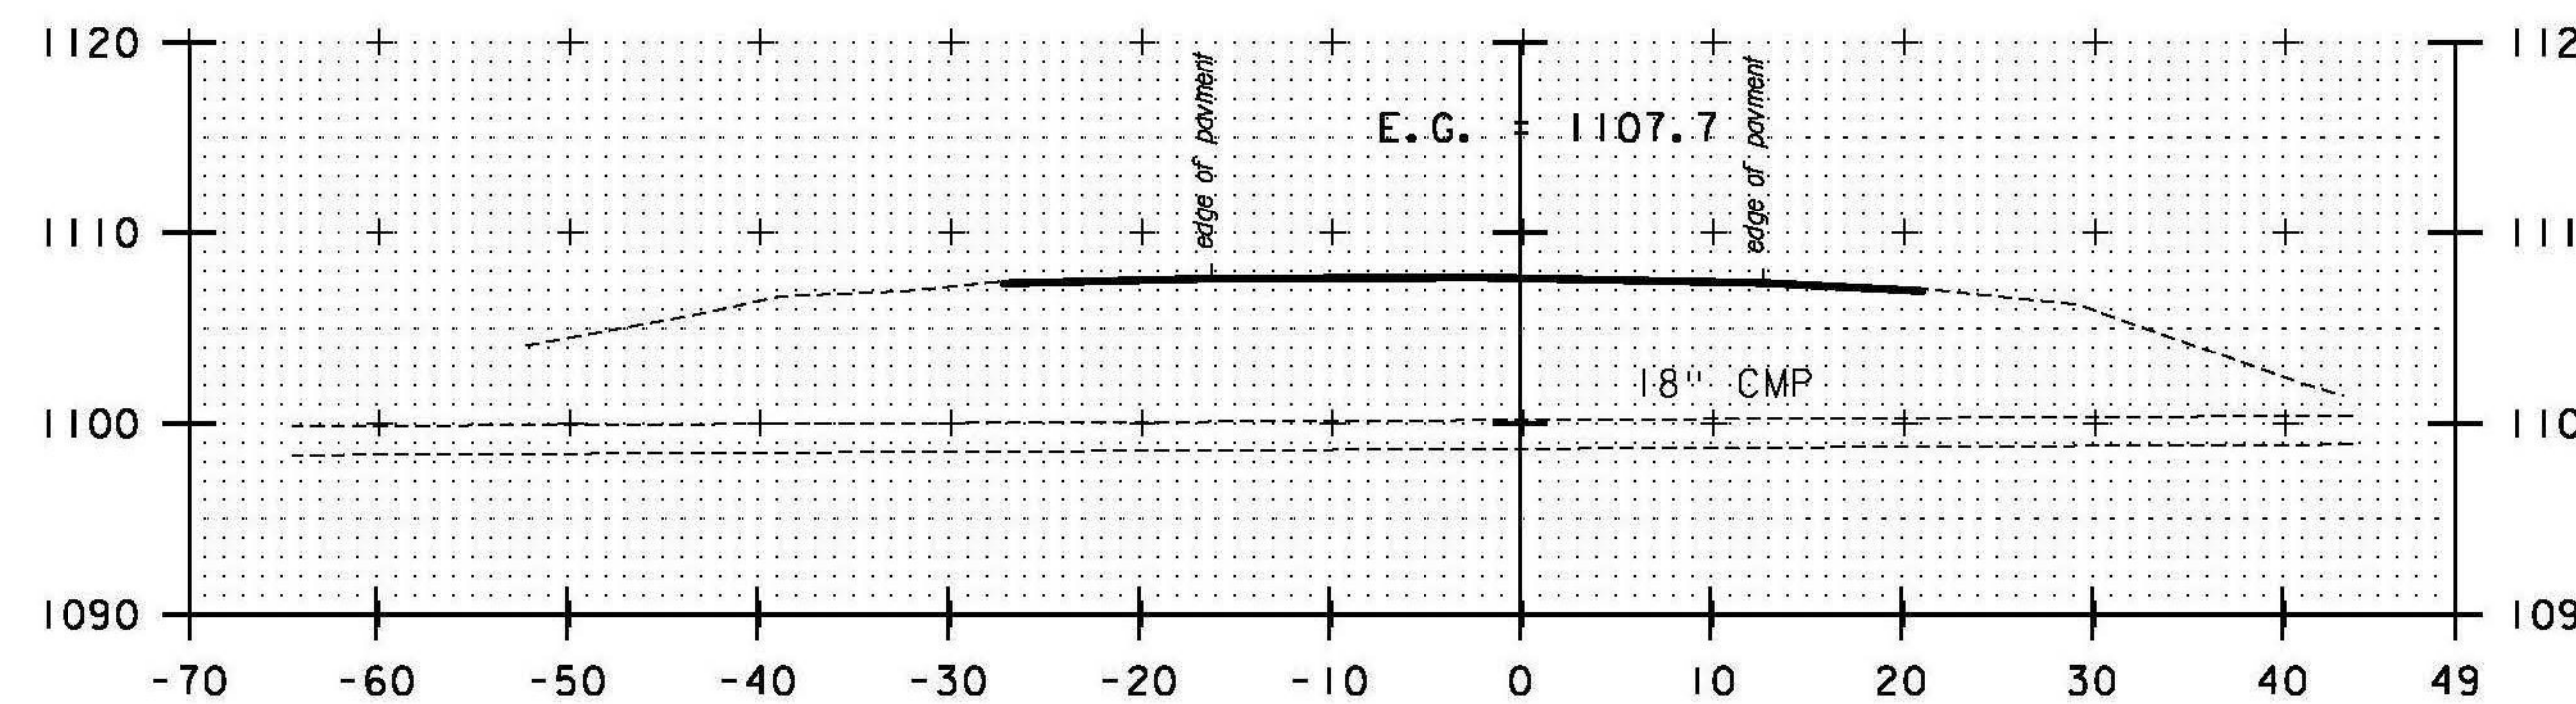


125+96

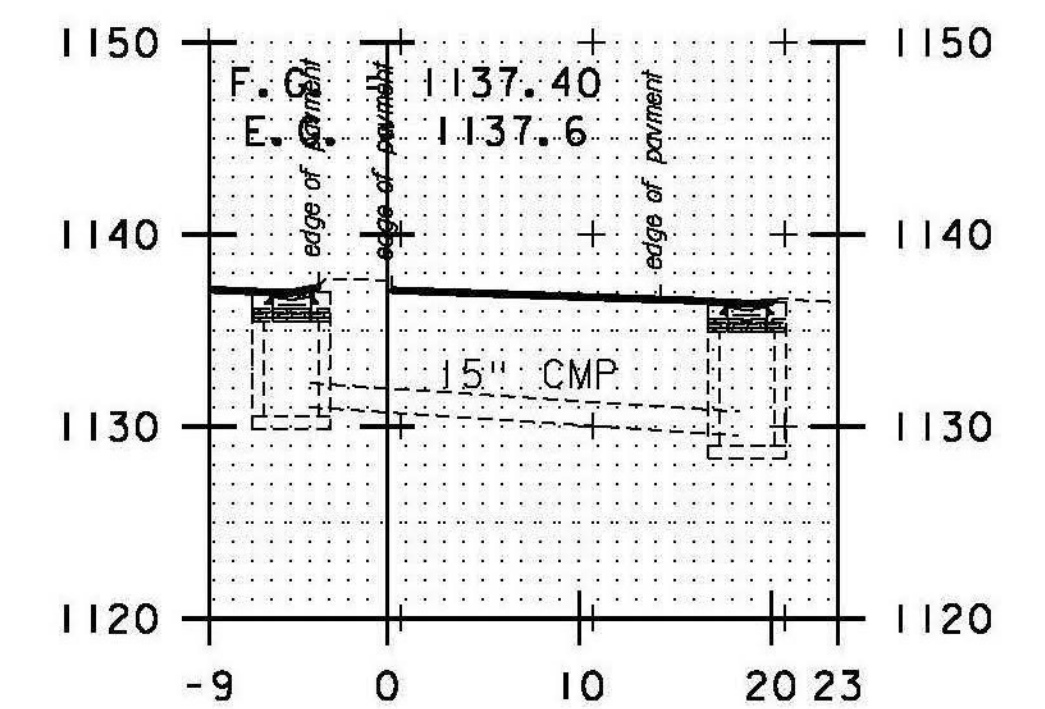

130+62

DATUM  
VERTICAL NAVD 88  
HORIZONTAL NAD 83

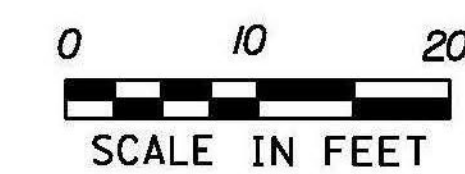

STA. 123+26 TO STA. 133+42

PROJECT NAME: RANDOLPH  
PROJECT NUMBER: STP 2932 (1)

FILE NAME: z10c270.dgn  
PROJECT LEADER: C. LATHROP  
DESIGNED BY: B. BRESLEND  
CULVERT CROSS SECTION SHEET 12

PLOT DATE: 6/5/2014  
DRAWN BY: B. BRESLEND  
CHECKED BY: C. LATHROP  
SHEET 259 OF 276