




DRIVE LT  
143+25

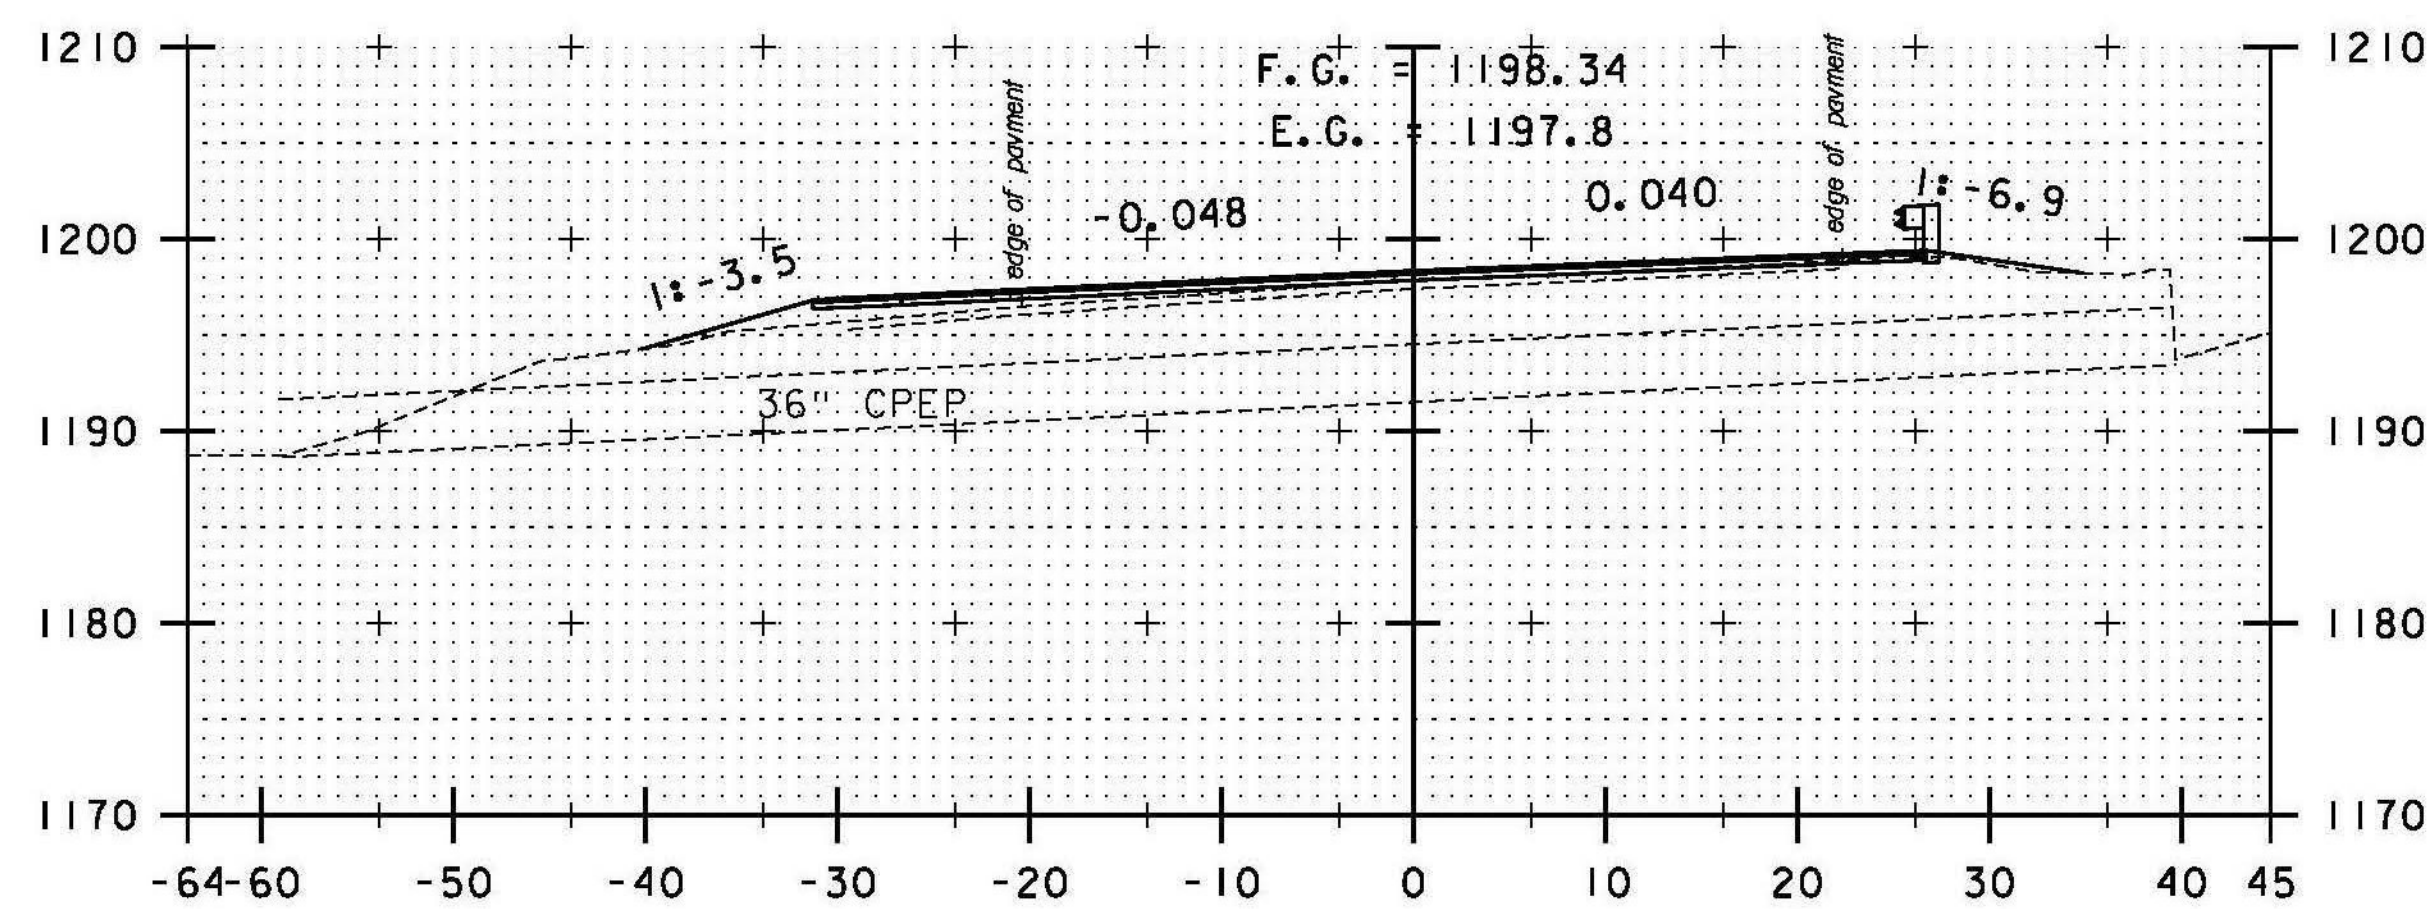


SKEWED  
141+68

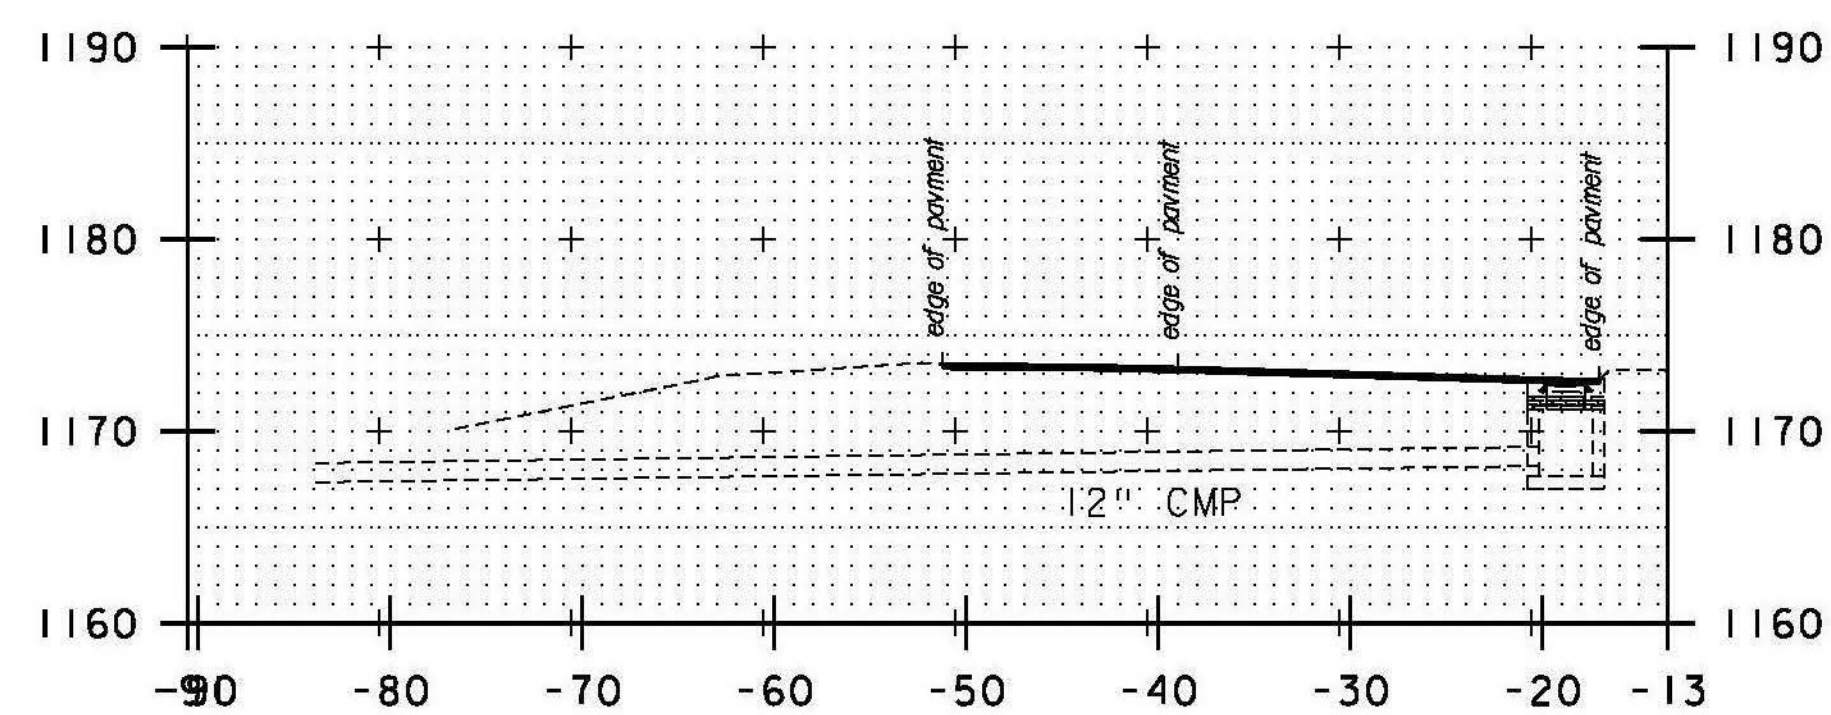


SKEWED  
137+40

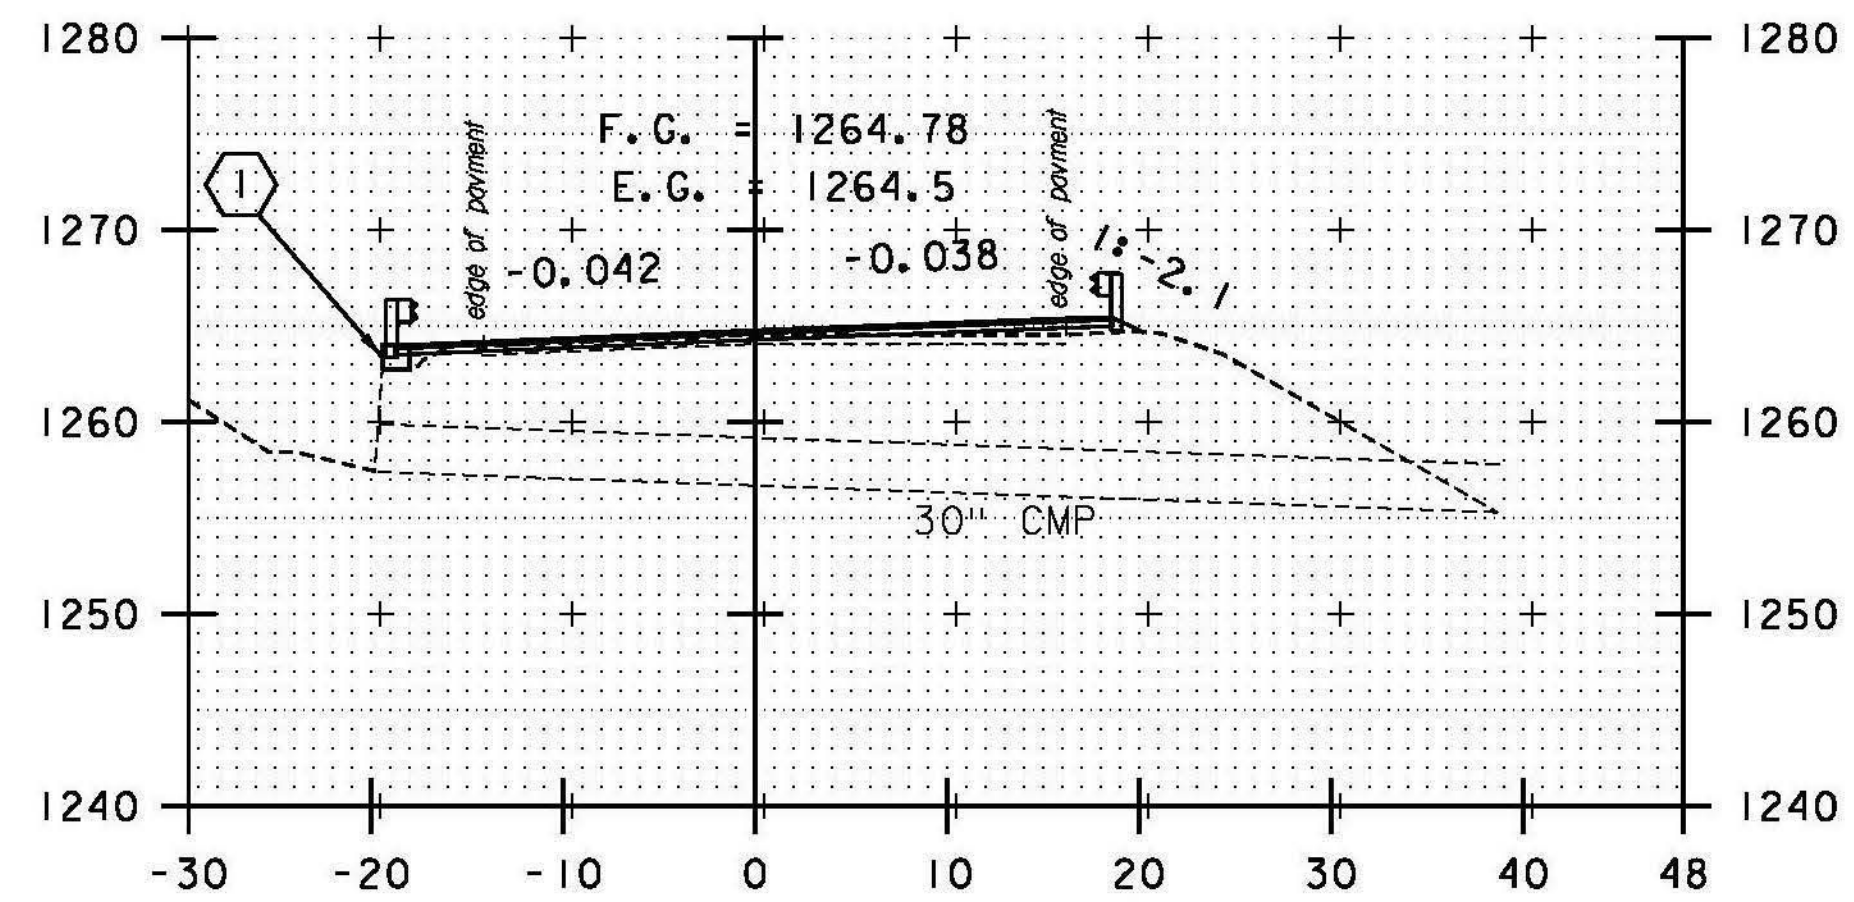

SKEWED  
149+69

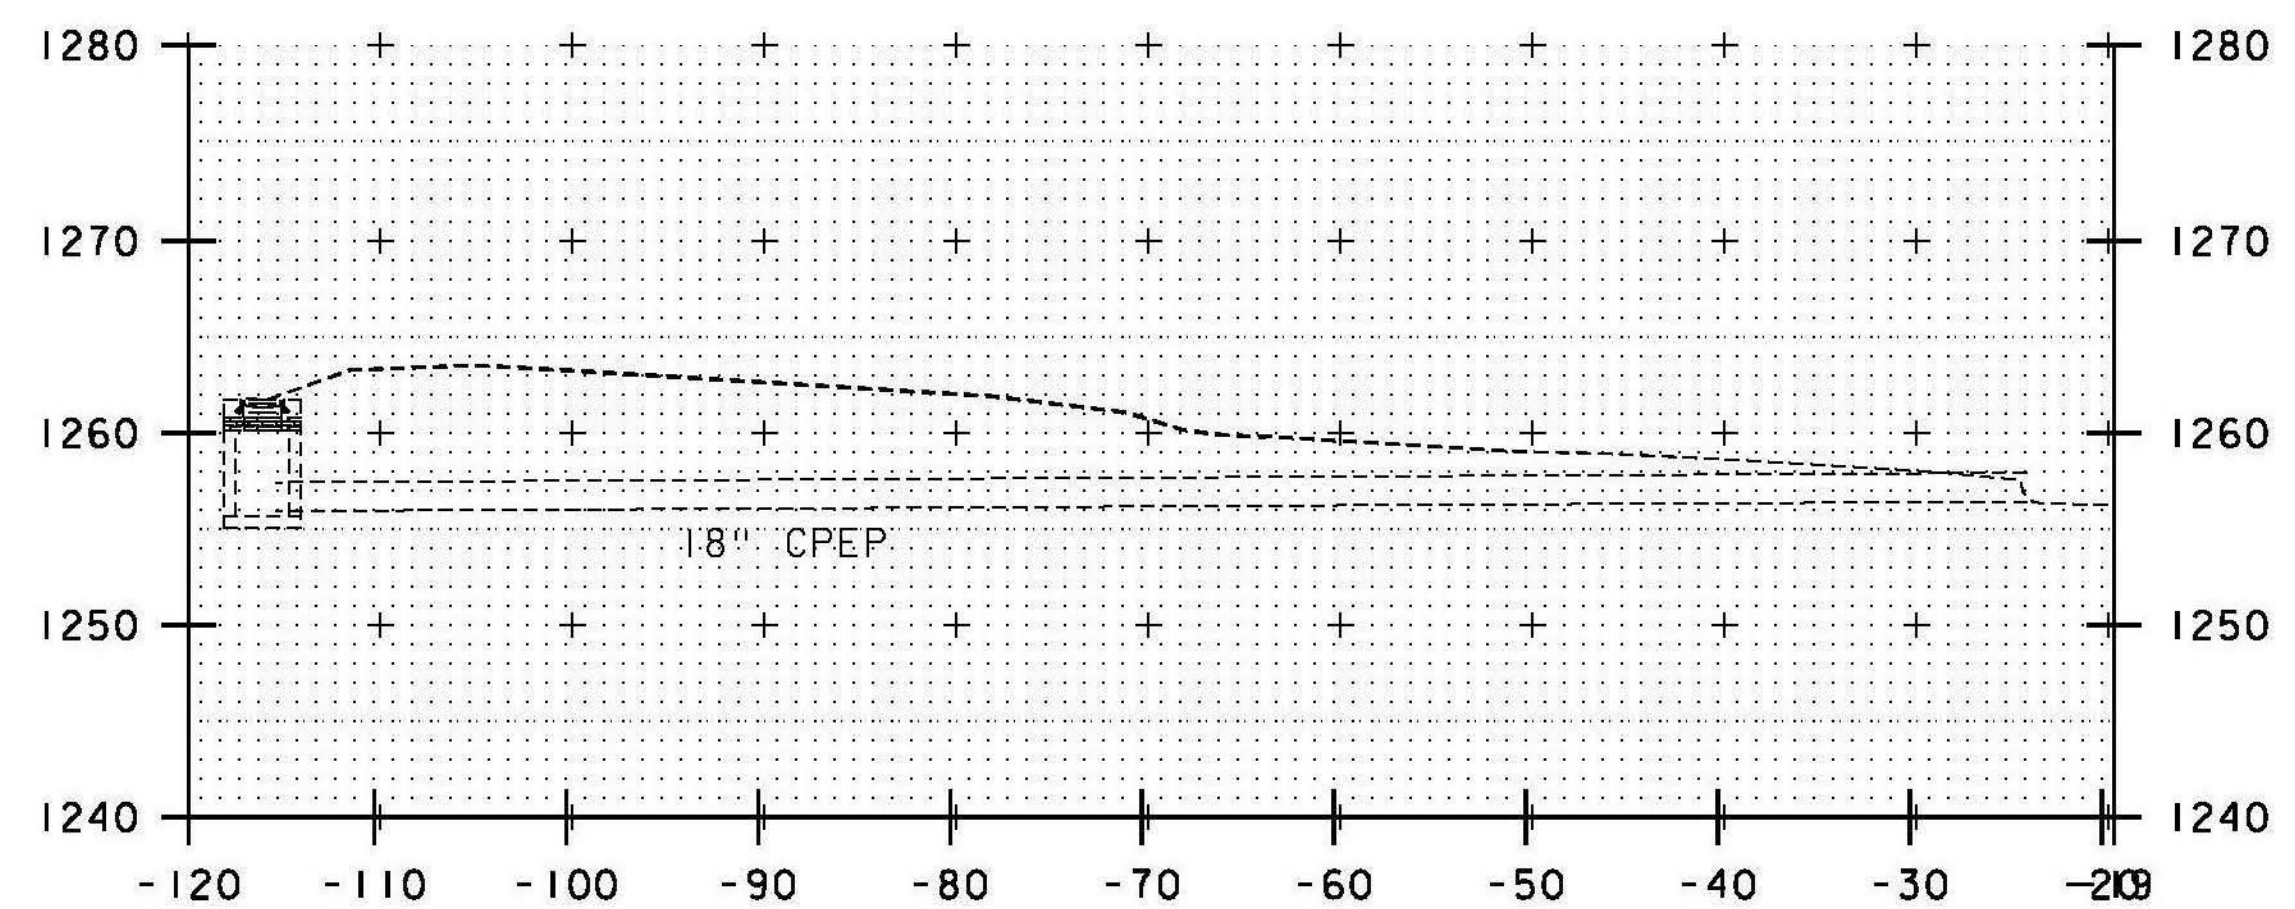

DRIVE LT  
148+57

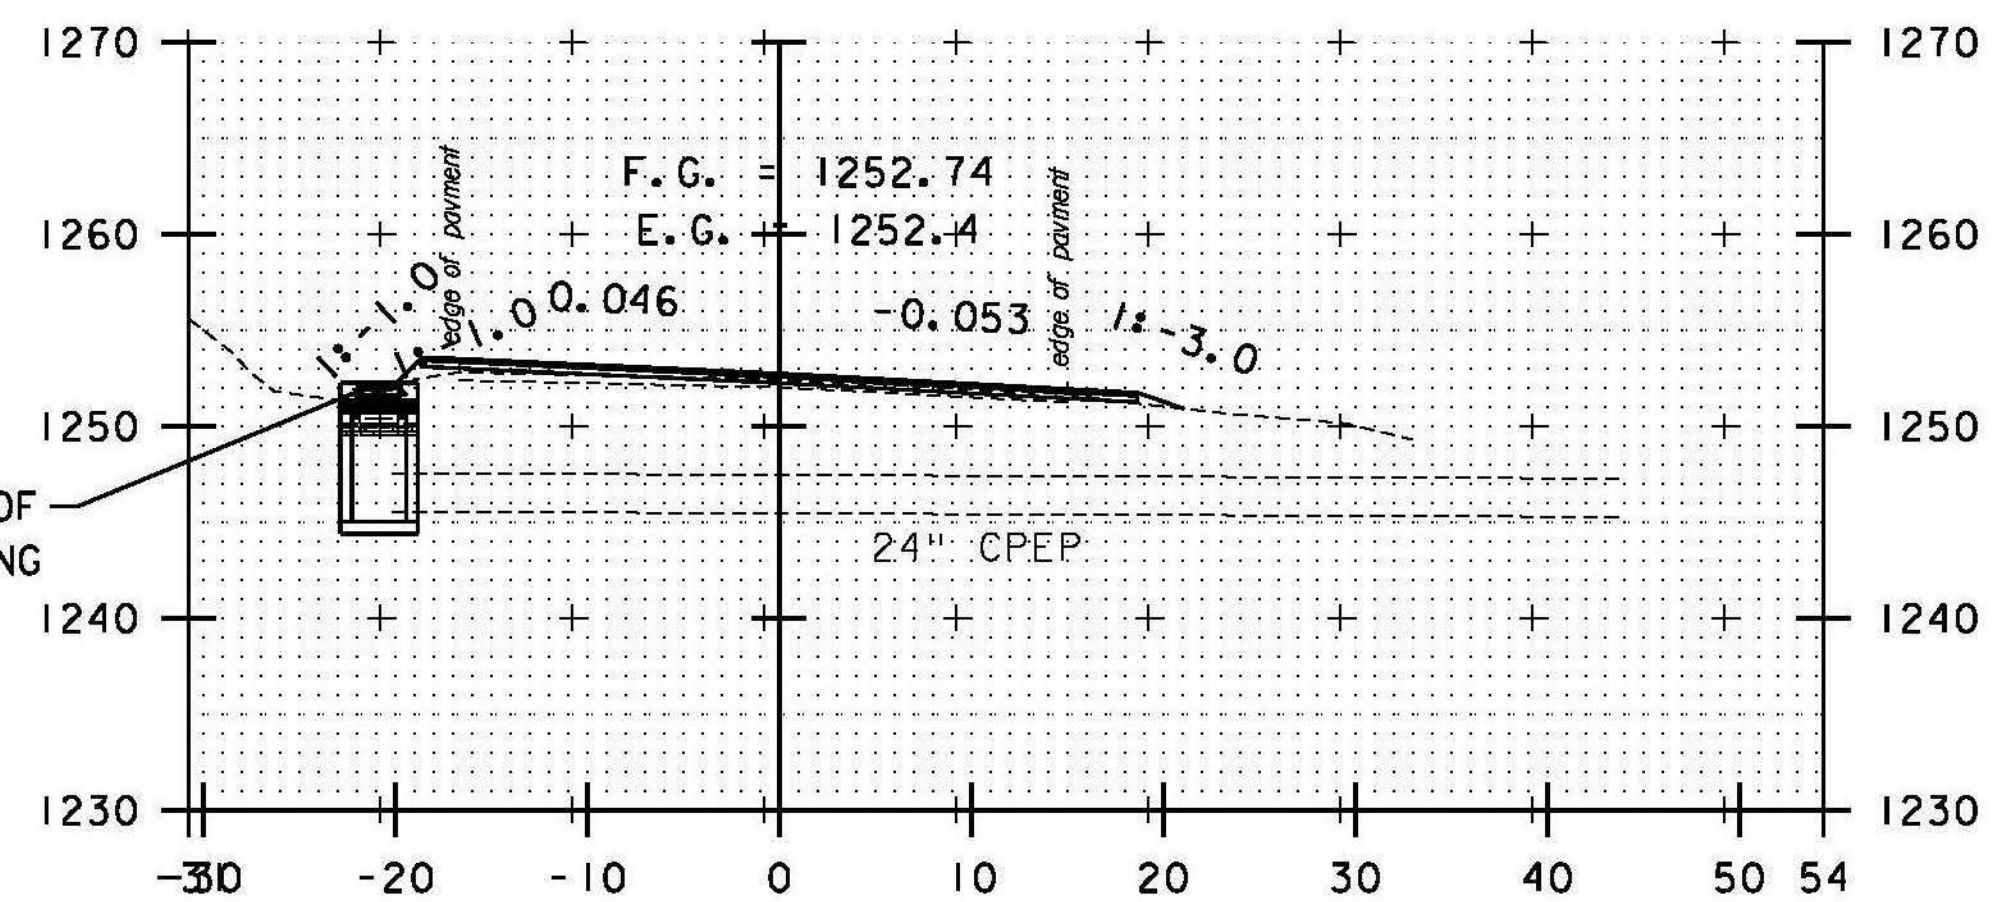


SKEWED  
147+79

1 STA. 149+72.22 LT 22.39' TO  
STA. 149+84.89 LT 16.65'  
RAISE CONCRETE REINFORCED  
HEADWALL (1'-4")

RAISE ELEVATION OF  
CATCH BASIN DURING  
CONSTRUCTION

STA. 137+40 TO STA. 149+69

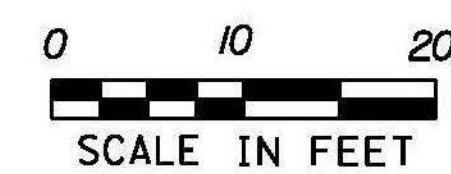

DATUM  
VERTICAL NAVD 88  
HORIZONTAL NAD 83

PROJECT NAME: RANDOLPH  
PROJECT NUMBER: STP 2932 (1)

FILE NAME: z10c270.dgn  
PROJECT LEADER: C. LATHROP  
DESIGNED BY: B. BRESLEND  
CULVERT CROSS SECTION SHEET 13

PLOT DATE: 6/5/2014  
DRAWN BY: B. BRESLEND  
CHECKED BY: C. LATHROP  
SHEET 260 OF 276