



STATE OF VERMONT AGENCY OF TRANSPORTATION

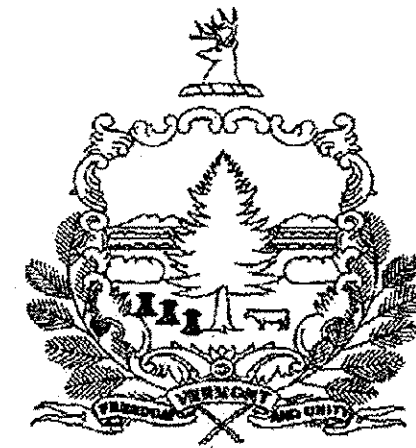

INDEX OF SHEETS AND STANDARDS
SEE SHEET 2

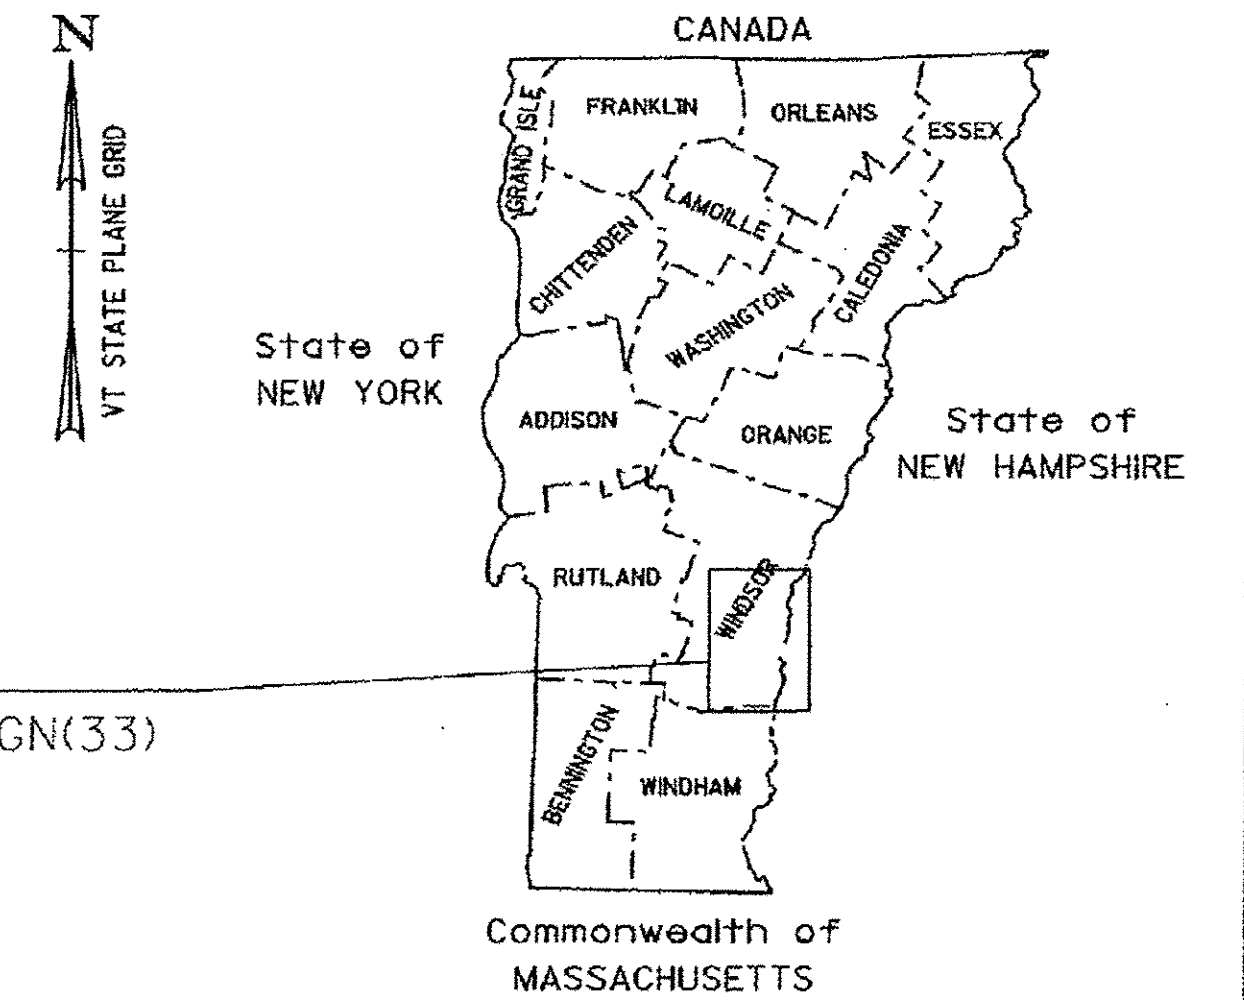

PROJECT LOCATION
SPRINGFIELD-HARTFORD STPG SIGN(33)


PROPOSED IMPROVEMENT TOWNS OF SPRINGFIELD, WEATHERSFIELD, WINDSOR, HARTLAND AND HARTFORD COUNTY OF WINDSOR US ROUTE 5 (MAJOR COLLECTOR)

SOUTHEAST REGION SIGN REPLACEMENT - 33.115 MILES ON US 5 SPRINGFIELD MP 0.000-9.118, US 5 WEATHERSFIELD MP 0.000-6.791,
US 5 WINDSOR MP 0.000-6.845 (INCLUDING CLASS I), US 5 HARTLAND MP 0.000-7.672 AND US 5 HARTFORD MP 0.000-2.689

LENGTH OF ROADWAY = 33.115 MILES
LENGTH OF PROJECT = 33.115 MILES

WORK TO BE PERFORMED UNDER THIS PROJECT INCLUDES THE REMOVAL OF EXISTING SIGNS AND POSTS
AND THE INSTALLATION OF NEW SIGNS, SIGN POSTS AND OTHER RELATED HIGHWAY ITEMS.

RECORD PLANS	
CONTRACTOR:	L&D SAFETY MARKINGS CORP.-BERLIN, VT
RESIDENT ENGINEER:	MARK HAUGHWOUT
CONSTRUCTION BEGAN:	JUNE 11, 2012
CONSTRUCTION COMPLETE:	OCTOBER 5, 2012
RECORD PLANS BY:	MARK HAUGHWOUT & NICK GARBACK
I HEREBY CERTIFY THAT ALL THE CONSTRUCTION REQUIRED BY THIS SET OF DRAWINGS HAS BEEN ACCOMPLISHED AS INDICATED HEREIN.	
BY	<i>Mark Haughwout</i> RESIDENT ENGINEER
DATE	3/12/14
NOTE: Any further information concerning final quantities, amounts or other details relative to this project may be found at Central Files in the electronic archives.	

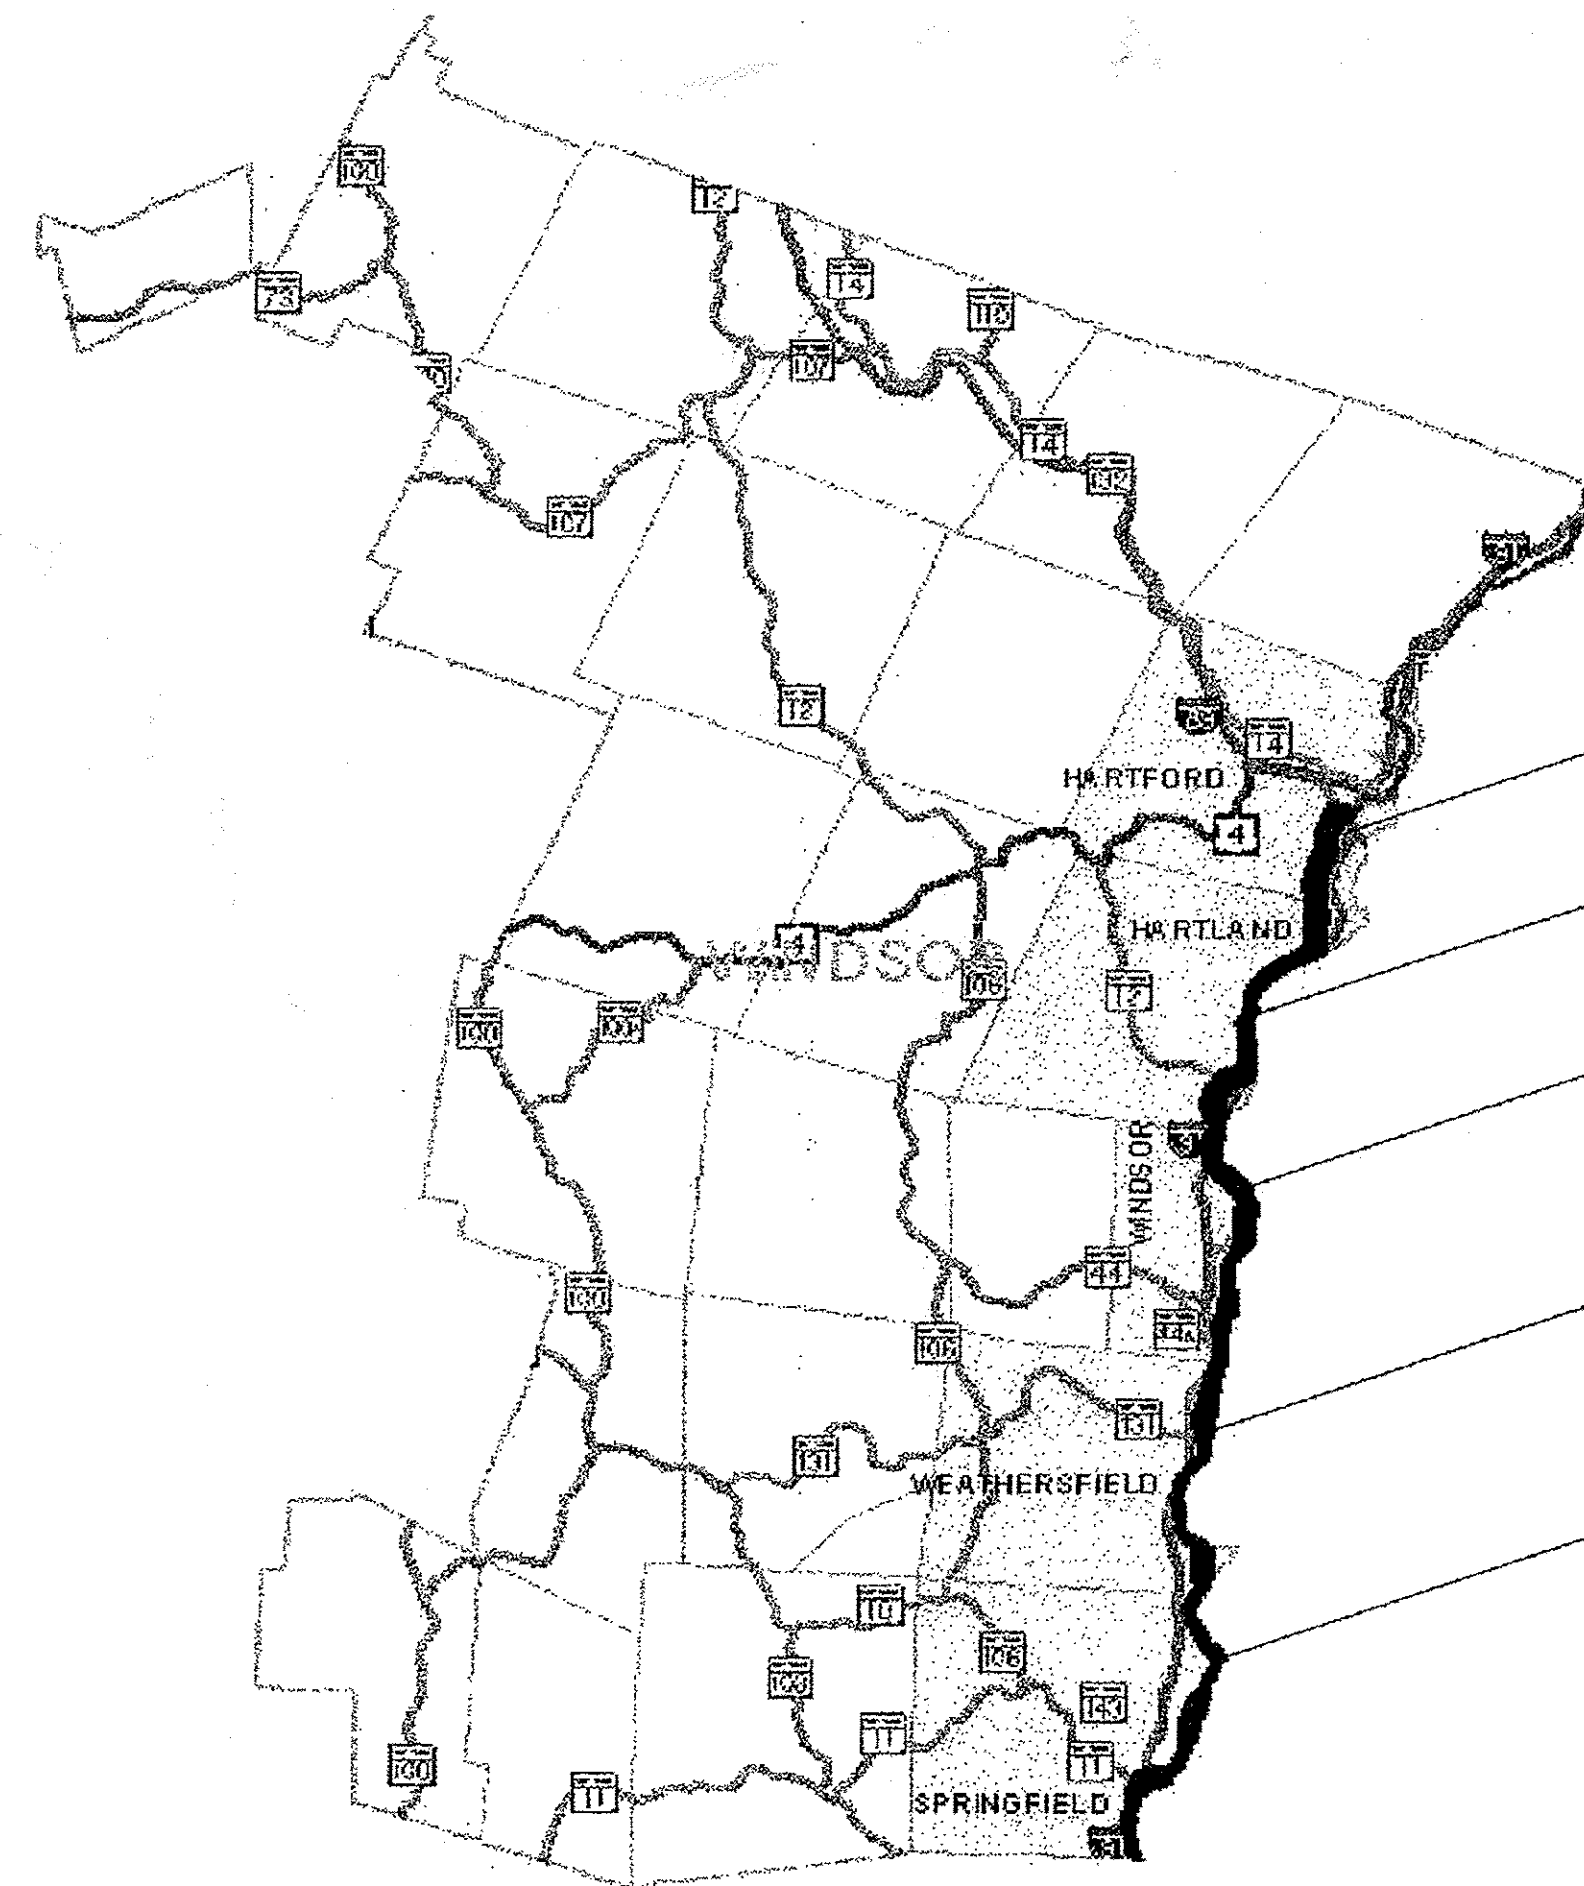

- HARTFORD US 5
MP 0.000-2.689
- HARTLAND US 5
MP 0.000-7.672
- WINDSOR US 5
MP 0.000-6.845 (INCLUDING CLASS I)
- WEATHERSFIELD US 5
MP 0.000-6.791
- SPRINGFIELD US 5
MP 0.000-9.118

QUALITY ASSURANCE PROGRAM: LEVEL 3

CONVENTIONAL SYMBOLS

COUNTY LINE	
TOWN LINE	
LIMITS OF ACCESS	
POINT OF ACCESS	
FENCE LINE	
STONE WALL	
TRAVELED WAY	
GUARDED RAIL	
RAILROAD	
SURVEY LINE	
CULVERT	
POWER POLE	
TELEPHONE POLE	
TREES	
CONTROL OF ACCESS	
PROPERTY LINE	
R.O.W. TAKING LINE	
SLOPE RIGHTS	
TOP OF CUT	
TOE OF SLOPE	

SURVEYED BY : N/A
SURVEYED DATE : N/A

DATUM
VERTICAL : N/A
HORIZONTAL : N/A

NOT TO SCALE

THESE PLANS ARE SUBJECT TO SUCH ENGINEERING CHANGES AS MAY BE REQUIRED BY THE FEDERAL HIGHWAY ADMINISTRATION OR THE DIRECTOR OF PROGRAM DEVELOPMENT.

CONSTRUCTION IS TO BE CARRIED ON IN ACCORDANCE WITH THESE PLANS AND THE STANDARD SPECIFICATIONS FOR CONSTRUCTION DATED 2011, AS APPROVED BY THE FEDERAL HIGHWAY ADMINISTRATION ON JULY 20, 2011 FOR USE ON THIS PROJECT, INCLUDING ALL SUBSEQUENT REVISIONS AND SUCH REVISED SPECIFICATIONS AND SPECIAL PROVISIONS AS ARE INCORPORATED IN THESE PLANS.

DIRECTOR OF PROGRAM DEVELOPMENT	
APPROVED <i>Richard Johnson</i>	DATE 2/22/12
PROJECT MANAGER : AMY GAMBLE	
PROJECT NAME : SPRINGFIELD-HARTFORD	
PROJECT NUMBER : STPG SIGN (33)	
SHEET 1 OF 162 SHEETS	