
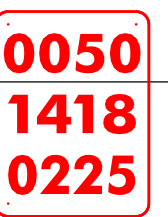


DIRECTION	MILEPOINT	LOCATION CODE (SHEET 2)	SIGN CODE	WIDTH (IN)	HEIGHT (IN)	SHEETING REMARKS	SIGN LEGEND	NEW SIGNS		EXISTING SIGNS				EXIST POST		NUMBER OF NEW POSTS	SQUARE STEEL (IN)			TUBULAR STEEL Ø (IN)				SIGN FRAME REQUIRED	REMARKS	SIGN DETAIL LOCATION			
								"A"	"B"	RETAIN	SALVAGE FROM	SALVAGE TO	REMOVE	RETAIN	REMOVE		1.75	2.00	2.50	FOUNDATION	3.00	3.50	4.00			5.00	SHSM	PROJECT SHEET #	STANDARD SHEET #
																	(LB / FT)				(LB / FT)								
<b>SPRINGFIELD NB</b>							FY-FLUORESCENT YELLOW FYG-FLUORESCENT YELLOW GREEN																"SHMS"-STANDARD HIGHWAY SIGNS AND MARKINGS						
NB	2.241	D	R1-1	18	18		STOP			1					X										ON BIKE ROUTE				
NB	2.251	A	R1-1	36	36					1	1	2			X							MILE MARKER PLAQUE WAS SALVAGED ONTO THE NEW POST.				ON US ROUTE 5 AT THE JCT WITH VERMONT ROUTE 11			
		A	R1-1	36	36			9.00								X													
NB	2.262	A	M3-1	24	12		NORTH					1		X											RETAIN THE EXISTING TUBULAR STEEL POSTS; DISCARD THE EXISTING SIGN FRAME, IT WILL BE REPLACED				
		A	M1-4	24	24		US ROUTE 5					1																	
		A	VM-120	18	24		CT RIVER BYWAY			1		1													TO BE SALVAGED ONTO THE NEW ASSEMBLY AT THIS LOCATION				
		A	D6-4A	18	9		AMERICA'S BYWAYS (PLAQUE)			0	0	0													TO BE SALVAGED ONTO THE NEW ASSEMBLY AT THIS LOCATION				
		A	M3-2	24	12		EAST					1																	
		A	M1-5	24	24		VERMONT ROUTE 11					1																	
		A	M4-5	24	12		TO					1																	
		A	M1-1	24	24		INTERSTATE 91					1																	
		A	M6-3	21	15		UP ARROW					1																	
		A	M3-1	24	12		(SEE NEXT PAGE)	2.00																#3	BLACK ON WHITE "NORTH"; INSTALL THIS SIGN ASSEMBLY AS SHOWN IN THE SIGN LEGEND	X			
		A	M1-4	24	24		(SEE NEXT PAGE)	4.00																	US ROUTE 5	X			
		A	VM-120	18	24		(SEE NEXT PAGE)					1													BYWAY PARENT SIGN; SALVAGE TO UNDER THE US ROUTE 5 SIGNS ON THE LEFT-SIDE POST				
<b>SIGN SUMMARY SHEET</b>							SHEET TOTALS	15.00	0.00	1	2	1	10	0	0	2	30							PROJECT NAME: <b>SPRINGFIELD-HARTFORD</b>					
								SF	SF	EA	EA	EA	EA	EA	EA	EA	FT							PROJECT NUMBER: <b>STPG SIGN(33)</b>					
VERMONT AGENCY OF TRANSPORTATION							TOWN DIRECTIONAL TOTALS	615.4	0.0	12.0	5.0	5.0	145	0.0	0.0	82	1230.0							FILE NAME: <b>SPRINGFIELD US-5 NB</b>	PLOT DATE: <b>2/13/2012</b>				
																								PROJECT MANAGER: <b>A. GAMBLE</b>	DRAWN BY: <b>M. MILLER</b>				
																								DESIGNED BY: <b>M. MILLER</b>	CHECKED BY: <b>A. GAMBLE</b>				
																								SPRINGFIELD US-5 NORTHBOUND 5	SHEET <b>21</b>	OF <b>162</b>			