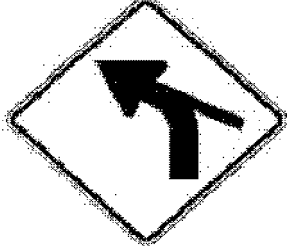


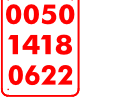



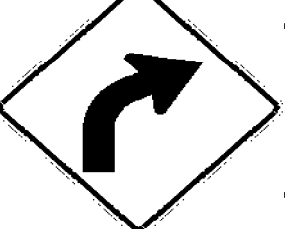




DIRECTION	MILEPOINT	LOCATION CODE (SHEET 2)	SIGN CODE	WIDTH (IN)	HEIGHT (IN)	SHEETING REMARKS	SIGN LEGEND	NEW SIGNS		EXISTING SIGNS				EXIST POST		NUMBER OF NEW POSTS	SQUARE STEEL (IN)			TUBULAR STEEL Ø (IN)				SIGN FRAME REQUIRED	REMARKS	SIGN DETAIL LOCATION			
								"A"	"B"	RETAIN	SALVAGE FROM	SALVAGE TO	REMOVE	RETAIN	REMOVE		1.75	2.00	2.50	FOUNDATION	3.00	3.50	4.00			5.00	SHSM	PROJECT SHEET #	STANDARD SHEET #
																	(LB / FT)				(LB / FT)								
SPRINGFIELD NB							FY-FLUORESCENT YELLOW FYG-FLUORESCENT YELLOW GREEN																"SHMS"-STANDARD HIGHWAY SIGNS AND MARKINGS						
NB	5.278	A	R2-1	24	30		SPEED LIMIT 50				1	1	2		X										MILE MARKER PLAQUE WAS SALVAGED ONTO THE NEW POST				
NB	5.996	A	unknown	30	30		2 MILES WINDING ROAD						1		X										NOTE: USE THIS LOCATION AS REFERENCE FOR THE NEXT SIGN				
NB	6.063	A	W1-10cL	36	36			9.00								2		X							INSTALL 350 FT± NORTH OF REMOVAL AT MP 5.996; USE INTERIM DETAIL IN 2004 SHS FOR THIS NEW 2009 MUTCD SIGN	X			
NB	6.145	B	M1-4	24	24		US ROUTE 5						1		X										AT JCT W/ OLD CONNECTICUT RIVER ROAD (TH-62, NORTHERLY JCT)				
		B	M6-1R	21	15		RIGHT ARROW						1												BOTH SIGNS FACE SB US-5 TRAFFIC				
NB	6.145	C	VR-017	24	30		(MISSING)																		OLD CONNECTICUT RIVER RD (TH-62, NORTHERLY JCT)				
		C	VR-017	24	30			5.00								1		X									6		
NB	6.163	D	R1-1	30	30		OLD CONN RIVER ROAD				2	2	3		X										MILE MARKER PLAQUE AND STREET SIGN WERE SALVAGED ONTO THE NEW POST				
		D	R1-1	30	30			6.25			1	1				1		X						EXISTING STOP SIGN WAS REMOVED AND SALVAGED ONTO THE NEW POST	X				
NB	6.188	A	M3-1	24	12			2.00								1		X							BLACK ON WHITE "NORTH"; INSTALL 145± FT± NORTH OF THE STOP SIGN AT MP 6.163	X			
		A	M1-4	24	24			4.00																	US ROUTE 5	X			
NB	6.216	A	R2-1	24	30			5.00								1		X							INSTALL 150 FT± NORTH OF THE NEW ROUTE SIGNS AT MP 6.188; MINOR TREE BRANCH TRIMMING LIKELY REQUIRED	X			
NB	6.254	A	W1-2R	30	30			6.25								1		X							INSTALL 200 FT± NORTH OF THE NEW SPEED LIMIT 50 SIGN AT MP 6.216	X			
NB	6.503	A	W1-5L	30	30			6.25								1		X							INSTALL BEHIND RAIL 300 FT± SOUTH OF THE SIDE ROAD LEFT SIGN AT MP 6.560	X			
		A	W7-3aP	24	18			3.00																			8		
SIGN SUMMARY SHEET							SHEET TOTALS	40.50 46.75	0.00	0	30	30	75	0	0	8		113.25 120							PROJECT NAME: SPRINGFIELD-HARTFORD PROJECT NUMBER: STPG SIGN(33)				
VERMONT AGENCY OF TRANSPORTATION							TOWN DIRECTIONAL TOTALS	615.4	0.0	12.0	5.0	5.0	145	0.0	0.0	82		1230.0							FILE NAME: SPRINGFIELD US-5 NB PROJECT MANAGER: A. GAMBLE DESIGNED BY: M. MILLER SPRINGFIELD US-5 NORTHBOUND 19	PLOT DATE: 2/13/2012 DRAWN BY: M. MILLER CHECKED BY: A. GAMBLE SHEET 35 OF 162			