







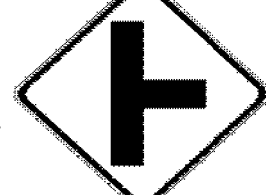
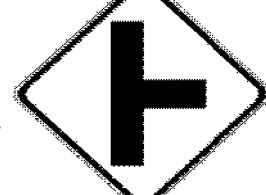
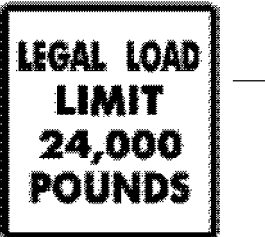
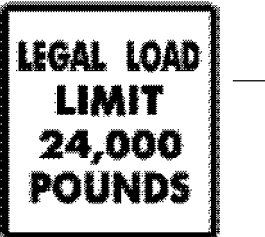


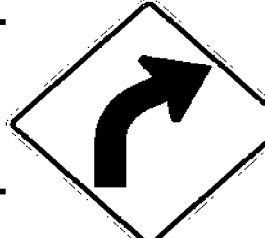

DIRECTION	MILEPOINT	LOCATION CODE (SHEET 2)	SIGN CODE	WIDTH (IN)	HEIGHT (IN)	SHEETING REMARKS	SIGN LEGEND	NEW SIGNS		EXISTING SIGNS				EXIST POST		NUMBER OF NEW POSTS	SQUARE STEEL (IN)			TUBULAR STEEL Ø (IN)				SIGN FRAME REQUIRED	REMARKS	SIGN DETAIL LOCATION				
								"A"	"B"	RETAIN	SALVAGE FROM	SALVAGE TO	REMOVE	RETAIN	REMOVE		1.75	2.00	2.50	FOUNDATION	3.00	3.50	4.00			5.00	SHSM	PROJECT SHEET #	STANDARD SHEET #	
																	(LB / FT)				(LB / FT)									
<b>SPRINGFIELD SB</b>							FY-FLUORESCENT YELLOW FYG-FLUORESCENT YELLOW GREEN																"SHSM"-STANDARD HIGHWAY SIGNS AND MARKINGS							
SB	8.067	F	W1-2R	30	30			6.25							1		X								INSTALL ACROSS FROM POLE #291	X				
SB	7.604	G	VR-017	24	24		 (MISSING)																		PUTNAM RD (TH-60) (NORTHERLY JUNCTION)					
		G	VR-017	24	30			5.00							1		X								THE LEGAL LOAD SIGN DID EXIST, THIS WAS THE REMOVAL		6			
SB	7.586	H	R1-1	30	30		 PUTNAM ROAD																		PUTNAM RD (TH-60) (NORTHERLY JUNCTION)					
		H	R1-1	30	30			6.25							1		X											X		
SB	6.691	F	W1-5R	30	30			6.25							1		X									INSTALL 500 FT± NORTH OF THE EXISTING "WATCH FOR FALLEN ROCK" SIGN AT MP 6.596	X			
		F	W7-3aP	24	18			3.00																					8	
SB	6.956	F	VW-444	30	30		WATCH FOR FALLEN ROCK (TEXT)																			TO BE REPLACED WITH A SYMBOL WARNING SIGN AT MP 6.947				
SB	6.947	F	VW-285	30	30			6.25							1		X									INSTALL 50 FT± SOUTH OF THE REMOVED TEXT SIGN AT MP 6.956			8	
SB	6.714	F	W2-2R	30	30			6.25							1		X									INSTALL 250 FT± NORTH OF THE JCT w/ PUTNAM RD (TH-60) AT MP 6.667	X			
		F	W16-8P	30	8		 Putnam Rd	1.67																					9	
SB	6.667	G	VR-017	24	24																					PUTNAM RD (TH-60) (SOUTHERLY JUNCTION)				
		G	VR-017	24	30			5.00							1		X												6	
SB	6.661	H	R1-1	24	24		 PUTNAM ROAD																			PUTNAM RD (TH-60) (SOUTHERLY JUNCTION)				
		H	R1-1	30	30		 0050 1418 0871	6.25							1												PUTNAM RD (TH-60) (SOUTHERLY JUNCTION)			
																										(RETAIN THE EXISTING POST)	X			
<b>SIGN SUMMARY SHEET</b>							SHEET TOTALS	52.17	0.00	0	30	30	84	0	0	7		105								PROJECT NAME: <b>SPRINGFIELD-HARTFORD</b>				
								SF	SF	EA	EA	EA	EA	EA	EA	EA	FT									PROJECT NUMBER: <b>STPG SIGN(33)</b>				
VERMONT AGENCY OF TRANSPORTATION							TOWN DIRECTIONAL TOTALS	495.5	0.0	26.0	3.0	3.0	101	0.0	0.0	69		1035.0								FILE NAME: <b>SPRINGFIELD US-5 SB</b>	PLOT DATE: <b>2/9/2012</b>			
																										PROJECT MANAGER: <b>A. GAMBLE</b>	DRAWN BY: <b>M. MILLER</b>			
																										DESIGNED BY: <b>M. MILLER</b>	CHECKED BY: <b>A. GAMBLE</b>			
																										SPRINGFIELD US-5 SOUTHBOUND 3	SHEET <b>41</b>	OF <b>162</b>		