


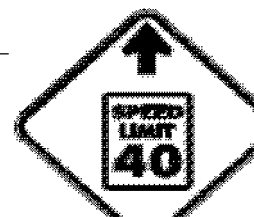
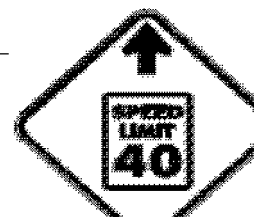








DIRECTION	MILEPOINT	LOCATION CODE (SHEET 2)	SIGN CODE	WIDTH (IN)	HEIGHT (IN)	SHEETING REMARKS	SIGN LEGEND	NEW SIGNS		EXISTING SIGNS				EXIST POST		NUMBER OF NEW POSTS	SQUARE STEEL (IN)			TUBULAR STEEL Ø (IN)				SIGN FRAME REQUIRED	REMARKS	SIGN DETAIL LOCATION			
								"A"	"B"	RETAIN	SALVAGE FROM	SALVAGE TO	REMOVE	RETAIN	REMOVE		1.75	2.00	2.50	FOUNDATION	3.00	3.50	4.00			5.00	SHSM	PROJECT SHEET #	STANDARD SHEET #
																	(LB / FT)				(LB / FT)								
<b>WEATHERSFIELD NB</b>							FY-FLUORESCENT YELLOW FYG-FLUORESCENT YELLOW GREEN															"SHSM"-STANDARD HIGHWAY SIGNS AND MARKINGS							
NB	1.292	D	R1-1	30	30		 (CONT.)	6.25							1		X								X				
NB	1.340	A	R2-1	24	30		SPEED LIMIT 50			1							X									ASTM TYPE IV, AS-NEW, RETAIN			
NB	1.430	A	W1-5L	30	30			6.25							1		X								X	INSTALL BEHIND RAIL 475 FT± NORTH OF THE SPEED LIMIT 50 SIGN AT MP 1.340			
NB	1.925	A	VW-054R	30	30			6.25							1		X									INSTALL <sup>260</sup> <del>280</del> FT± NORTH OF DRIVE #1577 AT MP 1.872			E-154
NB	3.649	A	W3-5	36	36										1		X												
		A	W3-5	36	36			9.00							2		X								X				
NB	3.756	A	R2-1	24	30										1		X									NOTE: THE NEW SIGN IS LARGER, FIRST SIGN IN THE REDUCED SPEED ZONE 40		6	
		A	R2-1	30	36			7.50							1		X												
NB	3.781	A	W11-2	30	30		PEDESTRIAN SYMBOL								1		X												
		A	W7-3A	24	18		NEXT 1/2 MILE PLAQUE								1														
		A	W11-2	30	30	FYG		6.25							1		X								X				
		A	W7-3aP	24	18	FYG		3.00																		8			
NB	3.877	A	W1-4L	30	30										1		X												
		A	W1-4L	30	30			6.25							1		X								X				
NB	3.995	A	W11-2	30	30		PEDESTRIAN SYMBOL (CONT. ON NEXT PAGE)								1		X												
<b>SIGN SUMMARY SHEET</b>							<b>SHEET TOTALS</b>	50.75	0.00	1	0	0	6	0	0	8		120.0	0	0.0	0.0	0.0	0.0	PROJECT NAME: <b>SPRINGFIELD-HARTFORD</b> PROJECT NUMBER: <b>STPG SIGN(33)</b>					
VERMONT AGENCY OF TRANSPORTATION							<b>TOWN DIRECTIONAL TOTALS</b>	367.0	0.0	11	4	4	89	0	0	48		720.0	0		0.0			FILE NAME: <b>WEATHERSFIELD US-5 NB</b> PLOT DATE: <b>2/13/2012</b> PROJECT MANAGER: <b>A. GAMBLE</b> DRAWN BY: <b>M. MILLER</b> DESIGNED BY: <b>M. MILLER</b> CHECKED: <b>A. GAMBLE</b> WEATHERSFIELD US-5 NB 2 SHEET <b>56</b> OF <b>162</b>					