
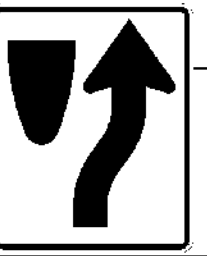
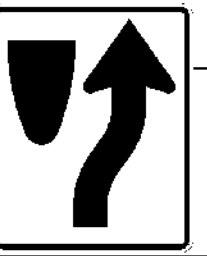
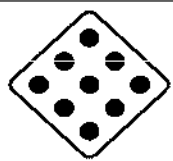
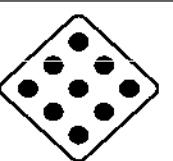
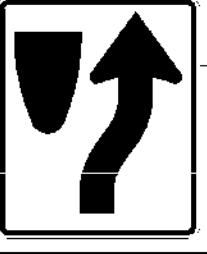
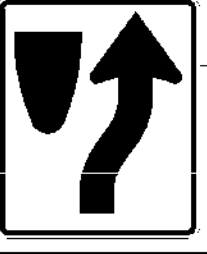
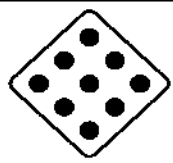


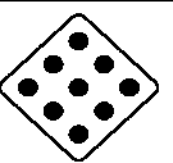

| DIRECTION | MILEPOINT | LOCATION CODE (SHEET 2) | SIGN CODE | WIDTH (IN) | HEIGHT (IN) | SHEETING REMARKS | SIGN LEGEND | NEW SIGNS | | EXISTING SIGNS | | | | EXIST POST | | NUMBER OF NEW POSTS | SQUARE STEEL (IN) | | | TUBULAR STEEL Ø (IN) | | | | SIGN FRAME REQUIRED | REMARKS | SIGN DETAIL LOCATION | | | |
|----------------------------------|-----------|-------------------------|-----------|------------|-------------|------------------|--|-----------|------|----------------|--------------|------------|--------|------------|--------|---------------------|-------------------|------|------|----------------------|-----------|--|--|---|---------|----------------------|------|-----------------|------------------|
| | | | | | | | | "A" | "B" | RETAIN | SALVAGE FROM | SALVAGE TO | REMOVE | RETAIN | REMOVE | | 1.75 | 2.00 | 2.50 | FOUNDATION | 3.00 | 3.50 | 4.00 | | | 5.00 | SHSM | PROJECT SHEET # | STANDARD SHEET # |
| | | | | | | | | | | | | | | | | | (LB / FT) | | | | (LB / FT) | | | | | | | | |
| WEATHERSFIELD NB | | | | | | | FY-FLUORESCENT YELLOW FYG-FLUORESCENT YELLOW GREEN | | | | | | | | | | | | | | | "SHSM"-STANDARD HIGHWAY SIGNS AND MARKINGS | | | | | | | |
| NB | 5.176 | K | R4-7 | 24 | 30 | | KEEP RIGHT SYMBOL (ON BACK) (CONT.) | | | | | | | | | | | | | | | | | | | | | | |
| | | K | OM1-1 | 18 | 18 | | YELLOW / YELLOW OBJECT MARKER (ON BACK) | | | | | | | | | | | | | | | | | | | | | | |
| | | J | OM1-1 | 18 | 18 | |  | 2.25 | | | | | | | 1 | | X | | | | | | | | | | | | |
| | | K | R4-7 | 24 | 30 | |  | 5.00 | | | | | | | | | | | | | | | | | | | | | |
| | | K | OM1-1 | 18 | 18 | |  (BACK-TO-BACK)  | 2.25 | | | | | | | | | | | | | | | | | | | | | |
| NB | 5.184 | J | R4-7 | 24 | 30 | | KEEP RIGHT SYMBOL | | | | | | | | | | | | | | | | | | | | | | |
| | | J | OM1-1 | 18 | 18 | | YELLOW / YELLOW OBJECT MARKER | | | | | | | | | | | | | | | | | | | | | | |
| | | K | OM1-1 | 18 | 18 | | OBJECT MARKER (ON BACK ~ MISSING) | | | | | | | | | | | | | | | | | | | | | | |
| | | J | R4-7 | 24 | 30 | |  | 5.00 | | | | | | | 1 | | X | | | | | | | | | | | | |
| | | J | OM1-1 | 18 | 18 | |  | 2.25 | | | | | | | | | | | | | | | | | | | | | |
| | | K | OM1-1 | 18 | 18 | |  (BACK-TO-BACK)  | 2.25 | | | | | | | | | | | | | | | | | | | | | |
| NB | 5.186 | D | R1-1 | 30 | 30 | |  | | | | | | | | | | | | | | | | | | | | | | |
| | | D | R1-1 | 30 | 30 | |  | 6.25 | | | | | | | 1 | | X | | | | | | | | | | | | |
| NB | 5.188 | A | W11-2 | 30 | 30 | | PEDESTRIAN SYMBOL | | | 1 | | | | | | | | | | | | | | | | | | | |
| | | A | W16-7P | 24 | 12 | | DIAGONAL ARROW | | | 1 | | | | | | | | | | | | | | | | | | | |
| SIGN SUMMARY SHEET | | | | | | | SHEET TOTALS | 25.25 | 0.00 | 2 | 0 | 0 | 5 | 0 | 0 | 3 | 45.0 | 0 | 0.0 | 0.0 | 0.0 | 0.0 | PROJECT NAME: SPRINGFIELD-HARTFORD PROJECT NUMBER: STPG SIGN(33) | | | | | | |
| VERMONT AGENCY OF TRANSPORTATION | | | | | | | TOWN DIRECTIONAL TOTALS | 367.0 | 0.0 | 11 | 4 | 4 | 89 | 0 | 0 | 48 | 720.0 | 0 | | 0.0 | | | FILE NAME: WEATHERSFIELD US-5 NB PROJECT MANAGER: A. GAMBLE DESIGNED BY: M. MILLER WEATHERSFIELD US-5 NB 8 | PLOT DATE: 2/13/2012 DRAWN BY: M. MILLER CHECKED: A. GAMBLE SHEET 62 OF 162 | | | | | |