
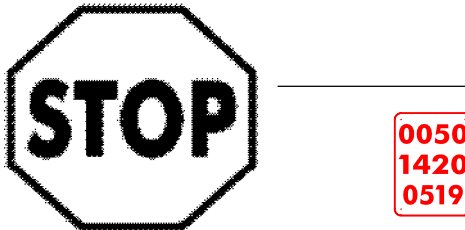


DIRECTION	MILEPOINT	LOCATION CODE (SHEET 2)	SIGN CODE	WIDTH (IN)	HEIGHT (IN)	SHEETING REMARKS	SIGN LEGEND	NEW SIGNS		EXISTING SIGNS				EXIST POST		NUMBER OF NEW POSTS	SQUARE STEEL (IN)			TUBULAR STEEL Ø (IN)				SIGN FRAME REQUIRED	REMARKS	SIGN DETAIL LOCATION			
								"A"	"B"	RETAIN	SALVAGE FROM	SALVAGE TO	REMOVE	RETAIN	REMOVE		1.75	2.00	2.50	FOUNDATION	3.00	3.50	4.00			5.00	SHSM	PROJECT SHEET #	STANDARD SHEET #
																	(LB / FT)				(LB / FT)								
WEATHERSFIELD SB							FY-FLUORESCENT YELLOW FYG-FLUORESCENT YELLOW GREEN															"SHSM"-STANDARD HIGHWAY SIGNS AND MARKINGS							
SB	5.194	F	W16-7P	24	12		DIAGONAL ARROW (CONT.)			1																			
SB	5.177	G	VR-017	24	30																		OLD SIGN WAS MISSING ASCUTNEY STORE RD (TH-33)						
		G	VR-017	24	30			5.00										X							6				
SB	5.169	H	R1-1	30	30																		ASCUTNEY STORE RD (TH-33) MILE MARKER PLAQUE WAS SALVAGED ONTO NEW POST						
		H	R1-1	30	30			6.25										X						X					
SB	5.169	F	M3-3	24	12		SOUTH																RETAIN BOTH TUBULAR STEEL POSTS WITH FOUNDATIONS						
		F	M1-5	24	24		VERMONT ROUTE 12																REMOVE ALL ROUTE MARKER SIGNS AND THE EXISTING SIGN FRAME						
		F	M6-1L	21	15		<--- LEFT ARROW																						
		F	M3-3	24	12		SOUTH																						
		F	M1-4	24	24		US ROUTE 5																						
		F	M6-3	21	15		^UP ARROW																						
		F	M4-5	24	12		TO																						
		F	M1-1	24	24		INTERSTATE 91																						
		F	M6-2R	21	15		RIGHT ARROW (45 DEG) --->																						
		F	M4-5	24	12		TO (CONT. ON NEXT PAGE)																						
SIGN SUMMARY SHEET							SHEET TOTALS	11.25	0.00	1	10	10	12	0	0	2	30.0	0	0.0	0.0	0.0	0.0	PROJECT NAME: SPRINGFIELD-HARTFORD	PROJECT NUMBER: STPG SIGN(33)					
								SF	SF	EA	EA	EA	EA	EA	EA	EA	FT	EA	LB	LB	LB	LB	FILE NAME: WEATHERSFIELD US-5 SB	PLOT DATE: 2/13/2012					
VERMONT AGENCY OF TRANSPORTATION							TOWN DIRECTIONAL TOTALS	327.0	0.0	17	4	4	82	0	0	37	555.0	0		0.0			PROJECT MANAGER: A. GAMBLE	DRAWN BY: M. MILLER					
																						DESIGNED BY: M. MILLER	CHECKED: A. GAMBLE						
																						WEATHERSFIELD US-5 SB 8	SHEET 76 OF 162						