


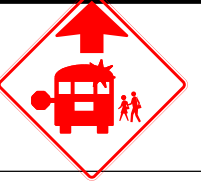


DIRECTION	MILEPOINT	LOCATION CODE (SHEET 2)	SIGN CODE	WIDTH (IN)	HEIGHT (IN)	SHEETING REMARKS	SIGN LEGEND	NEW SIGNS		EXISTING SIGNS				EXIST POST		NUMBER OF NEW POSTS	SQUARE STEEL (IN)			TUBULAR STEEL Ø (IN)				SIGN FRAME REQUIRED	REMARKS	SIGN DETAIL LOCATION															
								"A"	"B"	RETAIN	SALVAGE FROM	SALVAGE TO	REMOVE	RETAIN	REMOVE		1.75	2.00	2.50	FOUNDATION	3.00	3.50	4.00			5.00	SHSM	PROJECT SHEET #	STANDARD SHEET #												
																	(LB / FT)				(LB / FT)																				
<b>WEATHERSFIELD SB</b>							FY-FLUORESCENT YELLOW FYG-FLUORESCENT YELLOW GREEN															"SHSM"-STANDARD HIGHWAY SIGNS AND MARKINGS																			
SB	1.219	F	R2-1	24	30			5.00							1		X										INSTALL 545 FT± SOUTH OF THE STOP SIGN AT MP 1.322	X													
SB	0.925	F	R2-1	24	30																																				
		F	R2-1	24	30			0 5.00		I								X														ALL RETAINED AS PER ORDER NOTED REQUEST BY MARCOS MILLER/MARK HAUGHWOUT	X								
SB	2.060	F	S3-1	36	36			9.00		I	I	I				2		X																	THIS SIGN ADDED PER REQUEST OF M. MILLER, TRAFFIC OPS. SEE E-MAIL DATED 6/25/12						
																								</																	