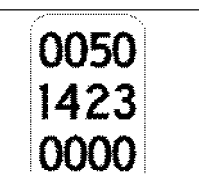
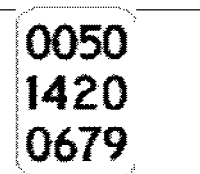


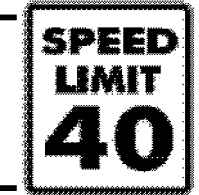

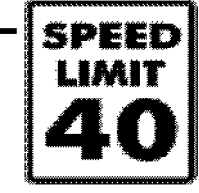


DIRECTION	MILEPOINT	LOCATION CODE (SHEET 2)	SIGN CODE	WIDTH (IN)	HEIGHT (IN)	SHEETING REMARKS	SIGN LEGEND	NEW SIGNS		EXISTING SIGNS				EXIST POST		NUMBER OF NEW POSTS	SQUARE STEEL (IN)			TUBULAR STEEL Ø (IN)				SIGN FRAME REQUIRED	REMARKS	SIGN DETAIL LOCATION			
								"A"	"B"	RETAIN	SALVAGE FROM	SALVAGE TO	REMOVE	RETAIN	REMOVE		1.75	2.00	2.50	FOUNDATION	3.00	3.50	4.00			5.00	SHSM	PROJECT SHEET #	STANDARD SHEET #
																	(LB / FT)				(LB / FT)								
<b>WINDSOR NB</b>							FY-FLUORESCENT YELLOW FYG-FLUORESCENT YELLOW GREEN																"SHSM"-STANDARD HIGHWAY SIGNS AND MARKINGS						
							(THIS LINE INTENTIONALLY LEFT BLANK)																						
NB	0.000	C	VD-024	60	7.5		WINDSOR I WEATHERSFIELD						1		X														
		C	VD-700	6	8		0050 / 1423 / 0000 (WINDSOR MM)						1																
		C	VD-700	6	8		0050 / 1420 / 0679 (WEATHERSFIELD MM)						1																
		C	VD-024	72	10		<b>Windsor   Weathersfield</b>	5.00								2	X									11			
		C	VD-700	6	10		 	0.42																				E-138	
		C	VD-700	6	10			0.42																				E-138	
NB	0.198	A	W1-2L	30	30								1		X														
		A	W1-2L	30	30			6.25								1	X								X				
NB	0.257	A	VW-205	30	30		WATCH FOR TURNING VEHICLES						1		X													TO BE REPLACED FURTHER NORTH AT MP 0.289±	
NB	0.289	A	VW-205	36	36			9.00								2	X											INSTALL 170 FT± NORTH OF THE PREVIOUS POSITION AT MP 0.257	
NB	0.630	A	R2-1	24	30			5.00								1	X								X			INSTALL BEHIND RAIL 1800 FT± NORTH OF THE SIGN AT MP 0.289 (10 FT IN FRONT OF UTILITY POLE)	
NB	0.863	A	VW-054	30	30		HIDDEN DRIVES RIGHT						1		X													TO BE REPLACED FURTHER NORTH AT MP 0.920±	
NB	0.920	A	VW-054	30	30			6.25								1	X											INSTALL BEHIND RAIL 300 FT± NORTH OF THE PREVIOUS POSITION AT MP 0.863; SINGULAR "DRIVE"	
NB	0.962	A	R2-1	24	30			5.00								1	X									X		INSTALL <del>40</del> FT± SOUTH OF THE EXISTING SPEED LIMIT 40 SIGN AT MP 0.970	
<b>SIGN SUMMARY SHEET</b>							<b>SHEET TOTALS</b>	37.34	0.00	0	10	10	76	0	0	8	120.0	0	0.0	0.0	0.0	0.0	PROJECT NAME: <b>SPRINGFIELD-HARTFORD</b>	PROJECT NUMBER: <b>STPG SIGN(33)</b>					
VERMONT AGENCY OF TRANSPORTATION							<b>TOWN DIRECTIONAL TOTALS</b>	436.9	0.0	16	12	12	100	0	0	61	915.0	0		0.0		FILE NAME: <b>WINDSOR US-6 NB</b>	PROJECT MANAGER: <b>A. GAMBLE</b>	PLOT DATE: <b>2/13/2012</b>					
																					DESIGNED BY: <b>M. MILLER</b>	CHECKED: <b>A. GAMBLE</b>	DRAWN BY: <b>M. MILLER</b>						
																					WINDSOR US-5 NB 1	SHEET <b>82</b>	OF <b>162</b>						