
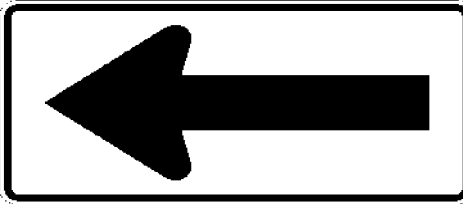

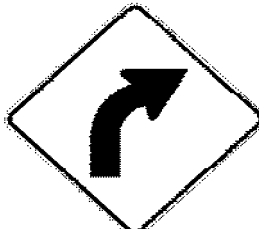
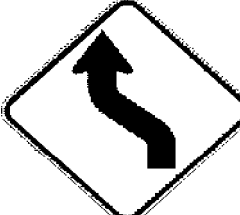




DIRECTION	MILEPOINT	LOCATION CODE (SHEET 2)	SIGN CODE	WIDTH (IN)	HEIGHT (IN)	SHEETING REMARKS	SIGN LEGEND	NEW SIGNS		EXISTING SIGNS				EXIST POST		NUMBER OF NEW POSTS	SQUARE STEEL (IN)			TUBULAR STEEL Ø (IN)				SIGN FRAME REQUIRED	REMARKS	SIGN DETAIL LOCATION			
								"A"	"B"	RETAIN	SALVAGE FROM	SALVAGE TO	REMOVE	RETAIN	REMOVE		1.75	2.00	2.50	FOUNDATION	3.00	3.50	4.00			5.00	SHSM	PROJECT SHEET #	STANDARD SHEET #
																	(LB / FT)				(LB / FT)								
WINDSOR NB							FY-FLUORESCENT YELLOW FYG-FLUORESCENT YELLOW GREEN															"SHSM"-STANDARD HIGHWAY SIGNS AND MARKINGS							
NB	2.250	A	W1-4L	30	30			6.25										X						INSTALL THE NEW SIGN 150 FT± NORTH OF THE PREVIOUS POSITION AT MP 2.221	X				
NB	2.348	A	W1-6L	48	24								1											EXISTING SIGN IS ON ONE POST					
		A	W1-6L	48	24			8.00											X					INSTALL THE NEW SIGN ON TWO NEW POSTS	X				
NB	2.415	A	R2-1	24	30								0 1											RETAINED AS REQUESTED BY MARCOS MILLER, TRAFFIC OPS					
		A	R2-1	24	30			0.00 5.00											X							X			
NB	2.469	A	W1-2R	30	30								0 1												RETAINED AS REQUESTED BY MARCOS MILLER, TRAFFIC OPS				
		A	W1-2R	30	30			0.00 6.25											X							X			
NB	2.666	A	W1-4L	30	30																								
		A	W1-4L	30	30			6.25											X							X			
NB	2.706	A	VW-054	30	30																								
		A	VW-054	30	30			6.25											X						PLURAL "DRIVES"			E-154	
NB	2.806	A	R2-1	24	30		SPEED LIMIT 40						2 1											MILE MARKER PLAQUE WAS SALVAGED ONTO NEW POST					
		A	R2-1	24	30		 SPEED LIMIT 40												X					SALVAGE THE SIGN ONTO A NEW POST (EXISTING IS AN OBSOLETE 4LB/FT FLANGE CHANNEL)					
NB	2.969	A	W1-2L	30	30		LEFT CURVE																						
NB	3.125	A	W3-5	36	36		SPEED REDUCTION 25-MPH (CONT. ON NEXT PAGE)																						
SIGN SUMMARY SHEET							SHEET TOTALS	26.75 38.00	0.00	0	2 1	2 1	7 8	0	0	8	120.0	0	0.0	0.0	0.0	0.0	0.0	PROJECT NAME: SPRINGFIELD-HARTFORD					
								SF	SF	EA	EA	EA	EA	EA	EA	EA	FT	EA	LB	LB	LB	LB	PROJECT NUMBER: STPG SIGN(33)						
VERMONT AGENCY OF TRANSPORTATION							TOWN DIRECTIONAL TOTALS	436.9	0.0	16	12	12	100	0	0	61	915.0	0		0.0			FILE NAME: WINDSOR US-6 NB	PLOT DATE: 2/13/2012					
																						PROJECT MANAGER: A. GAMBLE	DRAWN BY: M. MILLER						
																						DESIGNED BY: M. MILLER	CHECKED: A. GAMBLE						
																						WINDSOR US-5 NB 3	SHEET 84	OF 162					