



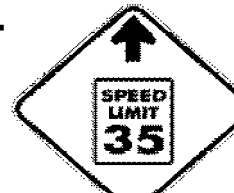



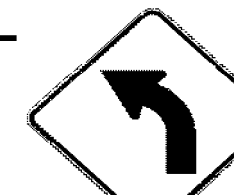





DIRECTION	MILEPOINT	LOCATION CODE (SHEET 2)	SIGN CODE	WIDTH (IN)	HEIGHT (IN)	SHEETING REMARKS	SIGN LEGEND	NEW SIGNS		EXISTING SIGNS				EXIST POST		NUMBER OF NEW POSTS	SQUARE STEEL (IN)			TUBULAR STEEL Ø (IN)				SIGN FRAME REQUIRED	REMARKS	SIGN DETAIL LOCATION			
								"A"	"B"	RETAIN	SALVAGE FROM	SALVAGE TO	REMOVE	RETAIN	REMOVE		1.75	2.00	2.50	FOUNDATION	3.00	3.50	4.00			5.00	SHSM	PROJECT SHEET #	STANDARD SHEET #
																	(LB / FT)				(LB / FT)								
HARTLAND NB							FY-FLUORESCENT YELLOW FYG-FLUORESCENT YELLOW GREEN															"SHSM"-STANDARD HIGHWAY SIGNS AND MARKINGS							
NB	3.861	B	OM3-L	12	36		 (CONT.)	3.00								1	X							FACES SB TRAFFIC	X				
NB	4.360	A	VW-205	36	36			9.00								2	X							INSTALL 190 FT± SOUTH OF THE SCHOOL BUS STOP AHEAD SIGN AT MP 4.396; MAINTAIN 10 FT MIN. TO UTILITY POLE			E-154		
NB	4.396	A	S3-1	30	30		SCHOOL BUS STOP AHEAD																	NOTE LOCATION AS A REFERENCE POINT FOR THE NEXT SIGN					
NB	4.404	A	W1-4R	30	30			6.25								1	X							INSTALL 40 FT± NORTH OF THE REMOVED SCHOOL BUS STOP AHEAD SIGN	X				
		A	W13-1P	18	18			2.25																	X				
NB	5.521	A	R2-5A	24	30		REDUCED SPEED AHEAD																	NOTE LOCATION AS A REFERENCE POINT FOR THE NEXT SIGN					
NB	5.562	A	W3-5	36	36			9.00								2	X							INSTALL 215 FT± NORTH OF THE REMOVED REDUCED SPEED AHEAD SIGN	X				
NB	5.600	A	VD-018	30	18		NORTH HARTLAND WHITE RIVER JCT 5																	TO BE REPLACED FURTHER NORTH AT MP 5.714					
NB	5.667	A	R2-1	24	30																								
		A	R2-1	30	36			7.50								1	X							NOTE: FIRST SIGN IN THE REDUCED SPEED ZONE IS LARGER			6		
NB	5.714	A	VD-018	30	18			3.75								1	X							INSTALL 250 FT± NORTH OF THE SPEED LIMIT 35 SIGN AT MP 5.667			10		
NB	5.777	A	W1-2L	30	30		LEFT CURVE																	TO BE REPLACED FURTHER NORTH AT MP 5.823					
NB	5.823	A	W1-2L	30	30			6.25								1	X							INSTALL 240 FT± NORTH OF THE PREVIOUS POSITION AT MP 5.777	X				
NB	5.923	A	OM3-R	12	36		  BRIDGE SIGN WAS RETAINED																	RETAIN THE EXISTING POST BEHIND RAIL					
		A	OM3-R	12	36			3.00																FACES NB TRAFFIC	X				
SIGN SUMMARY SHEET							SHEET TOTALS	50.00	0.00	0	0	0	6	0	0	9	135.0	0	0.0	0.0	0.0	0.0	PROJECT NAME: SPRINGFIELD-HARTFORD PROJECT NUMBER: STPG SIGN(33)						
VERMONT AGENCY OF TRANSPORTATION							TOWN DIRECTIONAL TOTALS	505.1	0.0	53	3	3	92	0	0	86	1290.0	0		0.0			FILE NAME: HARTLAND US-6 NB PROJECT MANAGER: A. GAMBLE DESIGNED BY: M. MILLER HARTLAND US-5 NB 13				PLOT DATE: 2/14/2012 DRAWN BY: M. MILLER CHECKED: A. GAMBLE SHEET 126 OF 162		