


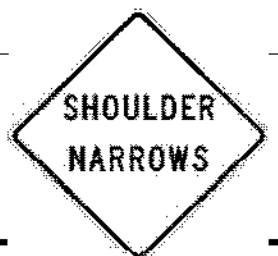
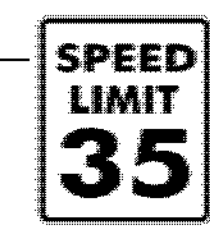


DIRECTION	MILEPOINT	LOCATION CODE (SHEET 2)	SIGN CODE	WIDTH (IN)	HEIGHT (IN)	SHEETING REMARKS	SIGN LEGEND	NEW SIGNS		EXISTING SIGNS				EXIST POST		NUMBER OF NEW POSTS	SQUARE STEEL (IN)			TUBULAR STEEL Ø (IN)				SIGN FRAME REQUIRED	REMARKS	SIGN DETAIL LOCATION			
								"A"	"B"	RETAIN	SALVAGE FROM	SALVAGE TO	REMOVE	RETAIN	REMOVE		1.75	2.00	2.50	3.00	3.50	4.00	5.00			SHSM	PROJECT SHEET #	STANDARD SHEET #	
																	(LB / FT)			(LB / FT)									
HARTLAND SB							FY-FLUORESCENT YELLOW FYG-FLUORESCENT YELLOW GREEN																"SHSM"-STANDARD HIGHWAY SIGNS AND MARKINGS						
							(THIS LINE INTENTIONALLY LEFT BLANK)																						
SB	7.232	F	W1-5R	30	30		WINDING CURVES RIGHT SYMBOL																						
		F	W13-1P	18	18		40 MPH (PLAQUE)																						
SB	7.190	F	R2-5A	24	30		REDUCED SPEED AHEAD																					REFERENCE THIS LOCATION FOR THE NEXT SIGN	
SB	7.170	F	W3-5	36	36			9.00																				INSTALL 100 FT± SOUTH OF THE REDUCED SPEED AHEAD SIGN REMOVAL AT MP 7.190	
SB	7.133	F	VD-062AS	72	16		BUSINESS DIRECTIONAL SIGN			1																		NORTH HARTLAND LAKE	
SB	7.025	F	R2-1	24	30																								
		F	R2-1	30	36			7.50																				NOTE: FIRST SIGN IN THE REDUCED SPEED ZONE IS LARGER	
SB	6.975	F	VD-018	30	18																							EXISTING SIGN AND POST ARE MISSING	
		F	VD-018	30	18			3.75																				INSTALL 265 FT± SOUTH OF THE SPEED LIMIT 35 SIGN AT MP 7.025	
SB	6.906	F	VW-619	36	36		SHOULDER NARROWS																						
		F	unknown	12	18		NEIGHBORHOOD WATCH																						
		F	VW-619	36	36			9.00																				8	
SB	6.813	F	W11-2	30	30		PEDESTRIAN SYMBOL																						
		F	R2-1	24	30			5.00																				X	
SIGN SUMMARY SHEET							SHEET TOTALS	34.25	0.00	1	0	0	7	0	0	7	105.0	0	0.0	0.0	0.0	0.0	0.0	PROJECT NAME: SPRINGFIELD-HARTFORD					
								SF	SF	EA	EA	EA	EA	EA	EA	EA	FT	EA	LB	LB	LB	LB	PROJECT NUMBER: STPG SIGN(33)						
VERMONT AGENCY OF TRANSPORTATION							TOWN DIRECTIONAL TOTALS	487.9	0.0	62	0	0	97	0	0	69	1035.0	0		0.0			FILE NAME: HARTLAND US-5 SB	PLOT DATE: 2/14/2012					
																						PROJECT MANAGER: A. GAMBLE	DRAWN BY: M. MILLER						
																						DESIGNED BY: M. MILLER	CHECKED: A. GAMBLE						
																						HARTLAND US-5 SB 1	SHEET 132 OF 162						