






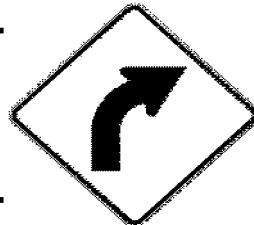

DIRECTION	MILEPOINT	LOCATION CODE (SHEET 2)	SIGN CODE	WIDTH (IN)	HEIGHT (IN)	SHEETING REMARKS	SIGN LEGEND	NEW SIGNS		EXISTING SIGNS				EXIST POST		NUMBER OF NEW POSTS	SQUARE STEEL (IN)			TUBULAR STEEL Ø (IN)				SIGN FRAME REQUIRED	REMARKS	SIGN DETAIL LOCATION			
								"A"	"B"	RETAIN	SALVAGE FROM	SALVAGE TO	REMOVE	RETAIN	REMOVE		1.75	2.00	2.50	FOUNDATION	3.00	3.50	4.00			5.00	SHSM	PROJECT SHEET #	STANDARD SHEET #
																	(LB / FT)				(LB / FT)								
<b>HARTFORD NB</b>							FY-FLUORESCENT YELLOW FYG-FLUORESCENT YELLOW GREEN																"SHSM"-STANDARD HIGHWAY SIGNS AND MARKINGS						
NB	0.304	A	W1-2R	30	30		CURVE RIGHT																	TO BE REPLACED FURTHER NORTH AT MP 0.334					
		A	W13-1P	18	18		40-MPH (PLAQUE)																	(ADVISORY SPEED PLAQUE WILL NOT BE REPLACED)					
NB	0.334	A	W1-2R	30	30			6.25																INSTALL 160 FT± NORTH OF THE PREVIOUS POSITION AT MP 0.304	X				
NB	0.384	A	VW-081R	30	30		TRUCKS ENTERING RIGHT																	REFERENCE THIS LOCATION FOR THE NEXT ASSEMBLY					
NB	0.395	A	VW-205	36	36	FY		9.00																INSTALL 60 FT± NORTH OF THE REMOVED "TRUCKS ENTERING RIGHT" SIGN. FLUORESCENT YELLOW SHEETING (THIS LOCATION ONLY)			E-154		
NB	0.477	A	W1-4R	30	30		RIGHT REVERSE CURVE																	TO BE REPLACED FURTHER NORTH AT MP 0.528					
		A	W13-1P	18	18		40-MPH (PLAQUE)																	(ADVISORY SPEED PLAQUE WILL NOT BE REPLACED)					
NB	0.528	A	W1-4R	30	30			6.25																INSTALL 270 FT± NORTH OF THE PREVIOUS POSITION AT MP 0.477	X				
NB	1.157	C	VR-017	24	30																			DREW RD (TH-76)					
		C	VR-017	24	30			5.00																		6			
NB	1.163	D	R1-1	30	30		 <b>DREW RD</b> <b>DEAD END STREET</b>																	DREW RD (TH-76)					
		D	R1-1	30	30		 <b>0050 1408 0116</b>	6.25																	X				
NB	1.201	A	W1-4R	30	30		RIGHT REVERSE CURVE																	TO BE REPLACED FURTHER NORTH AT MP 1.239					
NB	1.239	A	W1-4R	30	30			6.25																INSTALL <sup>180</sup> 200 FT± NORTH OF THE PREVIOUS POSITION AT MP 1.201	X				
NB	1.304	A	VW-054	30	30		HIDDEN DRIVE RIGHT (CONT. ON NEXT PAGE)																						
<b>SIGN SUMMARY SHEET</b>							<b>SHEET TOTALS</b>	39.00	0.00	0	3	3	12	0	0	7	105.0	0	0.0	0.0	0.0	0.0	0.0	0.0	PROJECT NAME: <b>SPRINGFIELD-HARTFORD</b>	PROJECT NUMBER: <b>STPG SIGN(33)</b>			
VERMONT AGENCY OF TRANSPORTATION							<b>TOWN DIRECTIONAL TOTALS</b>	91.0	0.0	10	2	2	27	0	0	19	285.0	0			0.0				FILE NAME: <b>HARTFORD US-6 NB</b>	2/14/2012	DRAWN BY: <b>M. MILLER</b>		
																								DESIGNED BY: <b>M. MILLER</b>		CHECKED: <b>A. GAMBLE</b>			
																									HARTFORD US-5 NB 2		SHEET <b>152</b> OF <b>162</b>		