
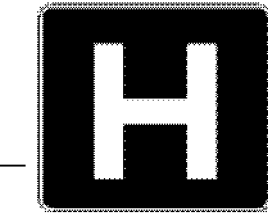




DIRECTION	MILEPOINT	LOCATION CODE (SHEET 2)	SIGN CODE	WIDTH (IN)	HEIGHT (IN)	SHEETING REMARKS	SIGN LEGEND	NEW SIGNS		EXISTING SIGNS				EXIST POST		NUMBER OF NEW POSTS	SQUARE STEEL (IN)			TUBULAR STEEL Ø (IN)				SIGN FRAME REQUIRED	REMARKS	SIGN DETAIL LOCATION			
								"A"	"B"	RETAIN	SALVAGE FROM	SALVAGE TO	REMOVE	RETAIN	REMOVE		1.75	2.00	2.50	FOUNDATION	3.00	3.50	4.00			5.00	SHSM	PROJECT SHEET #	STANDARD SHEET #
																	(LB / FT)				(LB / FT)								
HARTFORD NB							FY-FLUORESCENT YELLOW FYG-FLUORESCENT YELLOW GREEN															"SHSM"-STANDARD HIGHWAY SIGNS AND MARKINGS							
NB	2.625	A	R2-1	24	30			5.00							1		X							INSTALL IN THE SAME POSITION AS THE REMOVED HOSPITAL SIGN WITH SKINNY LEFT ARROW	X				
NB	2.665	A	R2-1	24	30		SPEED LIMIT 40																						
		A	D9-2	24	30			4.00							1		X							PROVIDE MINIMUM 5-10 FT SPACE TO UTILITY POLE	X				
		A	M6-1L	21	15			2.19																WHITE ON BLUE; LEFT ARROW	X				
NB	2.693	C	M4-5	24	12		TO																	REMOVE ALL; THIS ASSEMBLY FACES THE EXIT DRIVE FROM THE VA HOSPITAL					
		C	M1-1	24	24		INTERSTATE 91																						
		C	M6-1L	21	15		LEFT ARROW																						
		C	M4-5	24	12		TO																						
		C	M1-1	24	24		INTERSTATE 89																						
		C	M6-1L	21	15		LEFT ARROW																						
NB	2.696	A	M2-1	24	12		JCT			1	1													BOTH OF THESE SIGNS TO BE SALVAGED 40 FT± NORTH TO MP 2.704					
		A	M1-1	24	24		INTERSTATE 91			1																			
NB	2.704	A	M2-1	21	15		JCT				1				1		X						#1	SALVAGE THE "JCT I-91" SIGNS ONTO A NEW POST; THIS WILL BE THE LEFT SIDE-POST (SEE NEXT ENTRIES)					
		A	M1-1	24	24		INTERSTATE 91				1													INSTALL THE NEW ASSEMBLY 40 FT± NORTH OF THE PREVIOUS POSITION AT MP 2.696					
		A	M4-5	24	12		 (CONT. ON NEXT PAGE)	2.00							1		X							WHITE ON BLUE "TO"; INSTALL ON TOP OF NEW RIGHT-SIDE POST NEXT TO SALVAGED JCT I-91 SIGNS; BRACE POSTS WITH NEW SIGN FRAME	X				
SIGN SUMMARY SHEET							SHEET TOTALS	13.19	0.00	0	2	2	9	0	0	4	60.0	0	0.0	0.0	0.0	0.0	PROJECT NAME: SPRINGFIELD-HARTFORD						
								SF	SF	EA	EA	EA	EA	EA	EA	EA	FT	EA	LB	LB	LB	PROJECT NUMBER: STPG SIGN(33)							
VERMONT AGENCY OF TRANSPORTATION							TOWN DIRECTIONAL TOTALS	91.0	0.0	10	2	2	27	0	0	19	285.0	0		0.0		FILE NAME: HARTFORD US-6 NB	PLOT DATE: 2/14/2012						
																					PROJECT MANAGER: A. GAMBLE	DRAWN BY: M. MILLER							
																					DESIGNED BY: M. MILLER	CHECKED: A. GAMBLE							
																					HARTFORD US-5 NB 4	SHEET 154 OF 162							