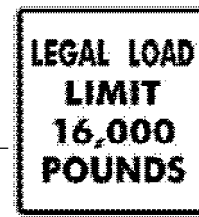


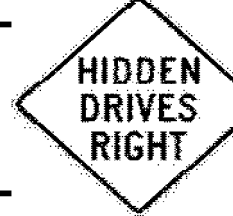
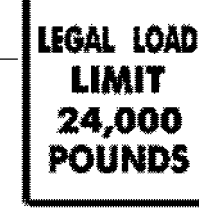




DIRECTION	MILEPOINT	LOCATION CODE (SHEET 2)	SIGN CODE	WIDTH (IN)	HEIGHT (IN)	SHEETING REMARKS	SIGN LEGEND	NEW SIGNS		EXISTING SIGNS				EXIST POST		NUMBER OF NEW POSTS	SQUARE STEEL (IN)			TUBULAR STEEL Ø (IN)				SIGN FRAME REQUIRED	REMARKS	SIGN DETAIL LOCATION			
								"A"	"B"	RETAIN	SALVAGE FROM	SALVAGE TO	REMOVE	RETAIN	REMOVE		1.75	2.00	2.50	FOUNDATION	3.00	3.50	4.00			5.00	SHSM	PROJECT SHEET #	STANDARD SHEET #
																	(LB / FT)				(LB / FT)								
<b>HARTFORD SB</b>							FY-FLUORESCENT YELLOW FYG-FLUORESCENT YELLOW GREEN															"SHSM"-STANDARD HIGHWAY SIGNS AND MARKINGS							
SB	2.402	G	VR-017	24	30		 (CONT.)	5.00										X										6	
		G	unknown	18	18		HURRICANE FOREST WILDLIFE REFUGE PARK					1																	
SB	2.394	H	R1-1	24	24					1	1	1																	
		H	R1-1	30	30			6.25				1						X								X			
SB	2.372	F	VR-921L	30	30		LEFT "ONLY" / RIGHT THROUGH LANE SYMBOL			1																			
SB	2.354	F	R2-1	24	30		SPEED LIMIT 40			1																			
SB	2.309	F	VD-062B	72	16		BUSINESS DIRECTIONAL SIGN			1																			
SB	2.275	F	VW-054	30	30		HIDDEN DRIVES RIGHT					1																	
SB	2.241	F	VW-054	30	30			6.25										X										E-154	
SB	2.107	F	R2-1	24	30		SPEED LIMIT 40			1																			
SB	2.000	G	VR-017	24	30							1																	
		G	VR-017	24	30			5.00										X										6	
SB	1.992	H	R1-1	30	30		  STOP			1	3	3	3	*	X														
SB	1.862	F	VW-205	36	36		WATCH FOR TURNING VEHICLES			1																			
SB	1.654	F	W16-18P	24	12		STATE LAW (TOP PLAQUE) (CONT. ON NEXT PAGE)			1																			
<b>SIGN SUMMARY SHEET</b>							<b>SHEET TOTALS</b>	22.50	0.00	7	4	6	7	0	0	4	60.0	0	0.0	0.0	0.0	0.0	PROJECT NAME: <b>SPRINGFIELD-HARTFORD</b>						
								SF	SF	EA	EA	EA	EA	EA	EA	EA	FT	EA	LB	LB	LB	LB	PROJECT NUMBER: <b>STPG SIGN(33)</b>						
VERMONT AGENCY OF TRANSPORTATION							<b>TOWN DIRECTIONAL TOTALS</b>	144.5	0.0	17	2	2	28	0	0	27	405.0	0		0.0			FILE NAME: <b>HARTFORD US-6 SB</b>						
																						PLOT DATE: <b>2/14/2012</b>							
																						DRAWN BY: <b>M. MILLER</b>							
																						CHECKED: <b>A. GAMBLE</b>							
																						SHEET <b>158</b> OF <b>162</b>							