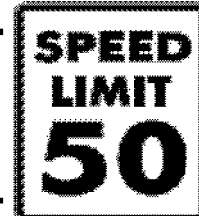

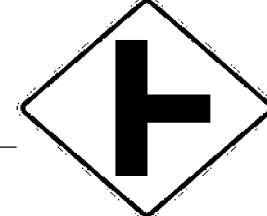
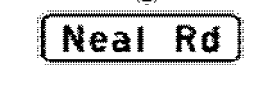



DIRECTION	MILEPOINT	LOCATION CODE (SHEET 2)	SIGN CODE	WIDTH (IN)	HEIGHT (IN)	SHEETING REMARKS	SIGN LEGEND	NEW SIGNS		EXISTING SIGNS				EXIST POST		NUMBER OF NEW POSTS	SQUARE STEEL (IN)			TUBULAR STEEL Ø (IN)				SIGN FRAME REQUIRED	REMARKS	SIGN DETAIL LOCATION			
								"A"	"B"	RETAIN	SALVAGE FROM	SALVAGE TO	REMOVE	RETAIN	REMOVE		1.75	2.00	2.50	FOUNDATION	3.00	3.50	4.00			5.00	SHSM	PROJECT SHEET #	STANDARD SHEET #
																	(LB / FT)				(LB / FT)								
HARTFORD SB							FY-FLUORESCENT YELLOW FYG-FLUORESCENT YELLOW GREEN															"SHSM"-STANDARD HIGHWAY SIGNS AND MARKINGS							
SB	1.654	F	R2-1	24	30		SPEED LIMIT 50 (CONT.)			1														ALL INSTALLED IN 2012					
		F	R2-5P	24	24		UNLESS OTHERWISE POSTED (BOTTOM PLAQUE)			1																			
SB	1.530	F	W1-4L	30	30		LEFT REVERSE CURVE SYMBOL			1			X											INSTALLED IN 2012					
SB	1.417	F	VW-054	30	30		HIDDEN DRIVES RIGHT			1			X											INSTALLED IN 2012					
SB	1.267	F	S3-1	30	30		SCHOOL BUS STOP AHEAD							1		X								SIGN NO LONGER WARRANTED; REFERENCE THIS LOCATION FOR THE NEXT ASSEMBLY					
SB	1.232	F	R2-1	24	30			5.00									1	X						INSTALL 185 FT± SOUTH OF THE SCHOOL BUS STOP AHEAD SIGN REMOVAL AT MP 1.267	X				
SB	0.706	F	W1-4R	30	30		RIGHT REVERSE CURVE							1		X													
		F	W13-1P	18	18		40-MPH PLAQUE																	THIS SIGN WILL NOT BE REPLACED					
		F	W1-4R	30	30			6.25									1	X							X				
SB	0.679	F	W2-2R	30	30		RIGHT SIDE ROAD SYMBOL							1		X								KEEP SAME LOCATION 0.679 TO BE REPLACED FURTHER SOUTH AT MP 0.660					
SB	0.679 0.660	F	W2-2R	30	30			6.25									1	X						INSTALL ^{AT} 100 FT± SOUTH OF THE PREVIOUS LOCATION AT MP 0.679	X				
		F	W16-8P	24	8		Neal Rd	1.33																		9			
SB	0.610	F	VW-081L	30	30		TRUCKS ENTERING LEFT							1		X													
SB	0.608	F	VW-205	36	36			9.00																INSTALL 10 FT± SOUTH OF THE REMOVED "TRUCKS ENTERING LEFT" SIGN			E-154		
SB	0.586	G	VR-017	24	24		LEGAL LOAD LIMIT 24,000 POUNDS (CONT. ON NEXT PAGE)																						
SIGN SUMMARY SHEET							SHEET TOTALS	27.83	0.00	4	0	0	7	0	0	5	75.0	0	0.0	0.0	0.0	0.0	PROJECT NAME: SPRINGFIELD-HARTFORD						
								SF	SF	EA	EA	EA	EA	EA	EA	EA	FT	EA	LB	LB	LB	PROJECT NUMBER: STPG SIGN(33)							
VERMONT AGENCY OF TRANSPORTATION							TOWN DIRECTIONAL TOTALS	144.5	0.0	17	2	2	28	0	0	27	405.0	0		0.0		FILE NAME: HARTFORD US-6 SB	PLOT DATE: 2/14/2012						
																					PROJECT MANAGER: A. GAMBLE	DRAWN BY: M. MILLER							
																					DESIGNED BY: M. MILLER	CHECKED: A. GAMBLE							
																					HARTFORD US-5 SB 4	SHEET 159 OF 162							