

INDEX OF SHEETS  
SEE SHEET 2

# STATE OF VERMONT AGENCY OF TRANSPORTATION



## PROPOSED IMPROVEMENT




### TOWNS OF NORWICH, THETFORD, AND FAIRLEE COUNTIES OF WINDSOR AND ORANGE U.S. ROUTE 5

NORTHEAST REGION SIGN REPLACEMENT:  
NORWICH MP 2.448-8.290, THETFORD MP 0.000-7.680,  
FAIRLEE MP 0.000-7.278  
LENGTH OF ROADWAY = 20.800 MILES  
LENGTH OF PROJECT = 20.800 MILES

WORK TO BE PERFORMED UNDER THIS PROJECT INCLUDES THE REMOVAL OF EXISTING SIGNS AND POSTS  
AND THE INSTALLATION OF NEW SIGNS AND SIGN POSTS AND INCIDENTAL ITEMS.

#### PROJECT LOCATION

NORWICH - FAIRLEE  
STPG SIGN(34)

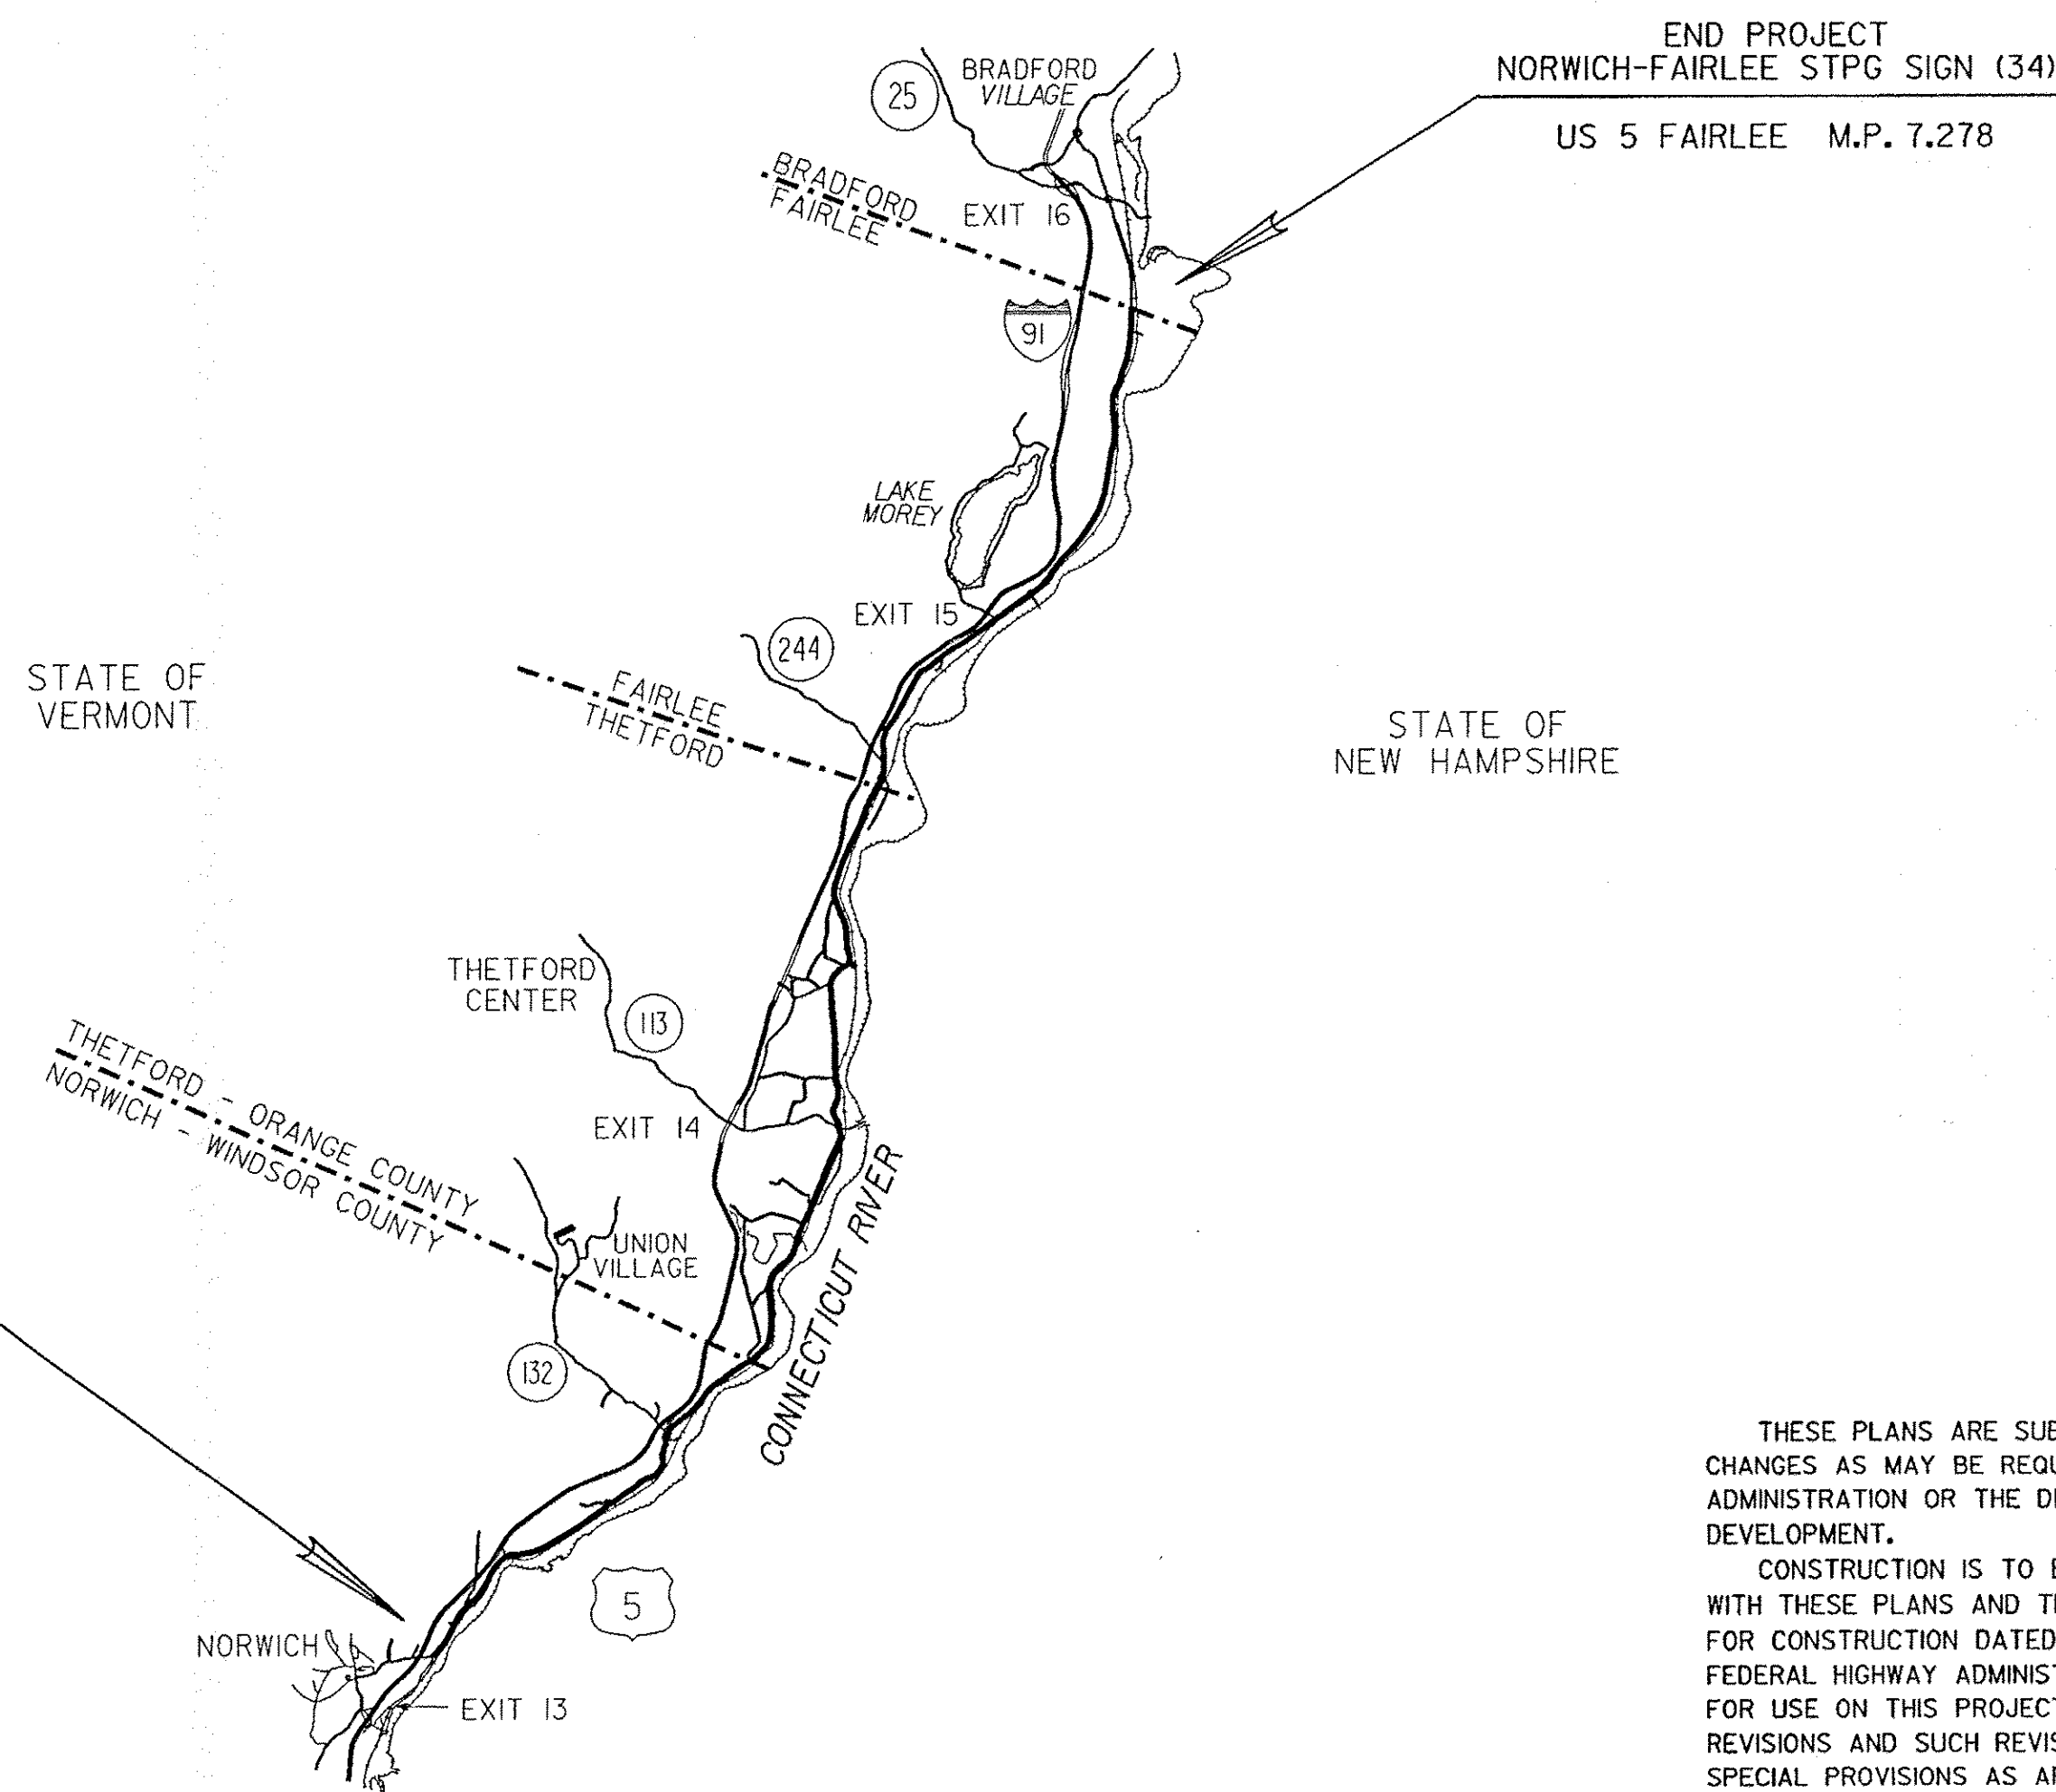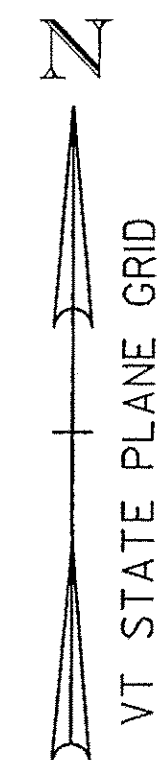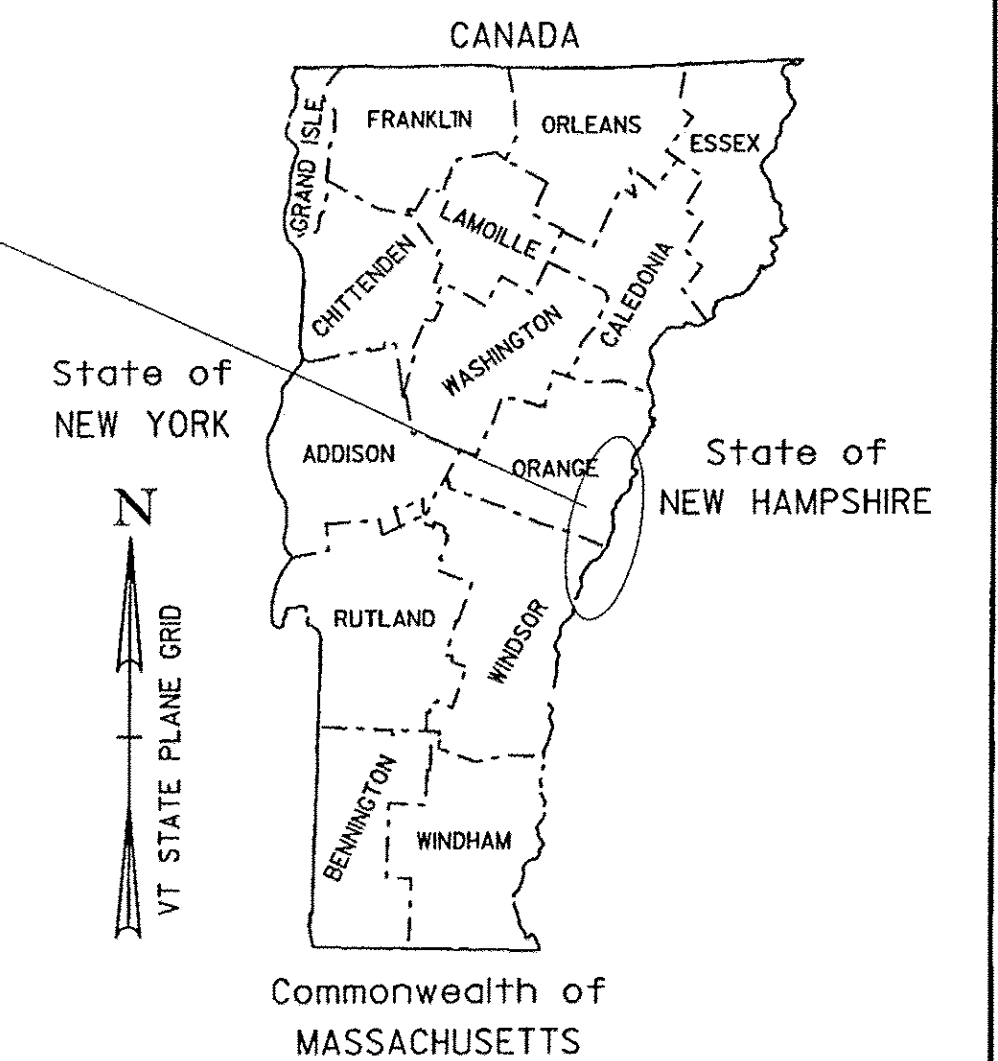

RECORD PLANS	
CONTRACTOR:	F. R. LAFAYETTE, INC. - ESSEX JUNCTION, VT
RESIDENT ENGINEER:	M. HAUGHWOUT
CONSTRUCTION BEGAN:	AUGUST 3, 2011
CONSTRUCTION COMPLETE:	OCTOBER 11, 2011
RECORD PLANS BY:	M. HAUGHWOUT & JENNA HYDE
I HEREBY CERTIFY THAT ALL THE CONSTRUCTION REQUIRED BY THIS SET OF DRAWINGS HAS BEEN ACCOMPLISHED AS INDICATED HEREIN.	
BY:	<i>Mark W. Haughwout</i> RESIDENT ENGINEER
DATE:	11/7/12
NOTE: Any further information concerning final quantities, amounts or other details relative to this project may be found at Central Files in the electronic archives.	

QUALITY ASSURANCE PROGRAM: LEVEL 3

CONVENTIONAL SYMBOLS	
COUNTY LINE	
TOWN LINE	
LIMITS OF ACCESS	
POINT OF ACCESS	
FENCE LINE	
STONE WALL	
TRAVELED WAY	
GUARD RAIL	
RAILROAD	
SURVEY LINE	
CULVERT	
POWER POLE	
TELEPHONE POLE	
TREES	
CONTROL OF ACCESS	
PROPERTY LINE	
R.O.W. TAKING LINE	
SLOPE RIGHTS	
TOP OF CUT	
TOE OF SLOPE	

SURVEYED BY :	N/A
SURVEYED DATE :	N/A
DATUM	
VERTICAL	N/A
HORIZONTAL	N/A

NOT TO SCALE

THESE PLANS ARE SUBJECT TO SUCH ENGINEERING CHANGES AS MAY BE REQUIRED BY THE FEDERAL HIGHWAY ADMINISTRATION OR THE DIRECTOR OF PROGRAM DEVELOPMENT.  
CONSTRUCTION IS TO BE CARRIED ON IN ACCORDANCE WITH THESE PLANS AND THE STANDARD SPECIFICATIONS FOR CONSTRUCTION DATED 2006, AS APPROVED BY THE FEDERAL HIGHWAY ADMINISTRATION ON JUNE 15, 2006 FOR USE ON THIS PROJECT, INCLUDING ALL SUBSEQUENT REVISIONS AND SUCH REVISED SPECIFICATIONS AND SPECIAL PROVISIONS AS ARE INCORPORATED IN THESE PLANS.

DIRECTOR OF PROGRAM DEVELOPMENT	
APPROVED <i>Jan V. Rely</i>	DATE 5-5-2011
PROJECT MANAGER :	AMY GAMBLE
PROJECT NAME :	NORWICH - FAIRLEE
PROJECT NUMBER :	STPG SIGN (34)
SHEET 1 OF 65 SHEETS	