


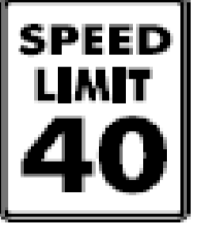


DIRECTION	MILEPOINT	LOCATION CODE (SHEET 2)	SIGN CODE	WIDTH (IN)	HEIGHT (IN)	SHEETING REMARKS	SIGN LEGEND	NEW SIGNS		EXISTING SIGNS				EXIST POST		NUMBER OF NEW SQUARE STEEL POSTS	SQUARE STEEL (IN)			TUBULAR STEEL Ø (IN)				SIGN FRAME REQUIRED	REMARKS	SIGN DETAIL LOCATIONS			
								"A"	"B"	RETAIN	SALVAGE FROM	SALVAGE TO	REMOVE	RETAIN	REMOVE		1.75	2.00	2.50	FOUNDATION	3.00	3.50	4.00			5.00	SHSM	PROJECT SHEET #	STANDARD SHEET #
																	(LB / FT)				(LB / FT)								
<b>NORWICH US 5 NB</b>							FY-FLUORESCENT YELLOW FYG-FLUORESCENT YELLOW GREEN															"SHSM"-STANDARD HIGHWAY SIGNS AND MARKINGS							
NB	2.462	A	M3-1	24	12		NORTH	2.00		4					X										OLD SIGN WAS DAMAGED. CONTRACTOR INSTALLED A NEW SIGN.				
		A	M1-4	24	24		US 5			1																			
NB	2.480	A	R2-1	24	30																								
		A	R2-1	24	30			5.00																					
NB	2.592	A	VW-285	30	30		FALLING ROCK			1																			
NB	2.670	A	R2-1	24	30																								
		A	W16-18P	24	12	FY		2.00																					
		A	R2-1	24	30			5.00																					
		A	R2-5P	24	18			3.00																					
NB	2.880	A	VR-114F	48	60		SL 50 UNLESS OTHERWISE POSTED																						
NB	2.980	A	VD-062AL	72	16		BUSINESS SIGN			1																			
NB	3.420	A	VW-285	30	30																								
		A	VW-285	30	30			6.25																					
NB	3.760	A	VW-054	30	30																								
		A	VW-054	30	30			6.25																					
<b>SIGN SUMMARY SHEET</b>							SHEET TOTALS	29.50 27.50	0.00	4	0	0	6 5	0	0	4	60	0	0.0	0.0	0.0	0.0	PROJECT NAME: NORWICH - FAIRLEE PROJECT NUMBER: STPG SIGN (34)						
VERMONT AGENCY OF TRANSPORTATION							TOWN DIRECTIONAL TOTALS	128.2	0.0	6.0	0.0	0.0	31	0.0	0.0	16	240.0	0	0.0	0.0	0.0	FILE NAME: 10C334 PROJECT MANAGER: A.GAMBLE DESIGNED BY: D.CROSSLEY NORWICH U.S. 5 NORTHBOUND 1							
										EA	EA	EA	EA	EA	EA	EA	EA	EA	EA	EA	EA	PLOT DATE: 5/2/2011 DRAWN BY: D.CROSSLEY CHECKED BY: QAU SHEET 8 OF 65							