
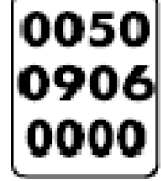
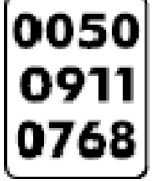




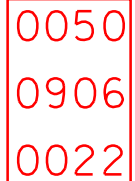



DIRECTION	MILEPOINT	LOCATION CODE (SHEET 2)	SIGN CODE	WIDTH (IN)	HEIGHT (IN)	SHEETING REMARKS	SIGN LEGEND	NEW SIGNS		EXISTING SIGNS				EXIST POST		NUMBER OF NEW SQUARE STEEL POSTS	SQUARE STEEL (IN)			TUBULAR STEEL Ø (IN)				SIGN FRAME REQUIRED	REMARKS	SIGN DETAIL LOCATION		
								"A"	"B"	RETAIN	SALVAGE FROM	SALVAGE TO	REMOVE	RETAIN	REMOVE		1.75	2.00	2.50	3.00	3.50	4.00	5.00			SHSM	PROJECT SHEET NUMBER	STANDARD SHEET NUMBER
																	(LB / FT)			(LB / FT)								
FAIRLEE US 5 NB							FY-FLUORESCENT YELLOW FYG-FLUORESCENT YELLOW GREEN															"SHSM"-STANDARD HIGHWAY SIGNS AND MARKINGS						
NB	0.000	C	VD-024	72	10		FAIRLEE/THETFORD																					
		C	VD-700	6	10		2 - MILE MARKERS																					
		C	VD-024	72	10 12			5.00 6.00																		4		
		C	VD-700	6	10		 	0.42																			E-138	
		C	VD-700	6	10			0.42																			E-138	
NB	0.020	A	W10-3R	36	36		RAILROAD CROSSING			1																		
NB	0.060	A	VD-018	30	18																							
		A	VD-018	30	18			3.75																		5		
NB	0.095	C	VR-017	24	30			5.00																		ELY RD TH-2		
NB	0.100	E	VR-017	24	24		LLL, 2400																				ELY RD TH-2	
NB	0.100	D	R1-1	30	30		 																				ELY RD TH-2	
		D	R1-1	30	30			6.25		1	1	1														WITH STREET SIGN		
NB	0.220	A	M2-1	21	15																							
		A	M1-5A	30	24																							
		A	M2-1	21	15			2.19		1	1	1															GREEN ON WHITE	
SIGN SUMMARY SHEET							SHEET TOTALS	23.03 24.03	0.00	1	2 0	2 0	10 8	0	0	6	90	0	0	0	0	0	PROJECT NAME: NORWICH - FAIRLEE PROJECT NUMBER: STPG SIGN (34)					
VERMONT AGENCY OF TRANSPORTATION							TOWN DIRECTIONAL TOTALS	343.6	0.0	9.0	4.0	4.0	90	0.0	0.0	51	765.0	0		0.0			FILE NAME: 10C334 PLOT DATE: 5/2/2011 PROJECT MANAGER: A.GAMBLE DRAWN BY: D.CROSSLEY DESIGNED BY: D.CROSSLEY CHECKED BY: QAU FAIRLEE US 5 NORTHBOUND 1 SHEET 40 OF 65					