


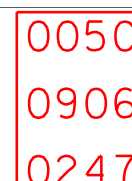







DIRECTION	MILEPOINT	LOCATION CODE (SHEET 2)	SIGN CODE	WIDTH (IN)	HEIGHT (IN)	SHEETING REMARKS	SIGN LEGEND	NEW SIGNS		EXISTING SIGNS				EXIST POST		NUMBER OF NEW SQUARE STEEL POSTS	SQUARE STEEL (IN)			TUBULAR STEEL Ø (IN)				SIGN FRAME REQUIRED	REMARKS	SIGN DETAIL LOCATION			
								"A"	"B"	RETAIN	SALVAGE FROM	SALVAGE TO	REMOVE	RETAIN	REMOVE		1.75	2.00	2.50	FOUNDATION	3.00	3.50	4.00			5.00	SHSM	PROJECT SHEET #	STANDARD SHEET #
																	(LB / FT)				(LB / FT)								
<b>FAIRLEE US 5 SB</b>							FY-FLUORESCENT YELLOW FYC-FLUORESCENT YELLOW GREEN																"SHS"-STANDARD HIGHWAY SIGNS AND MARKINGS						
		G	VR-017	24	30			5.00							1		X										E-141		
SB	2.462	H	R1-1	24	24								1		X														
		H	R1-1	30	30		 	6.25		2	2	2			1		X												
SB	2.460	F	R2-1	24	30							1		X															
		F	R2-1	24	30			5.00							1		X										X		
SB	2.310	F	VR-048	24	30		STATE LAW - STOP FOR -SCHOOL BUS -FLASHING - RED LIGHTS					1		X															
SB	2.220	F	R2-1	24	30							1		X															
		F	W16-18P	24	12	FY	  	2.00							1		X											5	
		F	R2-1	24	30			5.00																			X		
		F	R2-5P	24	18			3.00																			X		
SB	2.150	F	VR-023B	24	30		\$500 FINE FOR THROWING TRASH					1		X															
SB	1.595	F	VR-114	48	60		STATE OF VERMONT - SPEED - LIMIT - 50 UNLESS OTHERWISE - POSTED - RADAR ENFORCEMENT					1		X															
SB	1.200	F	VD-062B	72	16		BUSINESS SIGN			1	2	2	2		X														
SB	0.530	F	<sup>054L</sup> VW-060	30	30		HIDDEN DRIVE 	6.25		4			1		X														
SB	0.500	F	VD-018	30	18								1		X														
<b>SIGN SUMMARY SHEET</b>							SHEET TOTALS	32.50 <del>26.25</del>	0.00	2	<del>0</del>	<del>2</del>	<del>10</del>	7	0	0	4	60	0	0	0	0	0	PROJECT NAME: NORWICH - FAIRLEE PROJECT NUMBER: STPG SIGN (34)					
VERMONT AGENCY OF TRANSPORTATION							TOWN DIRECTIONAL TOTALS	341.0	0.0	7.0	5.0	5.0	94	0.0	0.0	45	675.0	4			364.8			FILE NAME: 10C334 PROJECT MANAGER: A.GAMBLE DESIGNED BY: D.CROSSLEY FAIRLEE US 5 SOUTHBOUND 10					
																								PLOT DATE: 5/2/2011 DRAWN BY: D.CROSSLEY CHECKED BY: QAU SHEET 61 OF 65					