


STATE OF VERMONT
AGENCY OF TRANSPORTATION

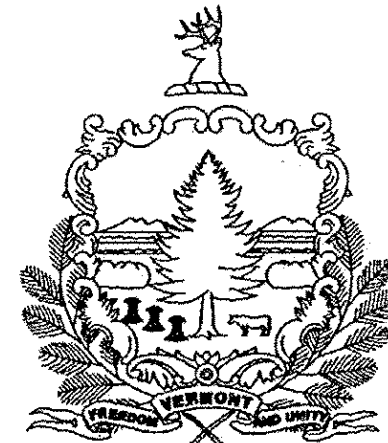

INDEX OF SHEETS
SEE SHEET 2


PROPOSED IMPROVEMENT
TOWNS OF PAWLET, DANBY, TINMOUTH,
MIDDLETOWN SPRINGS,
IRA, CLARENDON AND WEST RUTLAND
COUNTY OF RUTLAND
VERMONT ROUTE 133

SOUTHWEST REGION SIGN REPLACEMENT - 21.464 MILES:
PAWLET MP 0.000-5.325, DANBY MP 0.000-0.024, TINMOUTH MP 0.000-2.150,
MIDDLETOWN SPRINGS MP 0.000-5.975, TINMOUTH MP 2.150-3.216,
IRA MP 0.000-4.780, CLARENDON MP 0.000-1.434, WEST RUTLAND MP 0.000-0.710

LENGTH OF ROADWAY = 21.464 MILES
LENGTH OF PROJECT = 21.464 MILES

WORK TO BE PERFORMED UNDER THIS PROJECT INCLUDES THE REMOVAL OF EXISTING SIGNS AND POSTS
AND THE INSTALLATION OF NEW SIGNS AND SIGN POSTS AND INCIDENTAL ITEMS.

RECORD PLANS	
CONTRACTOR:	EMI GUIDE RAIL LLC- SCHENECTADY, NY
RESIDENT ENGINEER:	TIM POCKETTE
CONSTRUCTION BEGAN:	APRIL 16, 2012
CONSTRUCTION COMPLETE:	JULY 11, 2012
RECORD PLANS BY:	TIM POCKETTE & JENNA HYDE
I HEREBY CERTIFY THAT ALL THE CONSTRUCTION REQUIRED BY THIS SET OF DRAWINGS HAS BEEN ACCOMPLISHED AS INDICATED HEREIN.	
BY	RESIDENT ENGINEER
DATE 11-05-12	
NOTE: Any further information concerning final quantities, amounts or other details relative to this project may be found at Central Files in the electronic archives.	

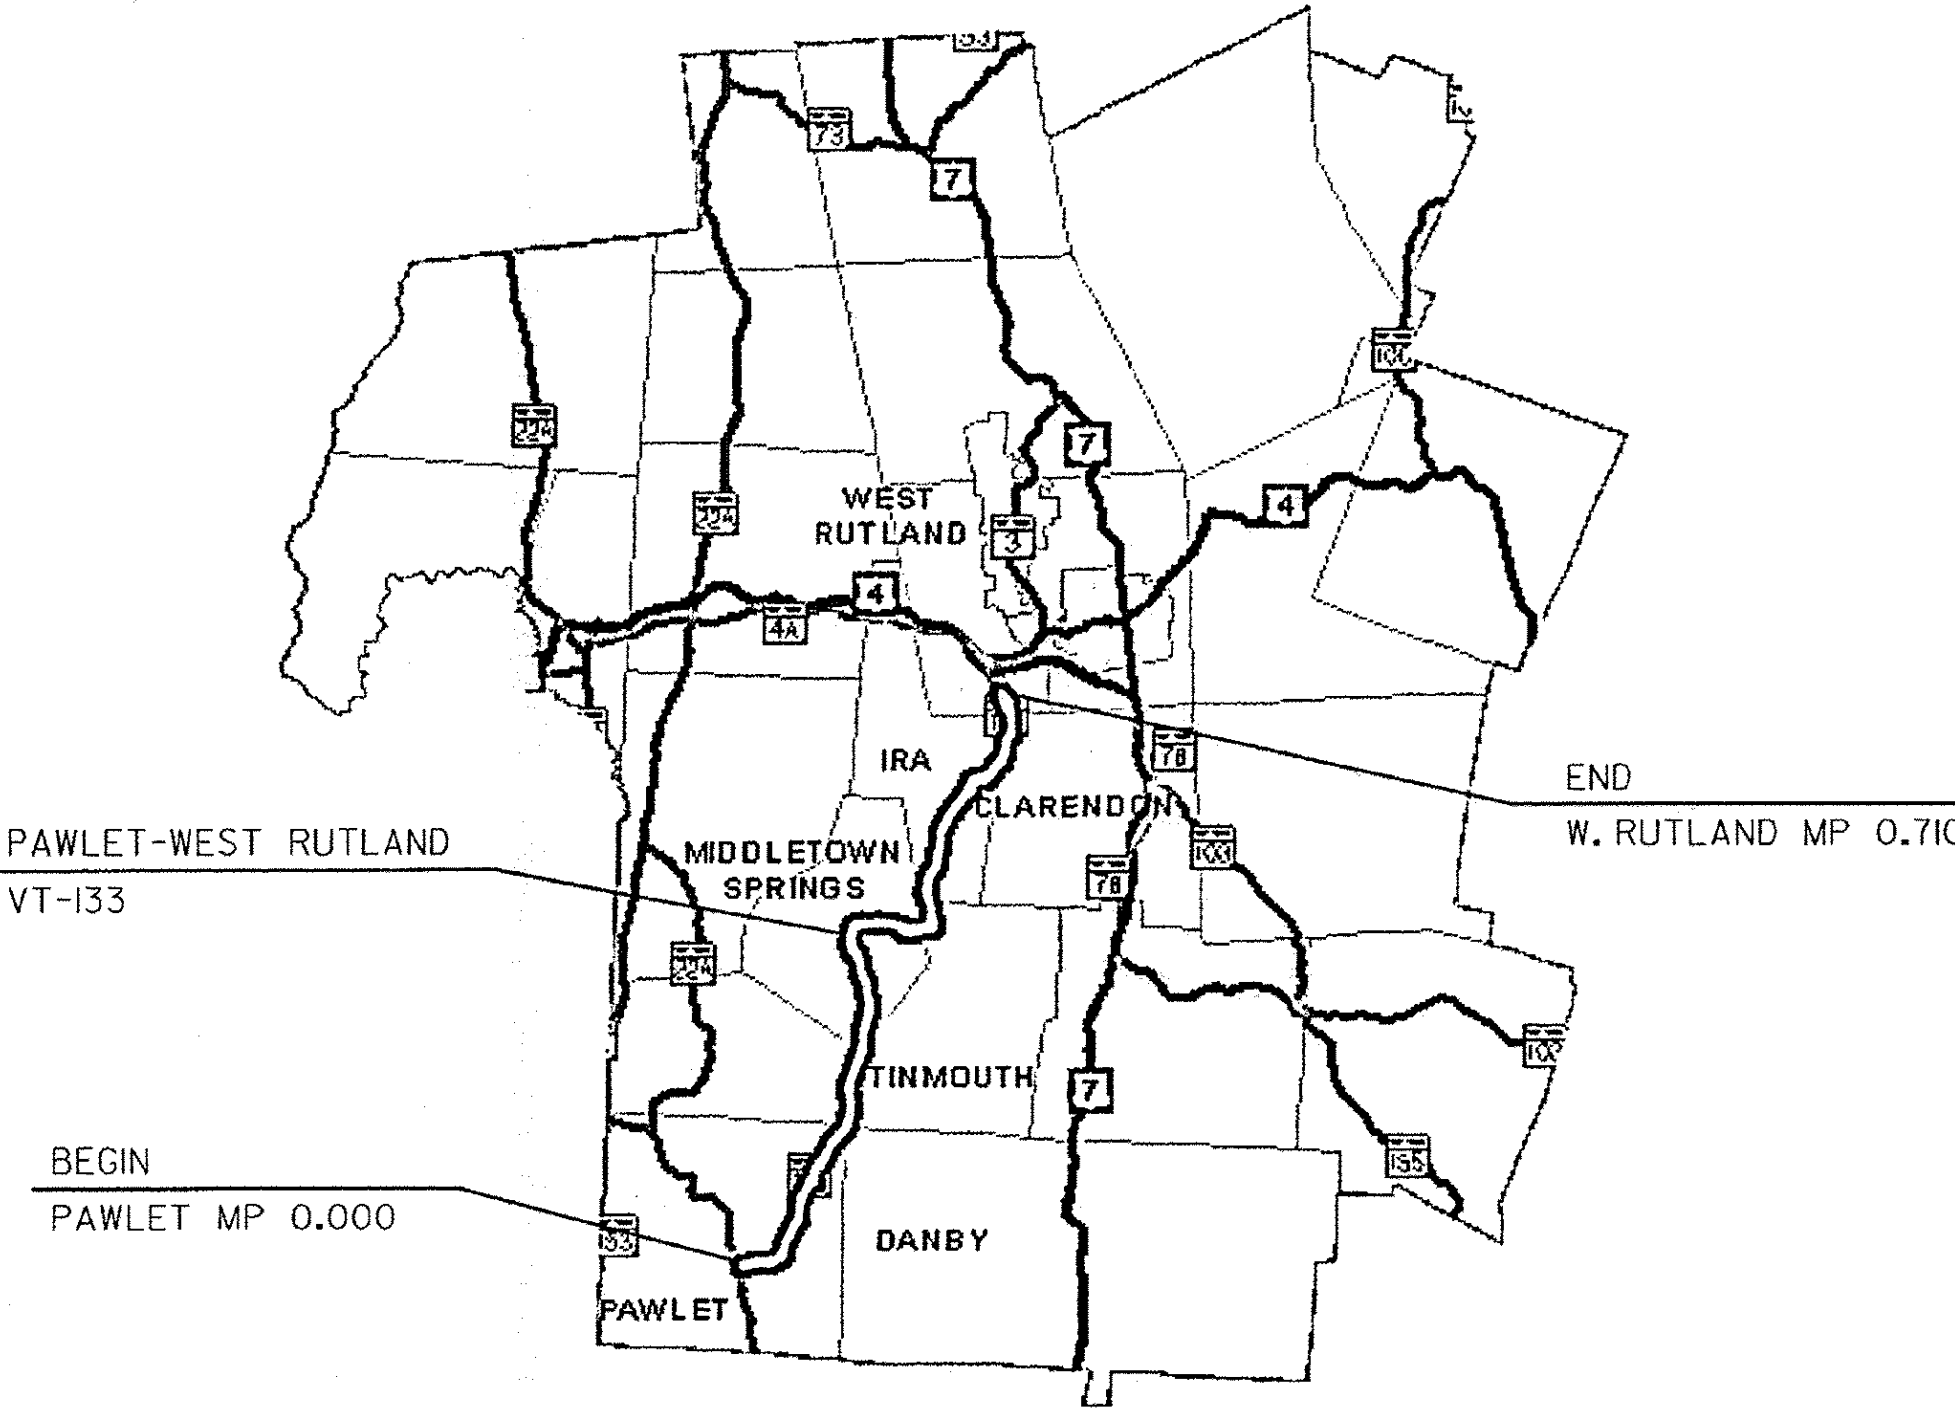

QUALITY ASSURANCE PROGRAM: LEVEL 3

CONVENTIONAL SYMBOLS

COUNTY LINE	
TOWN LINE	
LIMITS OF ACCESS	
POINT OF ACCESS	
FENCE LINE	
STONE WALL	
TRAVELED WAY	
GUARD RAIL	
RAILROAD	
SURVEY LINE	
CULVERT	
POWER POLE	
TELEPHONE POLE	
TREES	
CONTROL OF ACCESS	
PROPERTY LINE	
R.O.W. TAKING LINE	
SLOPE RIGHTS	
TOP OF CUT	
TOE OF SLOPE	

SURVEYED BY : N/A
SURVEYED DATE : N/A

DATUM
VERTICAL N/A
HORIZONTAL N/A

THESE PLANS ARE SUBJECT TO SUCH ENGINEERING CHANGES AS MAY BE REQUIRED BY THE FEDERAL HIGHWAY ADMINISTRATION OR THE DIRECTOR OF PROGRAM DEVELOPMENT.
CONSTRUCTION IS TO BE CARRIED ON IN ACCORDANCE WITH THESE PLANS AND THE STANDARD SPECIFICATIONS FOR CONSTRUCTION DATED 2006, AS APPROVED BY THE FEDERAL HIGHWAY ADMINISTRATION ON JUNE 15, 2006 FOR USE ON THIS PROJECT, INCLUDING ALL SUBSEQUENT REVISIONS AND SUCH REVISED SPECIFICATIONS AND SPECIAL PROVISIONS AS ARE INCORPORATED IN THESE PLANS.

DIRECTOR OF PROGRAM DEVELOPMENT	
APPROVED	DATE 5/9/11
PROJECT MANAGER : AMY GAMBLE	
PROJECT NAME : PAWLET - WEST RUTLAND	
PROJECT NUMBER : STPG SIGN (37)	
SHEET 1 OF 61 SHEETS	