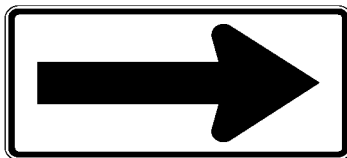
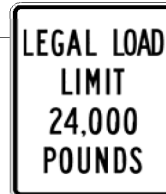
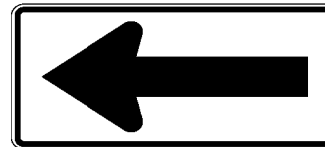


DIRECTION	MILEPOINT	LOCATION CODE (SHEET 2)	SIGN CODE	WIDTH (IN)	HEIGHT (IN)	SHEETING REMARKS	SIGN LEGEND	NEW SIGNS		EXISTING SIGNS				EXIST POST		NUMBER OF NEW POSTS	SQUARE STEEL (IN)			TUBULAR STEEL Ø (IN)				SIGN FRAME REQUIRED	REMARKS	SIGN DETAIL LOCATION			
								"A"	"B"	RETAIN	SALVAGE FROM	SALVAGE TO	REMOVE	RETAIN	REMOVE		1.75	2.00	2.50	FOUNDATION	3.00	3.50	4.00			5.00	SHSM	PROJECT SHEET #	STANDARD SHEET #
																	(LB / FT)				(LB / FT)								
																	1.88	2.42	3.35		7.60	9.00	10.80			14.60			
PAWLET NB						FY-FLUORESCENT YELLOW FYG-FLUORESCENT YELLOW GREEN																"SHSM"-STANDARD HIGHWAY SIGNS AND MARKINGS							
NB	1.300	B	W1-6R	48	24										X														
		B	W1-6R	48	24			8.00							2		X							INSTALL 10 FEET SOUTH OF CURRENT LOCATION.	X				
NB	1.300	C	VR-017	24	30		STOP - 18 B STOP - 18 A	6.25							I		X							DANBY/PAWLET RD	EXTRA	REMOVE AND ON #18A	SALVAGE		
		C	VR-017	24	30			6.25			I	I	24		X	I		X							INSTALL NORTH OF ISLAND ON TOWN HIGHWAY		6		
NB	1.310	A	W1-6L	48	24									1		X													
		A	W1-6L	48	24			8.00								2		X							REPLACE ASSEMBLY IN ISLAND.	X			
NB	1.310	D	R1-1	30	30		MILE MARKER																	DANBY/PAWLET RD					
		D	R1-1	30	30			6.25 5.25						1	X										REPLACE SIGN IN ISLAND. RETAIN POST.	X			
NB	1.310	C	VR-017	24	30		LEGAL LOAD 24,000 LBS							1		X									REMOVE ASSEMBLY FROM ISLAND.				
NB	1.320	D	R1-1	30	30									1	X										DANBY/PAWLET RD				
		D	R1-1	30	30			6.25																	REPLACE SIGN AND RETAIN POST.	X			
NB	1.355	A	M3-1	24	12			2.00								1		X							INSTALL 50 FEET NORTH OF DRIVE #1326.			E-136B	
			M1-5	30	24			5.00																			E-136B		
NB	1.580	A	S3-1	36	36			9.00								2		X							INSTALL ON SOUTH SIDE OF UTILITY POLE #16/43	X			
NB	2.320	A	W1-2L	30	30		LEFT CURVE							1		X													
SIGN SUMMARY SHEET							SHEET TOTALS		62.0 48.50	0.00	0	2 0	2 0	8 7	0	0	8	120.0			0	0.0	0.0	0.0	0.0	PROJECT NAME: PAWLET - WEST RUTLAND			
									SF	SF	EA	EA	EA	EA	EA	EA	EA	FT			EA	LB	LB	LB	LB	PROJECT NUMBER: STPG SIGN(37)			
							VERMONT AGENCY OF TRANSPORTATION		TOWN DIRECTIONAL TOTALS		233.8	0.0	4	4	4	50	0	0	39	585.0			0	0.0				FILE NAME: 10C340 PROJECT MANAGER: A. GAMBLE DESIGNED BY: J. KELLY PAWLET NB SHEET 4	