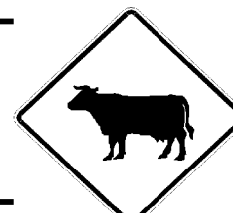


DIRECTION	MILEPOINT	LOCATION CODE (SHEET 2)	SIGN CODE	WIDTH (IN)	HEIGHT (IN)	SHEETING REMARKS	SIGN LEGEND	NEW SIGNS		EXISTING SIGNS				EXIST POST		NUMBER OF NEW POSTS	SQUARE STEEL (IN)			TUBULAR STEEL Ø (IN)					SIGN FRAME REQUIRED	REMARKS	SIGN DETAIL LOCATION		
								"A"	"B"	RETAIN	SALVAGE FROM	SALVAGE TO	REMOVE	RETAIN	REMOVE		1.75	2.00	2.50	FOUNDATION	3.00	3.50	4.00	5.00			SHSM	PROJECT SHEET #	STANDARD SHEET #
																	(LB / FT)				(LB / FT)								
																	1.88	2.42	3.35		7.60	9.00	10.80	14.60					
PAWLET NB						FY-FLUORESCENT YELLOW FYG-FLUORESCENT YELLOW GREEN																"SHSM"-STANDARD HIGHWAY SIGNS AND MARKINGS							
NB	2.710	C	VR-017	24	30								1		X								KELLEY HILL RD (TH-14)						
		C	VR-017	24	30			5.00						1		X								6					
		C		24	30			TOWN'S REDUCED SPEED AHEAD					1																
NB	2.715	D	R1-1	30	30								1	X									KELLEY HILL RD (TH-14)						
		D	R1-1	30	30			6.25															INSTALL NEW SIGN ON EXISTING POST.	X					
NB	2.910	A	W1-2R	30	30		RIGHT CURVE						1		X														
		A	W13-1	18	18		40 MPH ADVISORY						1																
NB	2.960	A	W1-2R	30	30			6.25								1		X					INSTALL 250 FEET NORTH OF EXISTING AND ON EDGE OF CEMETERY LAWN.	X					
		A	W13-1	18	18			2.25															THINNING AND TRIMMING	X					
NB	2.995	A	VW-202	30	30								1		X														
		A	VW-202	36	36			9.00								2		X							7				
NB	3.400	A	W11-4	30	30		 MM 3.4	6.25				I	I	I	I	1		X					INSTALL AT 3.40 MILE MARKER	X					
NB	3.540	A	W1-2L	30	30		LEFT CURVE								X							LEFT CURVE SIGN MISSING							
		A	W13-1	18	18		NOT THERE - NO REMOVAL 35 MPH ADVISORY						1																
NB	3.580	A	S3-1	30	30		SCHOOL BUS STOP AHEAD						1		X														
SIGN SUMMARY SHEET							SHEET TOTALS		35.00	0.00	0	-0-	-0-	9	0	0	5	75.0	0	0.0	0.0	0.0	0.0	PROJECT NAME: PAWLET - WEST RUTLAND PROJECT NUMBER: STPG SIGN(37)					
							SF	SF	EA	EA	EA	EA	EA	EA	EA	EA	FT	EA	LB	LB	LB	LB	FILE NAME: 10C340 PROJECT MANAGER: A. GAMBLE DESIGNED BY: J. KELLY PAWLET NB SHEET 6			PLOT DATE: 5/6/2011 DRAWN BY: J. KELLY CHECKED: A. GAMBLE SHEET 14 OF 61			
							TOWN DIRECTIONAL TOTALS		233.8	0.0	4	4	4	50	0	0	39	585.0	0	0.0									