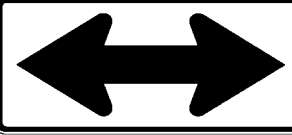


DIRECTION	MILEPOINT	LOCATION CODE (SHEET 2)	SIGN CODE	WIDTH (IN)	HEIGHT (IN)	SHEETING REMARKS	SIGN LEGEND	NEW SIGNS		EXISTING SIGNS				EXIST POST		NUMBER OF NEW POSTS	SQUARE STEEL (IN)			TUBULAR STEEL Ø (IN)				SIGN FRAME REQUIRED	REMARKS	SIGN DETAIL LOCATION										
								"A"	"B"	RETAIN	SALVAGE FROM	SALVAGE TO	REMOVE	RETAIN	REMOVE		1.75	2.00	2.50	FOUNDATION	3.00	3.50	4.00			5.00	SHSM	PROJECT SHEET #	STANDARD SHEET #							
																	(LB / FT)				(LB / FT)															
<b>TINMOUTH SB</b>							FY-FLUORESCENT YELLOW FYG-FLUORESCENT YELLOW GREEN																"SHSM"-STANDARD HIGHWAY SIGNS AND MARKINGS													
		F	D1-1A	72	12		PAWLET 14 ----> (45 DEG)			1																										
SB	2.313	F	M3-2	24	12		EAST			1																										
		F	M1-6	30	24		ROUTE 140			1																										
		F	M6-1	21	15		<--- LEFT			1																										
		F	M3-3	24	12		SOUTH			1																										
		F	M1-5	30	24		VERMONT 133			1																										
		F	M6-2	21	15		RIGHT ----> (45 DEG)			1																										
		F	M4-5	24	12		TO			1																										
		F	M3-4	24	12		WEST			1																										
		F	M1-6	24	24		ROUTE 140			1																										
		F	M6-2	21	15		RIGHT ----> (45 DEG)			1																										
SB	2.290	G	W1-7	48	24																															
		G	W1-7	48	24			8.00							2		X																			
SB	2.268	F	M3-3	24	12		SOUTH			1																										
		F	M1-5	30	24		VERMONT 133			1																										
<b>SIGN SUMMARY SHEET</b>							SHEET TOTALS		8.00	0.00	13	0	0	1	0	0	2	30.0	0	0.0	0.0	0.0	0.0	PROJECT NAME: PAWLET - WEST RUTLAND PROJECT NUMBER: STPG SIGN(37)												
VERMONT AGENCY OF TRANSPORTATION							TOWN DIRECTIONAL TOTALS		SF	SF	EA	EA	EA	EA	EA	EA	EA	FT	EA	LB	LB	LB	LB	FILE NAME: 10C340 PROJECT MANAGER: A. GAMBLE DESIGNED BY: J. KELLY TINMOUTH SB SHEET 2						PLOT DATE: 5/6/2011 DRAWN BY: J. KELLY CHECKED: A. GAMBLE SHEET 46 OF 61						
							32.3	0.0	22	4	4	8	0	0	8	120.0	0		0.0																	