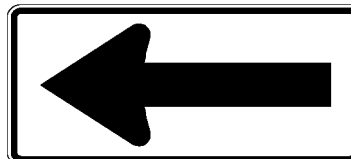
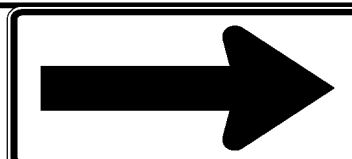


DIRECTION	MILEPOINT	LOCATION CODE (SHEET 2)	SIGN CODE	WIDTH (IN)	HEIGHT (IN)	SHEETING REMARKS	SIGN LEGEND	NEW SIGNS		EXISTING SIGNS				EXIST POST		NUMBER OF NEW POSTS	SQUARE STEEL (IN)			TUBULAR STEEL Ø (IN)					SIGN FRAME REQUIRED	REMARKS	SIGN DETAIL LOCATION							
								"A"	"B"	RETAIN	SALVAGE FROM	SALVAGE TO	REMOVE	RETAIN	REMOVE		1.75	2.00	2.50	FOUNDATION	3.00	3.50	4.00	5.00			SHSM	PROJECT SHEET #	STANDARD SHEET #					
																	(LB / FT)				(LB / FT)													
																	1.88	2.42	3.35		7.60	9.00	10.80	14.60										
IRA NB							FY-FLUORESCENT YELLOW FYG-FLUORESCENT YELLOW GREEN																"SHSM"-STANDARD HIGHWAY SIGNS AND MARKINGS											
NB	3.208	A	W11-4H	30	30		HINGED CATTLE CROSSING			1				X																				
NB	3.254	A	W1-2L	30	30		LEFT CURVE				1		1		X									MOVE 400 FEET NORTH.										
NB	3.330	A	W1-2L	30	30		LEFT CURVE					1			1		X							INSTALL 400 FEET NORTH OF EXISTING AND ACROSS FROM UTILITY POLE #68/25/90.										
NB	3.360	A	W1-8L	18	24		LEFT CHEVRON						1		X																			
NB	3.365	B	W1-8R	18	24		RIGHT CHEVRON						1		X																			
NB	3.385	A	W1-6L	48	24			8.00								2		X						INSTALL 50 FEET NORTH OF SOUTHERLY GATE FOR CEMETERY.	X									
NB	3.390	B	W1-6R	48	24			8.00								2		X						INSTALL 75 FEET NORTH OF SOUTHERLY GATE FOR CEMETERY.	X									
NB	3.405	A	W1-8L	18	24		LEFT CHEVRON						1		X																			
		B	W1-8R	18	24		RIGHT CHEVRON						1		X																			
NB	3.435	A	W1-8L	18	24		LEFT CHEVRON						1		X																			
		B	W1-8R	18	24		RIGHT CHEVRON						1		X																			
NB	3.542	A	W1-2R	30	30		RIGHT CURVE				1		1		X									MOVE 290 FEET NORTH.										
		A	W13-1	18	18		35 MPH ADVISORY				1		1																					
NB	3.597	A	W1-2R	30	30		RIGHT CURVE					1			1		X							INSTALL 290 FEET NORTH OF EXISTING AND 10 FEET SOUTH OF UTILITY POLE 20T/60/98.	X									
		A	W13-1	18	18		35 MPH ADVISORY					1													X									
SIGN SUMMARY SHEET							SHEET TOTALS		16.00	0.00	1	3	3	9	0	0	6	90.0			0	0.0	0.0	0.0	0.0	PROJECT NAME: PAWLET - WEST RUTLAND								
									SF	SF	EA	EA	EA	EA	EA	EA	EA	FT		EA	LB	LB	LB	LB	PROJECT NUMBER: STPG SIGN(37)									
																											FILE NAME: 10C340			PLOT DATE: 5/6/2011				
							VERMONT AGENCY OF TRANSPORTATION		TOWN DIRECTIONAL TOTALS										60.6	0.0	5	4	4	17	0	0	14	210.0			0	0.0		