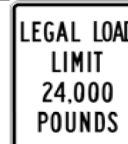


DIRECTION	MILEPOINT	LOCATION CODE (SHEET 2)	SIGN CODE	WIDTH (IN)	HEIGHT (IN)	SHEETING REMARKS	SIGN LEGEND	NEW SIGNS		EXISTING SIGNS				EXIST POST		NUMBER OF NEW POSTS	SQUARE STEEL (IN)			TUBULAR STEEL Ø (IN)				SIGN FRAME REQUIRED	REMARKS	SIGN DETAIL LOCATION					
								"A"	"B"	RETAIN	SALVAGE FROM	SALVAGE TO	REMOVE	RETAIN	REMOVE		1.75	2.00	2.50	FOUNDATION	3.00	3.50	4.00			5.00	SHSM	PROJECT SHEET #	STANDARD SHEET #		
																	(LB / FT)				(LB / FT)										
																	1.88	2.42	3.35		7.60	9.00	10.80			14.60					
IRA SB							FY-FLUORESCENT YELLOW FYG-FLUORESCENT YELLOW GREEN															"SHSM"-STANDARD HIGHWAY SIGNS AND MARKINGS									
		F	W7-3A	24	18			3.00																X							
SB	3.405	F	W11-4H	30	30		HINGED CATTLE CROSSING			1				X																	
SB	2.976	H	R1-1	30	30																		WEST RD. (TH-2)								
		G	VR-017	24	30																										
		H	R1-1	30	30																			INSTALL BACK TO BACK AS EXISTING.	X						
		G	VR-017	24	30				5.00																	6					
SB	2.970	H	R1-1	30	30																			WEST RD. (TH-2)							
		H	R1-1	30	30																			X							
SB	2.920	G	VR-017	24	30		LEGAL LOAD 24,000 LBS.																	TOWN OFFICE RD. (TH-10)							
SB	2.915	H	R1-1	30	30																			TOWN OFFICE RD. (TH-10)							
		H	R1-1	30	30																			REINSTALL STREET NAME SIGN ABOVE NEW SIGN.	X						
SB	2.880	F	R2-1	24	30																										
		F	R2-1	24	30																			INSTALL NEW SIGN ON EXISTING POST.	X						
SB	2.650	F	R2-1	24	30		SPEED LIMIT 50			1				X																	
SB	1.600	F	S3-1	36	36	FYG	 MOVED 40FT NORTH DUE TO LEDGE ROCK	9.00								2		X							INSTALL 50 FEET NORTH AND ACROSS FROM 1.59 MILE MARKER.	X					
SIGN SUMMARY SHEET							 SHEET TOTALS	40.75	0.00	2	0	0	6	0	0	5	75.0			0	0.0	0.0	0.0	0.0	PROJECT NAME: PAWLET - WEST RUTLAND						
								SF	SF	EA	EA	EA	EA	EA	EA	EA	FT		EA	LB	LB	LB	LB	PROJECT NUMBER: STPG SIGN(37)							
																										FILE NAME: 10C340			PLOT DATE: 5/6/2011		
																										PROJECT MANAGER: A. GAMBLE			DRAWN BY: J. KELLY		
VERMONT AGENCY OF TRANSPORTATION							TOWN DIRECTIONAL TOTALS	126.5	0.0	2	0	0	21	0	0	13	195.0			0	0.0				DESIGNED BY: J. KELLY						
																							IRA SB SHEET 3			CHECKED A. GAMBLE					
																						SHEET 53 OF 61									