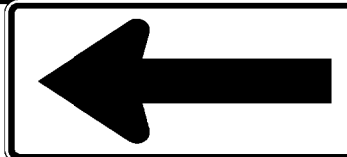
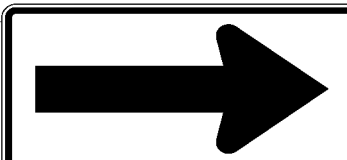
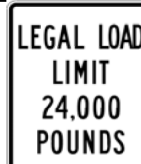
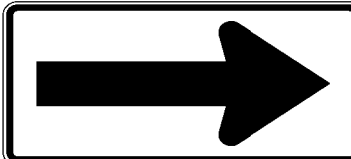


DIRECTION	MILEPOINT	LOCATION CODE (SHEET 2)	SIGN CODE	WIDTH (IN)	HEIGHT (IN)	SHEETING REMARKS	SIGN LEGEND	NEW SIGNS		EXISTING SIGNS				EXIST POST		NUMBER OF NEW POSTS	SQUARE STEEL (IN)			TUBULAR STEEL Ø (IN)					SIGN FRAME REQUIRED	REMARKS	SIGN DETAIL LOCATION		
								"A"	"B"	RETAIN	SALVAGE FROM	SALVAGE TO	REMOVE	RETAIN	REMOVE		1.75	2.00	2.50	FOUNDATION	3.00	3.50	4.00	5.00			SHSM	PROJECT SHEET #	STANDARD SHEET #
																	(LB / FT)				(LB / FT)								
																	1.88	2.42	3.35		7.60	9.00	10.80	14.60					
CLARENDON NB							FY-FLUORESCENT YELLOW FYG-FLUORESCENT YELLOW GREEN																"SHSM"-STANDARD HIGHWAY SIGNS AND MARKINGS						
		A	W1-6L	48	24			8.00																REPLACE SIGN IN ISLAND. INSTALL ON EXISTING POSTS.	X				
NB	0.847	B	W1-6R	48	24								1	X															
		B	W1-6R	48	24			8.00																REPLACE SIGN IN ISLAND. INSTALL ON EXISTING POSTS.	X				
NB	0.855	D	R1-1	30	30		STOP			1				X															
NB	0.855	C	VR-017	24	30		• ELIMINATE • 	5.00							1		X							INSTALL NEW IN ISLAND AND ACROSS FROM STOP SIGN.		6			
NB	0.865	B	W1-6R	48	24			8.00								2		X						INSTALL NEW NEXT TO CEDAR HEDGE AND FACING SB TRAFFIC.	X				
NB	0.960	A	VW-202	30	30								1		X														
		A	VW-202R	36	36			9.00								2		X								7			
NB	1.000	A	R2-1	24	30		SPEED LIMIT 40						1		X														
		A	VD-700	6	8		CUT POST AT MILE MARKER 1.00 MILE MARKER				+	+	+			+	X							REINSTALL 1.00 MILE MARKER ON NEW POST.					
NB	1.090	A	R2-1	24	30			5.00								1		X						INSTALL 450 FEET NORTH OF EXISTING.	X				
SIGN SUMMARY SHEET							SHEET TOTALS	43.00	0.00	1	1	1	3 4	0	0	7	105.0			0	0.0	0.0	0.0	0.0	PROJECT NAME: PAWLET - WEST RUTLAND				
								SF	SF	EA	EA	EA	EA	EA	EA	EA		FT		EA	LB	LB	LB	LB	PROJECT NUMBER: STPG SIGN(37)				
							TOWN DIRECTIONAL TOTALS	73.8	0.0	2	1	1	11	0	0	14	210.0			0	0.0				FILE NAME: 10C340 PROJECT MANAGER: A. GAMBLE DESIGNED BY: J. KELLY CLARENDON NB SHEET 2			PLOT DATE: 5/6/2011 DRAWN BY: J. KELLY CHECKED A. GAMBLE SHEET 55 OF 61	
VERMONT AGENCY OF TRANSPORTATION																													