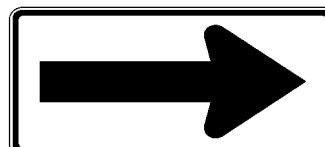


DIRECTION	MILEPOINT	LOCATION CODE (SHEET 2)	SIGN CODE	WIDTH (IN)	HEIGHT (IN)	SHEETING REMARKS	SIGN LEGEND	NEW SIGNS		EXISTING SIGNS				EXIST POST		NUMBER OF NEW POSTS	SQUARE STEEL (IN)			TUBULAR STEEL Ø (IN)				SIGN FRAME REQUIRED	REMARKS	SIGN DETAIL LOCATION			
								"A"	"B"	RETAIN	SALVAGE FROM	SALVAGE TO	REMOVE	RETAIN	REMOVE		1.75	2.00	2.50	FOUNDATION	3.00	3.50	4.00			5.00	SHSM	PROJECT SHEET #	STANDARD SHEET #
																	(LB / FT)				(LB / FT)								
																	1.88	2.42	3.35		7.60	9.00	10.80			14.60			
WEST RUTLAND NB							FY-FLUORESCENT YELLOW FYG-FLUORESCENT YELLOW GREEN															"SHSM"-STANDARD HIGHWAY SIGNS AND MARKINGS							
		A	W1-6L	48	24	FY		8.00															INSTALL NEW SIGN ON EXISTING POSTS.	X					
NB	0.290	A	S3-1	30	30		SCHOOL BUS STOP AHEAD						1		X														
NB	0.315	B	W1-6R	48	24								1	X															
		B	W1-6R	48	24	FY		8.00															INSTALL NEW SIGN ON EXISTING POSTS.	X					
NB	0.670	A					(REMOVE EMPTY POST - UNKNOWN SIGN)						1		X								REMOVE EMPTY POST						
NB	0.700	A	R2-1	24	30		  REMOVED AND REPLACED ON 5-24-12						1	X										INSTALL NEW SIGNS ON EXISTING POST.		6			
		A	VR-038	24	18			3.00						I															
		A	R2-1	24	30			5.00						I											X				
		A		24	24			TOWN'S ENGINE BRAKE SIGN						+										REMOVE TOWN SIGN					
		B	VR-039	24	18		STATE HIGHWAY BEGINS						1																
		B	VR-041	24	24		THROUGH WAY BEGINS HERE						+																
SIGN SUMMARY SHEET							SHEET TOTALS	24.00	0.00	0	0	0	9 7	0	0	0	0.0			0	0.0	0.0	0.0	0.0	PROJECT NAME: PAWLET - WEST RUTLAND				
								SF	SF	EA	EA	EA	EA	EA	EA	EA		FT		EA	LB		LB	LB	LB	PROJECT NUMBER: STPG SIGN(37)			
							VERMONT AGENCY OF TRANSPORTATION																			FILE NAME: 10C340			
																											PROJECT MANAGER: A. GAMBLE		
							TOWN DIRECTIONAL TOTALS	53.6	0.0	0	1	1	15	0	0	7	105.0			0	0.0				DESIGNED BY: J. KELLY				
																							PLOT DATE: 5/6/2011						
																							DRAWN BY: J. KELLY						
																							CHECKED A. GAMBLE						
																							WEST RUTLAND NB SHEET 2						
																							SHEET 59 OF 61						