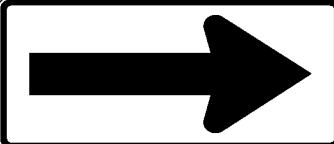

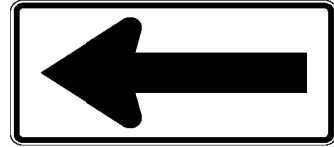







DIRECTION	MILEPOINT	LOCATION CODE (SHEET 2)	SIGN CODE	WIDTH (IN)	HEIGHT (IN)	SHEETING REMARKS	SIGN LEGEND	NEW SIGNS		EXISTING SIGNS				EXIST POST		NUMBER OF NEW POSTS	SQUARE STEEL (IN)			TUBULAR STEEL Ø (IN)				SIGN FRAME REQUIRED	REMARKS	SIGN DETAIL LOCATION			
								"A"	"B"	RETAIN	SALVAGE FROM	SALVAGE TO	REMOVE	RETAIN	REMOVE		1.75	2.00	2.50	FOUNDATION	3.00	3.50	4.00			5.00	SHSM	PROJECT SHEET #	STANDARD SHEET #
																	(LB / FT)				(LB / FT)								
PAWLET NB							FY-FLUORESCENT YELLOW FYG-FLUORESCENT YELLOW GREEN															"SHSM"-STANDARD HIGHWAY SIGNS AND MARKINGS							
NB	1.300	B	W1-6R	48	24																								
		B	W1-6R	48	24			8.00																X					
NB	1.300	C	VR-017	24	30		STOP - 18 B STOP - 18 A	6.25																					
		C	VR-017	24	30			5.00																	6				
NB	1.310	A	W1-6L	48	24																								
		A	W1-6L	48	24			8.00																X					
NB	1.310	D	R1-1	30	30		MILE MARKER																						
		D	R1-1	30	30			6.25 5.25																X					
NB	1.310	C	VR-017	24	30		LEGAL LOAD 24,000 LBS																						
NB	1.320	D	R1-1	30	30																								
		D	R1-1	30	30			6.25																X					
NB	1.355	A	M3-1	24	12			2.00																	E-136B				
			M1-5	30	24			5.00																	E-136B				
NB	1.580	A	S3-1	36	36			9.00																X					
NB	2.320	A	W1-2L	30	30		LEFT CURVE																						
SIGN SUMMARY SHEET							SHEET TOTALS	62.0 48.50	0.00	0	2 0	2 0	8 7	0	0	8	120.0	0	0.0	0.0	0.0	0.0	PROJECT NAME: PAWLET - WEST RUTLAND PROJECT NUMBER: STPG SIGN(37)						
VERMONT AGENCY OF TRANSPORTATION							TOWN DIRECTIONAL TOTALS	233.8	0.0	4	4	4	50	0	0	39	585.0	0		0.0			FILE NAME: 10C340 PROJECT MANAGER: A. GAMBLE DESIGNED BY: J. KELLY PAWLET NB SHEET 4	PLOT DATE: 5/6/2011 DRAWN BY: J. KELLY CHECKED: A. GAMBLE SHEET 12 OF 61					