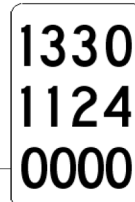

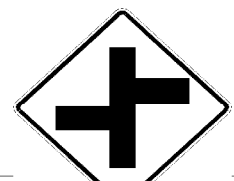
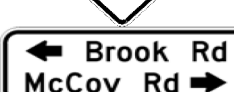


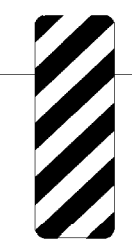
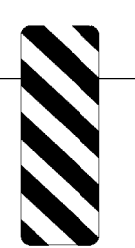


DIRECTION	MILEPOINT	LOCATION CODE (SHEET 2)	SIGN CODE	WIDTH (IN)	HEIGHT (IN)	SHEETING REMARKS	SIGN LEGEND	NEW SIGNS		EXISTING SIGNS				EXIST POST		NUMBER OF NEW POSTS	SQUARE STEEL (IN)			TUBULAR STEEL Ø (IN)				SIGN FRAME REQUIRED	REMARKS	SIGN DETAIL LOCATION			
								"A"	"B"	RETAIN	SALVAGE FROM	SALVAGE TO	REMOVE	RETAIN	REMOVE		1.75	2.00	2.50	FOUNDATION	3.00	3.50	4.00			5.00	SHSM	PROJECT SHEET #	STANDARD SHEET #
																	(LB / FT)				(LB / FT)								
TINMOUTH NB							FY-FLUORESCENT YELLOW FYG-FLUORESCENT YELLOW GREEN															"SHSM"-STANDARD HIGHWAY SIGNS AND MARKINGS							
NB	0.000	C	VD-024	72	10		Tinmouth Danby	5.00						2	X								INSTALL ACROSS FROM EXISTING TOWN LINE SIGN AND BEHIND POLE #123-1.		4				
		C	VD-700	6	10			0.42															INSTALL ON LEFT POST BELOW TINMOUTH			E-138			
		C	VD-700	6	10			0.42															INSTALL ON RIGHT POST BELOW DANBY			E-138			
NB	0.490	A	W2-1 M	30	30		MODIFIED CROSSROAD																						
NB	0.535	A	W2-7L	30	30			6.25						1	X								INSTALL 225 FEET NORTH OF EXISTING INTERSECTION ASSEMBLY.	X					
		A	W16-8AP	42	15			4.38															THINNING AND TRIMMING		7				
NB	0.630	C	VR-017	24	30																		MCCOY RD (TH-28)						
		C	VR-017	24	30			5.00						1	X								THINNING AND TRIMMING		6				
NB	0.635	D	R1-1	24	24																		MCCOY RD (TH-28)						
		D	R1-1	30	30			6.25						1	X								THINNING AND TRIMMING	X					
NB	0.640	A	OM-3R	12	36																								
		A	OM-3R	12	36			3.00						1	X								INSTALL AT HEIGHT OF 4 FEET ABOVE ROAD.	X					
		A	VD-701	6	8		BRIDGE MARKER				1	1	1										INSTALL BELOW OBJECT MARKER.						
NB	0.650	B	OM-3L	12	36		(SIGN IS MISSING)																						
		B	OM-3L	12	36			3.00						1	X								INSTALL AT HEIGHT OF 4 FEET ABOVE ROAD.	X					
SIGN SUMMARY SHEET							SHEET TOTALS	33.72	0.00	0	1	1	6	0	0	7	105.0	0	0.0	0.0	0.0	0.0	PROJECT NAME: PAWLET - WEST RUTLAND PROJECT NUMBER: STPG SIGN(37)						
VERMONT AGENCY OF TRANSPORTATION							TOWN DIRECTIONAL TOTALS	49.7	0.0	1	1	1	13	0	0	11	165.0	0		0.0			FILE NAME: 10C340 PROJECT MANAGER: A. GAMBLE DESIGNED BY: J. KELLY TINMOUTH NB SHEET 1	PLOT DATE: 5/6/2011 DRAWN BY: J. KELLY CHECKED: A. GAMBLE SHEET 25 OF 61					