
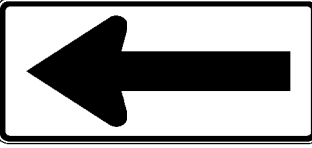


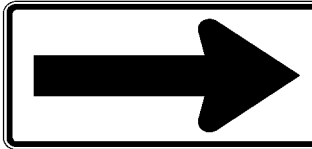

DIRECTION	MILEPOINT	LOCATION CODE (SHEET 2)	SIGN CODE	WIDTH (IN)	HEIGHT (IN)	SHEETING REMARKS	SIGN LEGEND	NEW SIGNS		EXISTING SIGNS				EXIST POST		NUMBER OF NEW POSTS	SQUARE STEEL (IN)			TUBULAR STEEL Ø (IN)				SIGN FRAME REQUIRED	REMARKS	SIGN DETAIL LOCATION			
								"A"	"B"	RETAIN	SALVAGE FROM	SALVAGE TO	REMOVE	RETAIN	REMOVE		1.75	2.00	2.50	FOUNDATION	3.00	3.50	4.00			5.00	SHSM	PROJECT SHEET #	STANDARD SHEET #
																	(LB / FT)				(LB / FT)								
WEST RUTLAND NB							FY-FLUORESCENT YELLOW FYG-FLUORESCENT YELLOW GREEN															"SHSM"-STANDARD HIGHWAY SIGNS AND MARKINGS							
		A	W1-6L	48	24	FY		8.00															INSTALL NEW SIGN ON EXISTING POSTS.	X					
NB	0.290	A	S3-1	30	30		SCHOOL BUS STOP AHEAD						1		X														
NB	0.315	B	W1-6R	48	24										1		X							INSTALL NEW SIGN ON EXISTING POSTS.					
		B	W1-6R	48	24	FY		8.00																X					
NB	0.670	A					(REMOVE EMPTY POST - UNKNOWN SIGN)								1		X						REMOVE EMPTY POST						
NB	0.700	A	R2-1	24	30										1		X												
		A	VR-038	24	18			3.00																INSTALL NEW SIGNS ON EXISTING POST.		6			
		A	R2-1	24	30		 REMOVED AND REPLACED ON 5-24-12	5.00																X					
		A		24	24		TOWN'S ENGINE BRAKE SIGN																	REMOVE TOWN SIGN					
		B	VR-039	24	18		STATE HIGHWAY BEGINS								1														
		B	VR-041	24	24		THROUGH WAY BEGINS HERE																						
SIGN SUMMARY SHEET							SHEET TOTALS	24.00	0.00	0	0	0	15	0	0	0	0.0	0	0.0	0.0	0.0	0.0	0.0	PROJECT NAME: PAWLET - WEST RUTLAND					
VERMONT AGENCY OF TRANSPORTATION							TOWN DIRECTIONAL TOTALS	SF	SF	EA	EA	EA	EA	EA	EA	EA	EA	EA	EA	EA	EA	EA	EA	EA	PROJECT NUMBER: STPG SIGN(37)				
									0	1	1	15	0	0	7	105.0	0		0.0				FILE NAME: 10C340	PLOT DATE: 5/6/2011					
																								PROJECT MANAGER: A. GAMBLE	DRAWN BY: J. KELLY				
																								DESIGNED BY: J. KELLY	CHECKED: A. GAMBLE				
																								WEST RUTLAND NB SHEET 2	SHEET 59 OF 61				