
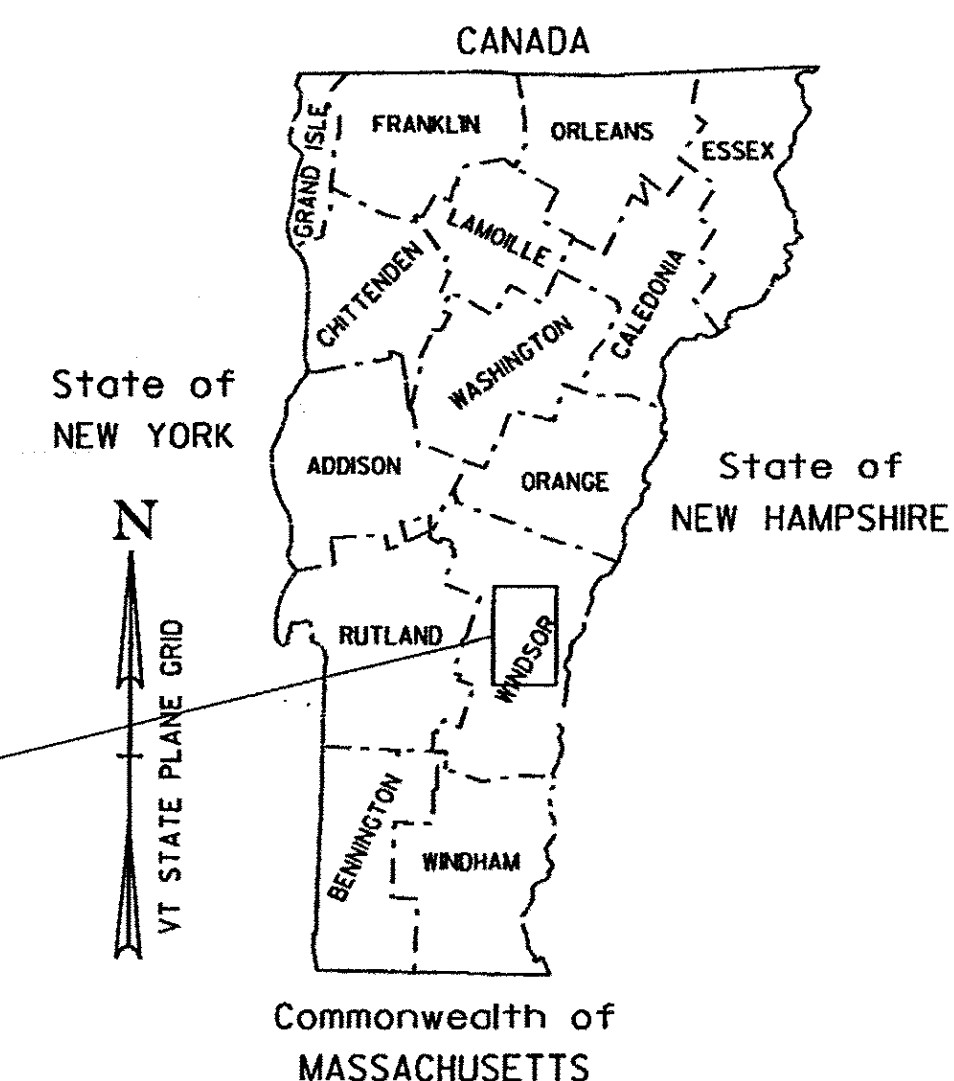


STATE OF VERMONT AGENCY OF TRANSPORTATION

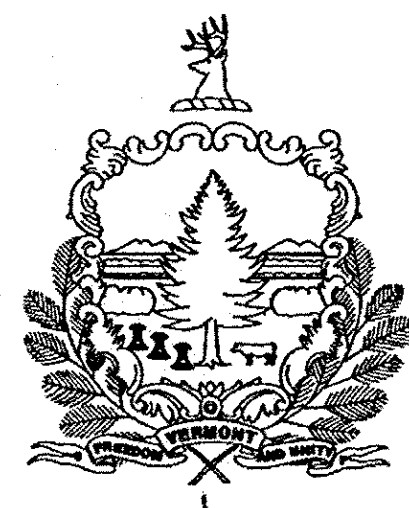

PROJECT LOCATION
READING-WOODSTOCK STPG SIGN(38)

INDEX OF SHEETS
SEE SHEET 2


PROPOSED IMPROVEMENT TOWNS OF READING AND WOODSTOCK COUNTY OF WINDSOR VT ROUTE 106

SOUTHEAST REGION SIGN REPLACEMENT - 13.830 MILES ON VT 106; READING MP 0.000-7.277
AND WOODSTOCK MP 0.000-6.553 (TO CLASS I VILLAGE LINE)

LENGTH OF ROADWAY = 13.830 MILES
LENGTH OF PROJECT = 13.830 MILES

WORK TO BE PERFORMED UNDER THIS PROJECT INCLUDES THE REMOVAL OF EXISTING SIGNS AND POSTS
AND THE INSTALLATION OF NEW SIGNS, SIGN POSTS AND INCIDENTAL ITEMS.

| RECORD PLANS | |
|--|---|
| CONTRACTOR: | L&D SAFETY MARKINGS CORP.-BERLIN, VT |
| RESIDENT ENGINEER: | MARK HAUGHWOUT |
| CONSTRUCTION BEGAN: | SEPTEMBER 20, 2011 |
| CONSTRUCTION COMPLETE: | OCTOBER 14, 2011 |
| RECORD PLANS BY: | MARK HAUGHWOUT & C. PIERCE |
| I HEREBY CERTIFY THAT ALL THE CONSTRUCTION REQUIRED BY THIS SET OF DRAWINGS HAS BEEN ACCOMPLISHED AS INDICATED HEREIN. | |
| BY | <i>Mark Haughwout</i> RESIDENT ENGINEER |
| DATE | 4/10/12 |
| NOTE: Any further information concerning final quantities, amounts or other details relative to this project may be found at Central Files in the electronic archives. | |

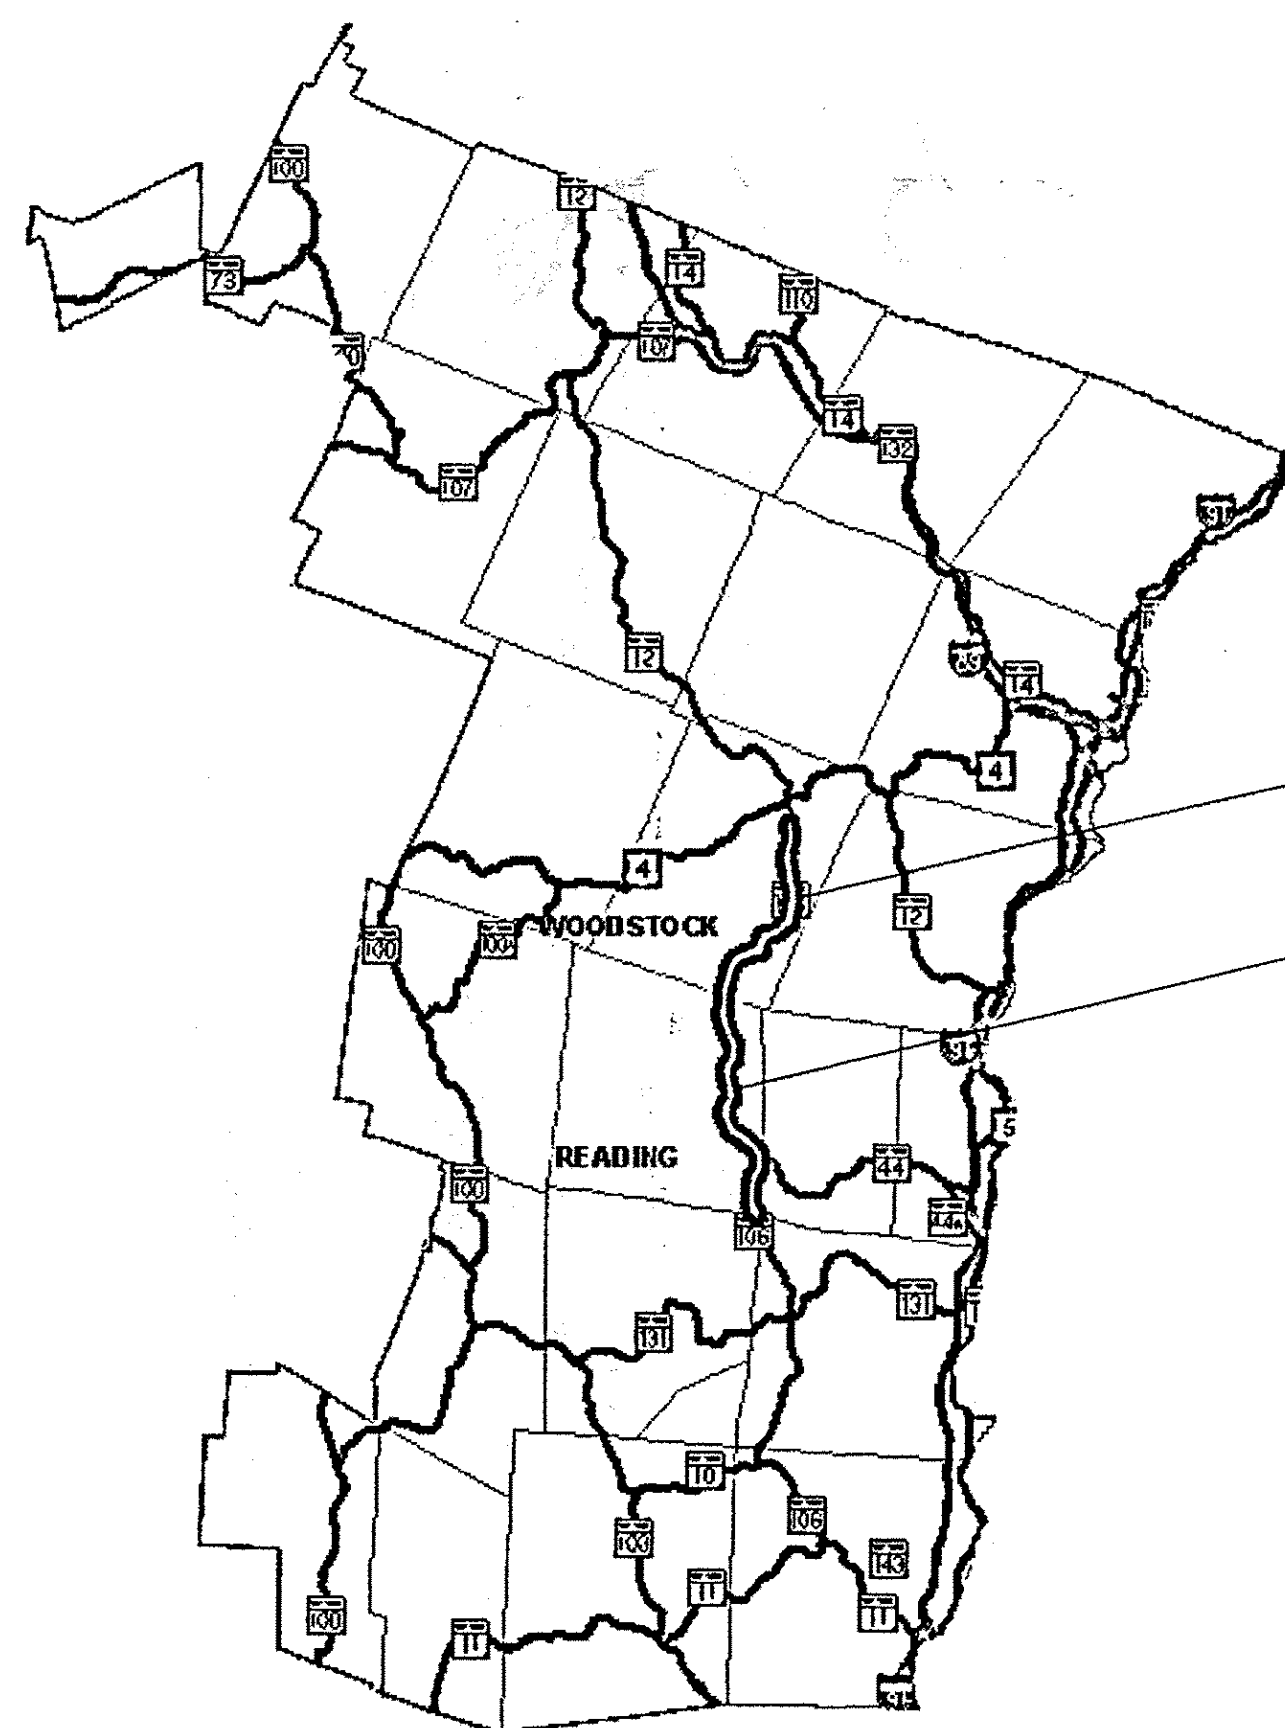

QUALITY ASSURANCE PROGRAM: LEVEL 3

CONVENTIONAL SYMBOLS

| | |
|--------------------|--|
| COUNTY LINE | |
| TOWN LINE | |
| LIMITS OF ACCESS | |
| POINT OF ACCESS | |
| FENCE LINE | |
| STONE WALL | |
| TRAVELED WAY | |
| GUARD RAIL | |
| RAILROAD | |
| SURVEY LINE | |
| CULVERT | |
| POWER POLE | |
| TELEPHONE POLE | |
| TREES | |
| CONTROL OF ACCESS | |
| PROPERTY LINE | |
| R.O.W. TAKING LINE | |
| SLOPE RIGHTS | |
| TOP OF CUT | |
| TOE OF SLOPE | |

SURVEYED BY : N/A
SURVEYED DATE : N/A

DATUM
VERTICAL N/A
HORIZONTAL N/A

NOT TO SCALE

THESE PLANS ARE SUBJECT TO SUCH ENGINEERING CHANGES AS MAY BE REQUIRED BY THE FEDERAL HIGHWAY ADMINISTRATION OR THE DIRECTOR OF PROGRAM DEVELOPMENT.

CONSTRUCTION IS TO BE CARRIED ON IN ACCORDANCE WITH THESE PLANS AND THE STANDARD SPECIFICATIONS FOR CONSTRUCTION DATED 2006, AS APPROVED BY THE FEDERAL HIGHWAY ADMINISTRATION ON JUNE 15, 2006 FOR USE ON THIS PROJECT, INCLUDING ALL SUBSEQUENT REVISIONS AND SUCH REVISED SPECIFICATIONS AND SPECIAL PROVISIONS AS ARE INCORPORATED IN THESE PLANS.

| | |
|---------------------------------|-------------------|
| DIRECTOR OF PROGRAM DEVELOPMENT | |
| APPROVED <i>Peter Johnson</i> | DATE 4/13/11 |
| PROJECT MANAGER : | AMY GAMBLE |
| PROJECT NAME : | READING-WOODSTOCK |
| PROJECT NUMBER : | STPG SIGN (38) |
| SHEET 1 OF 49 SHEETS | |