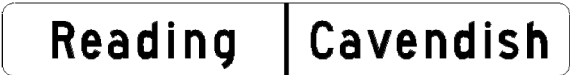
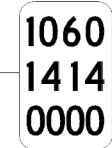
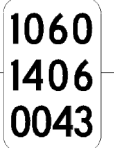


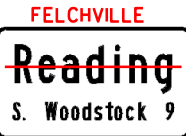


DIRECTION	MILEPOINT	LOCATION CODE (SHEET 2)	SIGN CODE	WIDTH (IN)	HEIGHT (IN)	SHEETING REMARKS	SIGN LEGEND	NEW SIGNS		EXISTING SIGNS				EXIST POST		NUMBER OF NEW POSTS	SQUARE STEEL (IN)			TUBULAR STEEL Ø (IN)				SIGN FRAME REQUIRED	REMARKS	SIGN DETAIL			
								"A"	"B"	RETAIN	SALVAGE FROM	SALVAGE TO	REMOVE	RETAIN	REMOVE		1.75	2.00	2.50	FOUNDATION	3.00	3.50	4.00			5.00	DETAIL IN SHS	DETAIL ON SHEET NUMBER	DETAIL ON STD SHEET NUMBER
																	(LB / FT)				(LB / FT)								
READING NB							FY-FLUORESCENT YELLOW FYG-FLUORESCENT YELLOW GREEN															"SHS"-STANDARD HIGHWAY SIGNS							
NB	0.000	C	VD-024	60	7.5		READING CAVENDISH																						
		C	VD-700	6	8		MILE MARKER 1060 / 1414 / 0000																						
		C	VD-700	6	8		MILE MARKER 1060 / 1406 / 0043																						
		C	VD-024	72	10			5.00																	4				
		C	VD-700	6	10			0.42																	E-138				
		C	VD-700	6	10			0.42																	E-138				
NB	0.039	A	S3-1	30	30	FYG	 SCHOOL BUS STOP AHEAD (TEXT)																						
		A	S3-1	36	36	FYG		9.00																X					
NB	0.283	A	W3-5	36	36																								
		A	W3-5	36	36			9.00																X					
NB	0.355	A	R2-1	30	36		SPEED LIMIT 40			1	I	I	I	X	X	I													
NB	0.425	A	VD-018	30	18																								
		A	VD-018	30	18			3.75																		8			
NB	0.490	A	R2-1	30	36		SPEED LIMIT 35			1					X														
SIGN SUMMARY SHEET							SHEET TOTALS		27.59	0.00	1	0	0	7	0	0	8	104.75					PROJECT NAME: READING-WOODSTOCK						
VERMONT AGENCY OF TRANSPORTATION							TOWN DIRECTIONAL TOTALS		SF	SF	EA	EA	EA	EA	EA	EA	EA	FT					PROJECT NUMBER: STPG SIGN (38)						
							243.68	0.00	8	2	2	43	0	0	38	570.00					FILE NAME: READING VT-106 NB								
																						PLOT DATE: 4/7/2011							
																						DRAWN BY: M. MILLER							
																						CHECKED BY: A. GAMBLE							
																						SHEET 9 OF 49							