




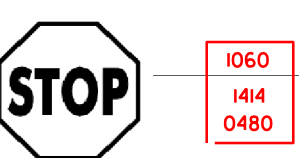




DIRECTION	MILEPOINT	LOCATION CODE (SHEET 2)	SIGN CODE	WIDTH (IN)	HEIGHT (IN)	SHEETING REMARKS	SIGN LEGEND	NEW SIGNS		EXISTING SIGNS				EXIST POST		NUMBER OF NEW POSTS	SQUARE STEEL (IN)			TUBULAR STEEL Ø (IN)				SIGN FRAME REQUIRED	REMARKS	SIGN DETAIL			
								"A"	"B"	RETAIN	SALVAGE FROM	SALVAGE TO	REMOVE	RETAIN	REMOVE		1.75	2.00	2.50	FOUNDATION	3.00	3.50	4.00			5.00	DETAIL IN SHS	DETAIL ON SHEET NUMBER	DETAIL ON STD SHEET NUMBER
																	(LB / FT)				(LB / FT)								
READING SB							FY-FLUORESCENT YELLOW FYG-FLUORESCENT YELLOW GREEN															"SHS"-STANDARD HIGHWAY SIGNS							
SB	5.350	F	W1-4R	30	30			6.25							1	14.75' X						(0.659 MILES SOUTH OF THE SPEED LIMIT 50 AT MP 6.009) INSTALL THIS SIGN 325 FT± SOUTH OF THE NB GRAVEL PULLOFF	X						
SB	5.138	F	W2-2	30	30			6.25							1	13.75' X						INSTALL 1' BEHIND RAIL .325 FT± NORTH OF THE INTERSECTION WITH WHITMORE CIR (TH-7/23)	X						
SB	5.076	G	VR-017	24	30																	WHITMORE CIR (TH-7/23); SIGN AND POST ARE MISSING			6				
SB	5.072	H	R1-1	30	30																	WHITMORE CIR (TH-7/23)							
SB	4.798	G	VR-017	24	30																	WHITMORE CIR (TH-7/23)			6				
SB	4.794	H	R1-1	30	30																	WHITMORE CIR (TH-7/23)							
SB	3.945	F	VD-062AS	72	16		BUSINESS DIRECTIONAL SIGN		1													BAILEY'S MILLS B & B							
SB	3.842	F	W1-10L	30	30		LEFT CURVE w/ SIDE ROAD RIGHT (SYMBOL)															TO BE REPLACED 225 FT± SOUTH OF THIS LOCATION							
		F	W13-1	18	18		40-MPH (PLAQUE)																						
SB	3.800	F	W1-10cL	36	36			9.00														INSTALL 225 FT± SOUTH OF MP 3.842; NEW 2009 MUTCD SIGN CODE	X						
		F	W13-1	18	18			2.25														INSTALL THE ADVISORY SPEED PLAQUE ON THE LEFT POST	X						
SIGN SUMMARY SHEET							SHEET TOTALS	46.25	0.00	1	3	3	8	0	0	8	104.25						PROJECT NAME: READING-WOODSTOCK						
VERMONT AGENCY OF TRANSPORTATION							TOWN DIRECTIONAL TOTALS	338.48	0.00	10	6	6	52	0	0	54	810.00						PROJECT NUMBER: STPG SIGN (38)						
																						FILE NAME: READING VT-106 SB							
																							PLOT DATE: 4/7/2011						
																								DRAWN BY: M. MILLER					
																								CHECKED BY: A. GAMBLE					
																									SHEET 17 OF 49				