






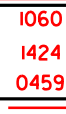


DIRECTION	MILEPOINT	LOCATION CODE (SHEET 2)	SIGN CODE	WIDTH (IN)	HEIGHT (IN)	SHEETING REMARKS	SIGN LEGEND	NEW SIGNS		EXISTING SIGNS				EXIST POST		NUMBER OF NEW POSTS	SQUARE STEEL (IN)			TUBULAR STEEL Ø (IN)				SIGN FRAME REQUIRED	REMARKS	SIGN DETAIL						
								"A"	"B"	RETAIN	SALVAGE FROM	SALVAGE TO	REMOVE	RETAIN	REMOVE		1.75	2.00	2.50	FOUNDATION	3.00	3.50	4.00			5.00	DETAIL IN SHS	DETAIL ON SHEET NUMBER	DETAIL ON STD SHEET NUMBER			
																	(LB / FT)				(LB / FT)											
<b>WOODSTOCK NB</b>							FY-FLUORESCENT YELLOW FYG-FLUORESCENT YELLOW GREEN															"SHS"-STANDARD HIGHWAY SIGNS										
NB	4.558	A	W1-5R	30	30		 1060 1424 0459																			WILL NOT BE REPLACED; DISCARD MILE MARKER SIGN						
NB	4.836	C	VR-017	24	30																					DUNHAM HILL RD (TH-66)						
		C	VR-017	24	30																								6			
NB	4.842	D	R1-1	30	30		 1060 1424 0487																				DUNHAM HILL RD (TH-66)					
		D	R1-1	30	30																									X		
NB	5.370	A	W5-2	36	36																						INSTALL 230 FT ± SOUTH OF THE OBJECT MARKER AT MP 5.414±			X		
NB	5.414	A	OM-3R	12	36																					FACES NB TRAFFIC						
		A	VD-701	6	8																					THE BRIDGE NUMBER PLAQUE TO BE SALVAGED TO UNDER THE NEW OBJECT MARKER						
		A	OM-3R	12	36	 1060 1424 0541																				INSTALL AT 4 FT VERTICAL CLEARANCE MEASURED FROM EDGE OF ROAD TO BOTTOM OF SIGN			X			
		A	VD-701	6	8																					SALVAGE TO UNDER THE NEW OBJECT MARKER						
NB	5.428	B	OM-3L	12	36																					FACES SB TRAFFIC						
		B	OM-3L	12	36																					INSTALL AT 4 FT VERTICAL CLEARANCE MEASURED FROM EDGE OF ROAD TO BOTTOM OF SIGN			X			
NB	5.479	A	VD-062AL	72	16																					NATIONAL PARK ROUTE 12 ^UP						
NB	6.181	A	R2-5A	24	30		 1060 1424 0620																				MM WAS REMOVED AND DISCARDED.					
NB	6.190 6.253	A	W3-5	36	36																					INSTALL <del>300</del> FEET ± NORTH OF THE REMOVED "REDUCED SPEED AHEAD" AT 6.181			X			
<b>SIGN SUMMARY SHEET</b>																																
VERMONT AGENCY OF TRANSPORTATION																																
<b>SHEET TOTALS</b>																																
<b>TOWN DIRECTIONAL TOTALS</b>																																
35.25 0.00								1	3	3	11	0	0	8	106.50					PROJECT NAME: <b>READING- WOODSTOCK</b>												
SF SF								EA	EA	EA	EA	EA	EA	EA	FT					PROJECT NUMBER: <b>STPG SIGN (38)</b>												
428.09 0.0								2	9	9	94	0	0	87	1305.00					FILE NAME: <b>WOODSTOCK VT-106 NB</b>												
																				PLOT DATE: <b>4/7/2011</b>												
																				DRAWN BY: <b>M. MILLER</b>												
																				CHECKED BY: <b>A. GAMBLE</b>												
																				DESIGNED BY: <b>M. MILLER</b>												
																				WOODSTOCK VT-106 NORTHBOUND 12												
																				SHEET <b>37</b> OF <b>49</b>												