
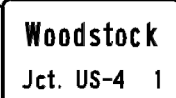






DIRECTION	MILEPOINT	LOCATION CODE (SHEET 2)	SIGN CODE	WIDTH (IN)	HEIGHT (IN)	SHEETING REMARKS	SIGN LEGEND	NEW SIGNS		EXISTING SIGNS				EXIST POST		NUMBER OF NEW POSTS	SQUARE STEEL (IN)			TUBULAR STEEL Ø (IN)				SIGN FRAME REQUIRED	REMARKS	SIGN DETAIL			
								"A"	"B"	RETAIN	SALVAGE FROM	SALVAGE TO	REMOVE	RETAIN	REMOVE		1.75	2.00	2.50	FOUNDATION	3.00	3.50	4.00			5.00	DETAIL IN SHS	DETAIL ON SHEET NUMBER	DETAIL ON STD SHEET NUMBER
																	(LB / FT)				(LB / FT)								
<b>WOODSTOCK NB</b>							FY-FLUORESCENT YELLOW FYG-FLUORESCENT YELLOW GREEN															"SHS"-STANDARD HIGHWAY SIGNS							
NB	6.315	A	R2-1	24	30																								
		A	R2-1	30	36			7.50																	6				
NB	<del>6.356</del> 6.366	A	VD-018	30	18			3.75																	8				
NB	6.401	A	R2-5A	24	30																								
NB	6.434	A	W3-5	36	36			9.00																	X				
NB	6.514	A	R2-1	24	30																								
		A	VR-040	24	24																								
		B	VR-039	24	18																								
		A	VR-038	24	18		 	3.00																	6				
		A	R2-1	30	36			7.50																	6				
<b>SIGN SUMMARY SHEET</b>							SHEET TOTALS	30.75	0.00	0	0	0	<del>6</del>	0	0	5	<del>74.50</del>							PROJECT NAME: <b>READING- WOODSTOCK</b>					
VERMONT AGENCY OF TRANSPORTATION							TOWN DIRECTIONAL TOTALS	428.09	0.0	2	9	9	94	0	0	87	1305.00						PROJECT NUMBER: <b>STPG SIGN (38)</b>						
																							FILE NAME: <b>WOODSTOCK VT-106 NB</b>	PLOT DATE: <b>4/7/2011</b>					
																								PROJECT MANAGER: <b>A. GAMBLE</b>	DRAWN BY: <b>M. MILLER</b>				
																									DESIGNED BY: <b>M. MILLER</b>	CHECKED BY: <b>A. GAMBLE</b>			
																										WOODSTOCK VT-106 NORTHBOUND 13	SHEET <b>38</b>	OF <b>49</b>	