






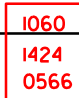
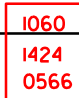


DIRECTION	MILEPOINT	LOCATION CODE (SHEET 2)	SIGN CODE	WIDTH (IN)	HEIGHT (IN)	SHEETING REMARKS	SIGN LEGEND	NEW SIGNS		EXISTING SIGNS				EXIST POST		NUMBER OF NEW POSTS	SQUARE STEEL (IN)			TUBULAR STEEL Ø (IN)				SIGN FRAME REQUIRED	REMARKS	SIGN DETAIL						
								"A"	"B"	RETAIN	SALVAGE FROM	SALVAGE TO	REMOVE	RETAIN	REMOVE		1.75	2.00	2.50	FOUNDATION	3.00	3.50	4.00			5.00	DETAIL IN SHS	DETAIL ON SHEET NUMBER	DETAIL ON STD SHEET NUMBER			
																	(LB / FT)				(LB / FT)											
WOODSTOCK SB							FY-FLUORESCENT YELLOW FYG-FLUORESCENT YELLOW GREEN															"SHS"-STANDARD HIGHWAY SIGNS										
SB	6.512	F	R2-1	24	30		SPEED LIMIT 40																									
		F	VR-041	24	24		THROUGH WAY BEGINS HERE																									
		E	VR-038	24	18		STATE HIGHWAY ENDS																									
		F	VR-039	24	18		 	3.00															1	14.25' X				INSTALL THIS SIGN ON TOP, ABOVE THE SPEED LIMIT SIGN; BOTH FACE SB TRAFFIC		6		
		F	R2-1	24	30			5.00																					X			
SB	6.474	F	M3-3	24	12			2.00															1	16.5' X				NEW SIGNS WERE ACTUALLY AT SB MM 6.390	GREEN ON WHITE; INSTALL THIS NEW ASSEMBLY 200 FT ± SOUTH OF THE ASSEMBLY ABOVE		X	
		F	M1-5	30	24			5.00																							E-136B	
SB	6.390	F	M3-3	24	12		SOUTH																									
		F	M1-5	30	24		VERMONT 106																									
SB	6.316	F	R2-1	24	30																											
		F	R2-1	24	30			5.00															1	14.5' X							X	
SB	6.169	F	VW-054	30	30		 	6.25															1	13.5' X				INSTALL 350 FT ± NORTH OF "KELLY WAY (PVT)"; SOME BRUSH CUTTING MAY BE REQUIRED			E-154	
SB	5.832	F	VW-205	36	36		 	9.00															2	10.75' 9.0' X				INSTALL ACROSS FROM POLE # 5/16, JUST SOUTH OF THE RED BARN AT THE EDGE OF THE OPPOSITE SIDE OF ROAD			E-154	
SB	5.626	F	VW-133	30	30																											
SIGN SUMMARY SHEET							SHEET TOTALS	35.25	0.00	0	0	0	7	0	0	6	78.50 90.00							PROJECT NAME: READING-WOODSTOCK								
VERMONT AGENCY OF TRANSPORTATION							TOWN DIRECTIONAL TOTALS	SF	SF	EA	EA	EA	EA	EA	EA	EA	FT							PROJECT NUMBER: STPG SIGN (38)								
							338.50	0.00	2	3	3	71	0	0	66	990.00							FILE NAME: WOODSTOCK VT-106 SB	PLOT DATE: 4/7/2011								
																							PROJECT MANAGER: A. GAMBLE	DRAWN BY: M. MILLER								
																							DESIGNED BY: M. MILLER	CHECKED BY: A. GAMBLE								
																							WOODSTOCK VT-106 SOUTHBOUND 1	SHEET 39 OF 49								