
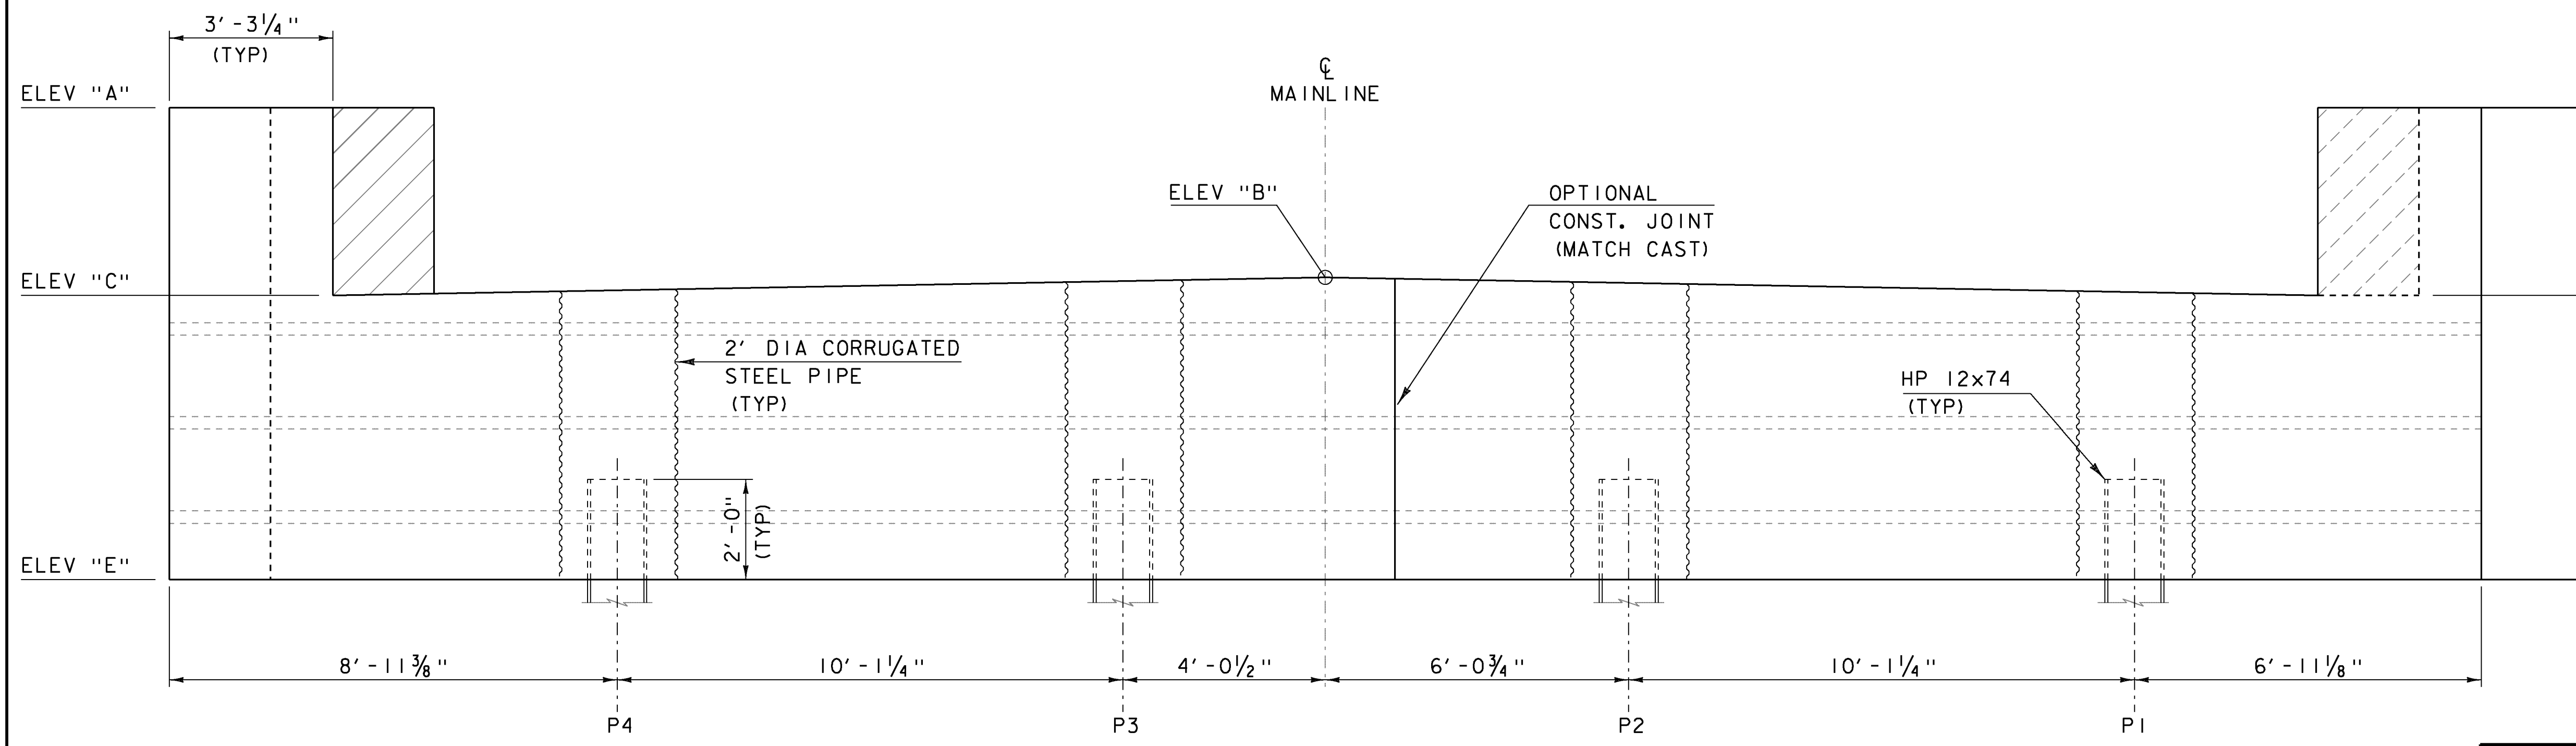
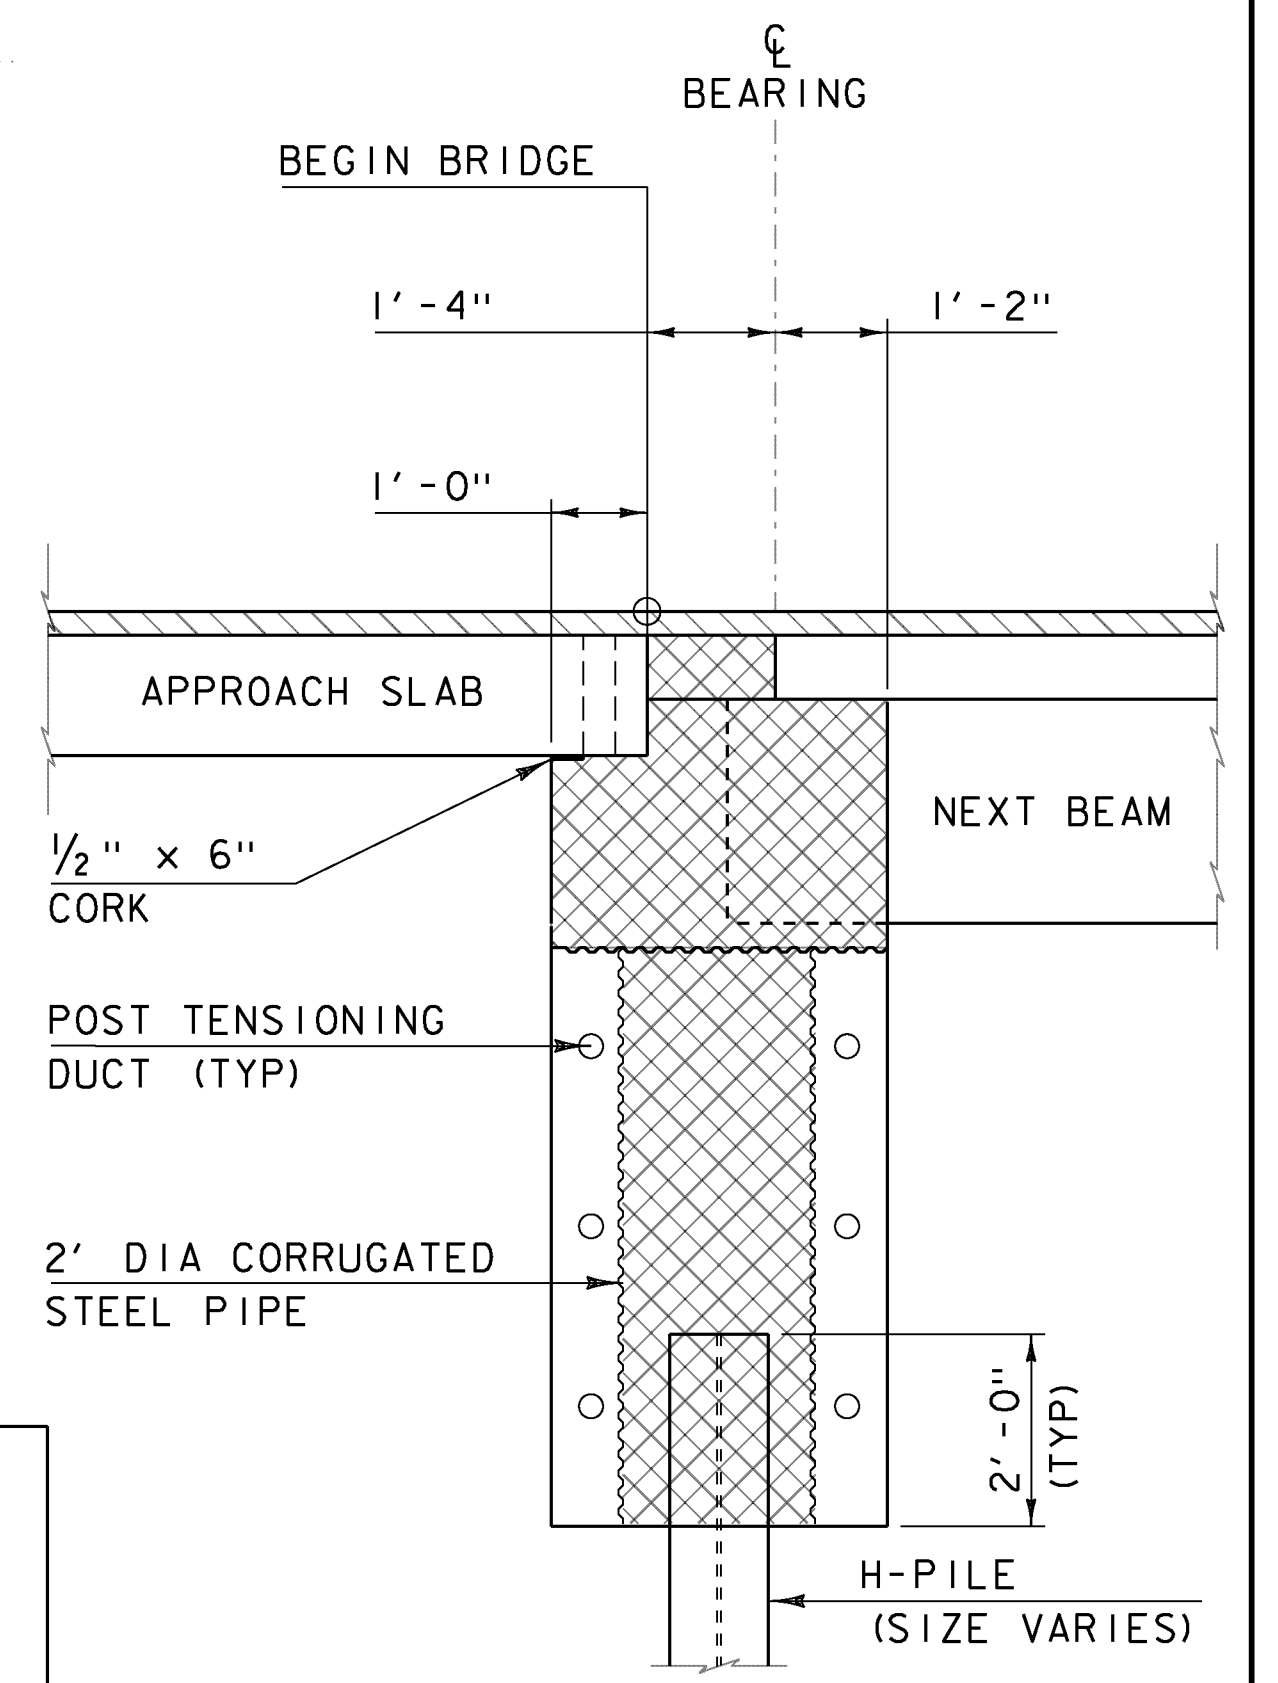


PCU I ELEVATIONS

	ABI
ELEV "A"	885.35
ELEV "B"	881.89
ELEV "C"	881.51
ELEV "D"	881.51
ELEV "E"	875.85

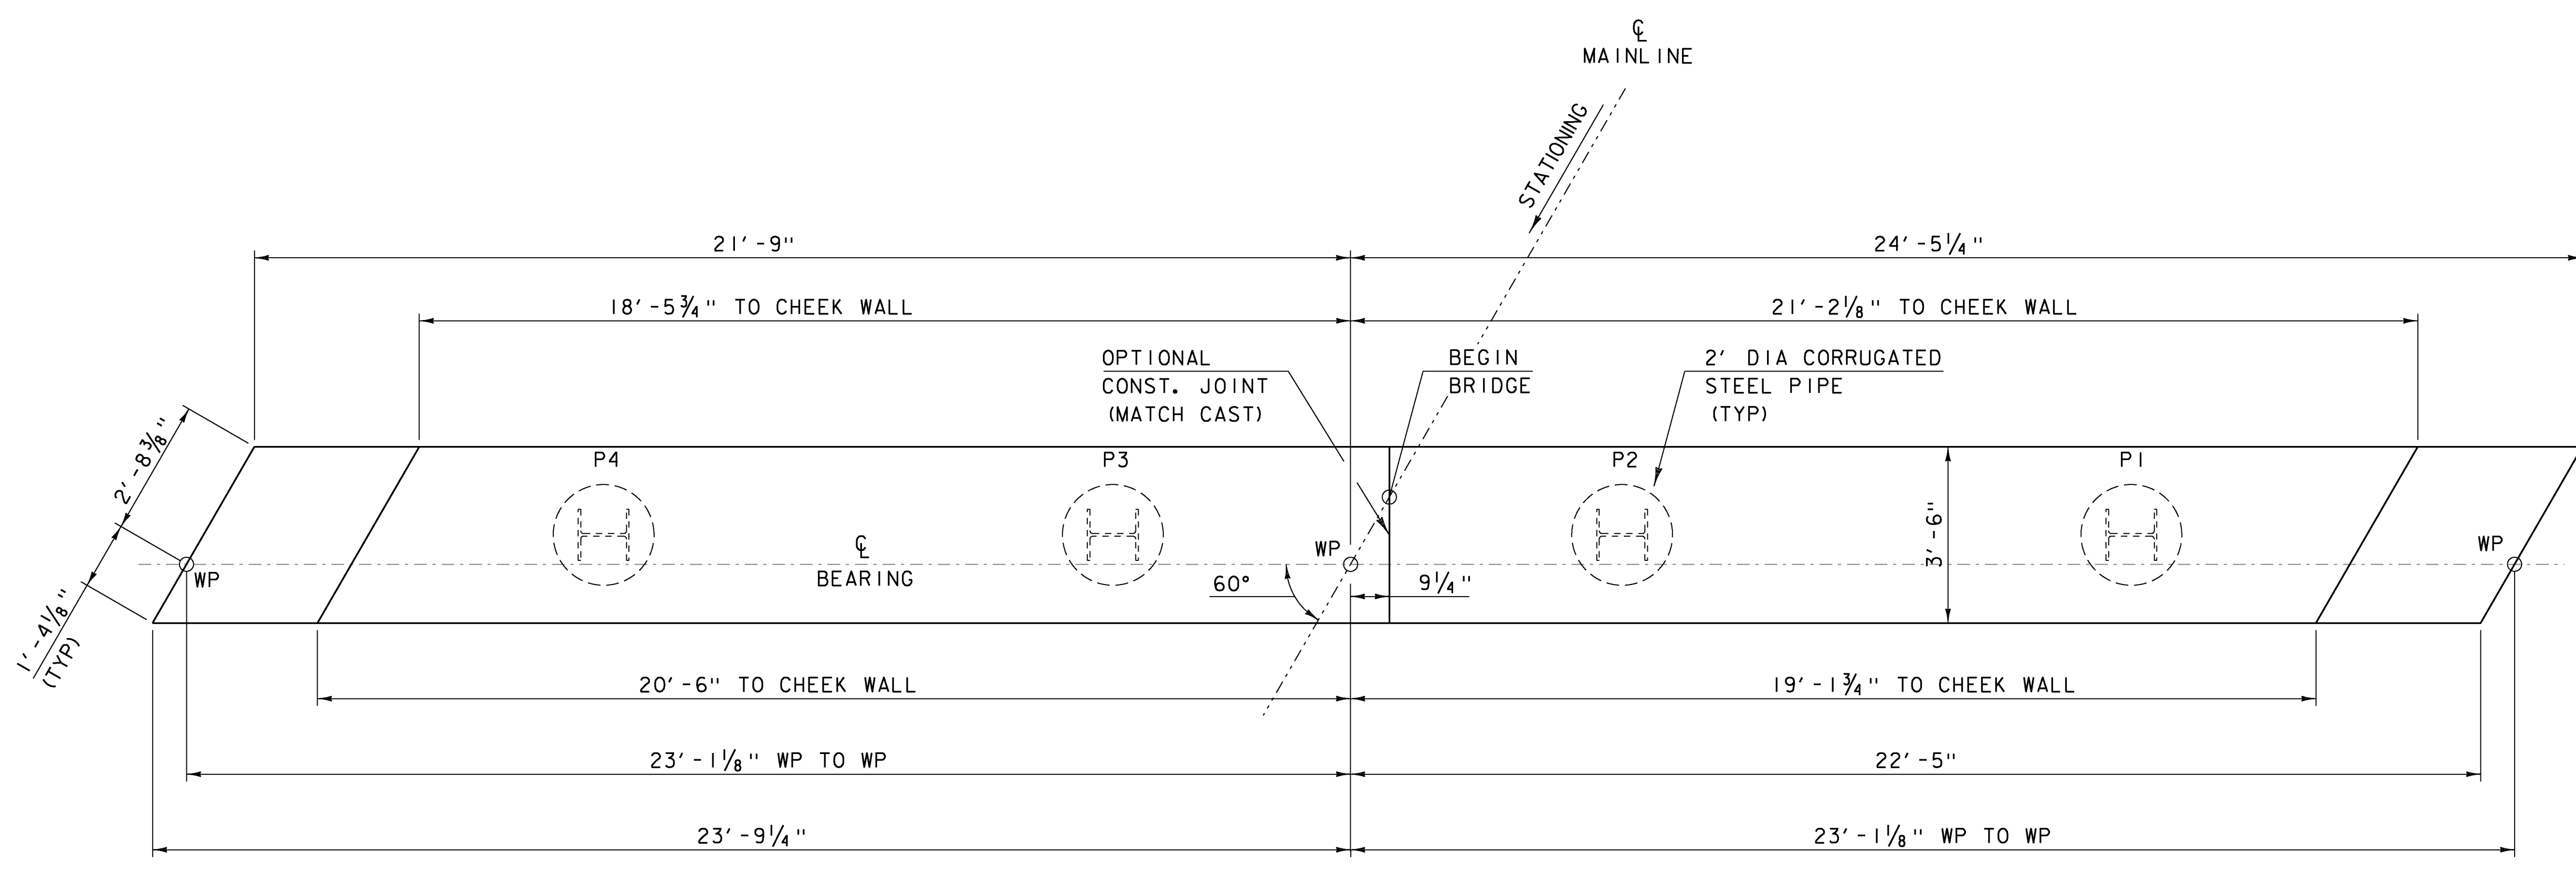

PROJECT NAME: BARNARD
 PROJECT NUMBER: ER BR F 024(39)
 FILE NAME: sl0c410sub.dgn
 PROJECT LEADER: K. HIGGINS
 DESIGNED BY: W. LAMMER
 ABUTMENT I PLAN
 PLOT DATE: 16-SEP-2013
 DRAWN BY: J. SALVATORI
 CHECKED BY: W. LAMMER
 SHEET 21 OF 39