


ABUTMENT 2 PLAN (PCU 2)

SCALE 1/2" = 1'-0"

PCU 3 ELEVATIONS

	AB2
ELEV "A"	885.50
ELEV "B"	882.03
ELEV "C"	881.65
ELEV "D"	881.65
ELEV "E"	876.00

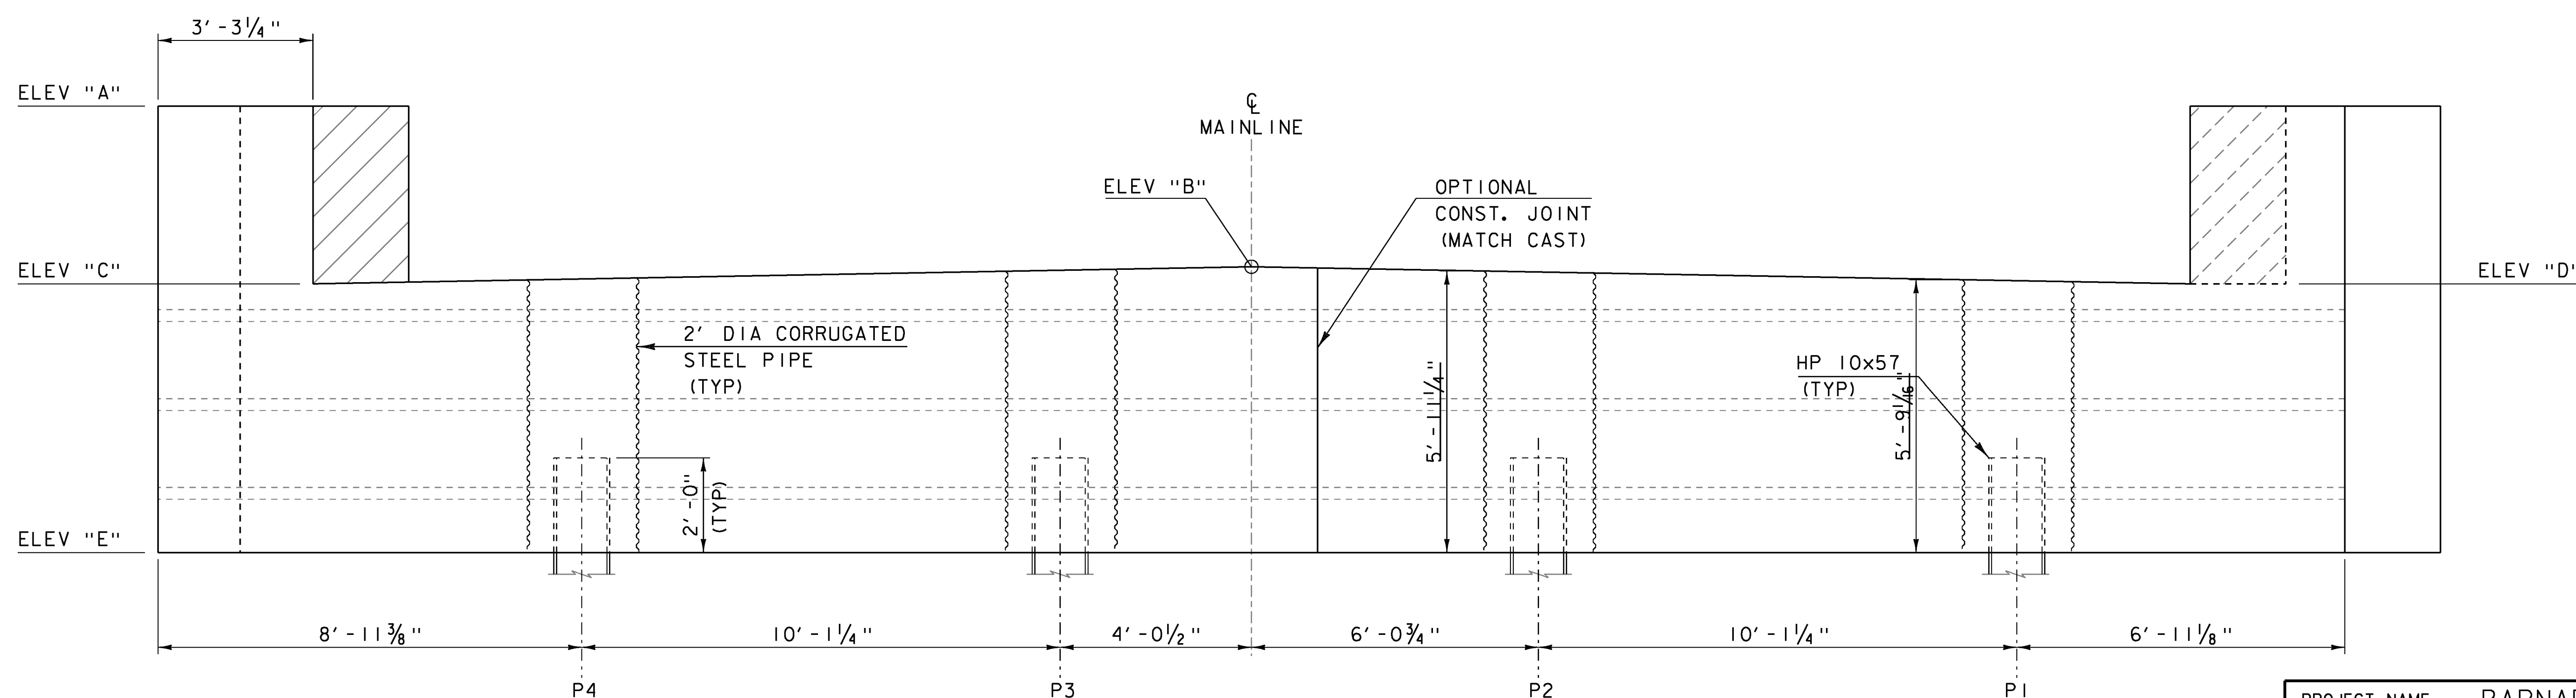

ABUTMENT 2 ELEVATION (PCU 2)

SCALE 1/2" = 1'-0"

PROJECT NAME: BARNARD
PROJECT NUMBER: ER BR F 0241(39)

FILE NAME: sl0c410sub.dgn
PROJECT LEADER: K. HIGGINS
DESIGNED BY: W. LAMMER
ABUTMENT 2 PLAN

PLOT DATE: 29-AUG-2013
DRAWN BY: J. SALVATORI
CHECKED BY: W. LAMMER
SHEET 23 OF 39