



369+25



369+75

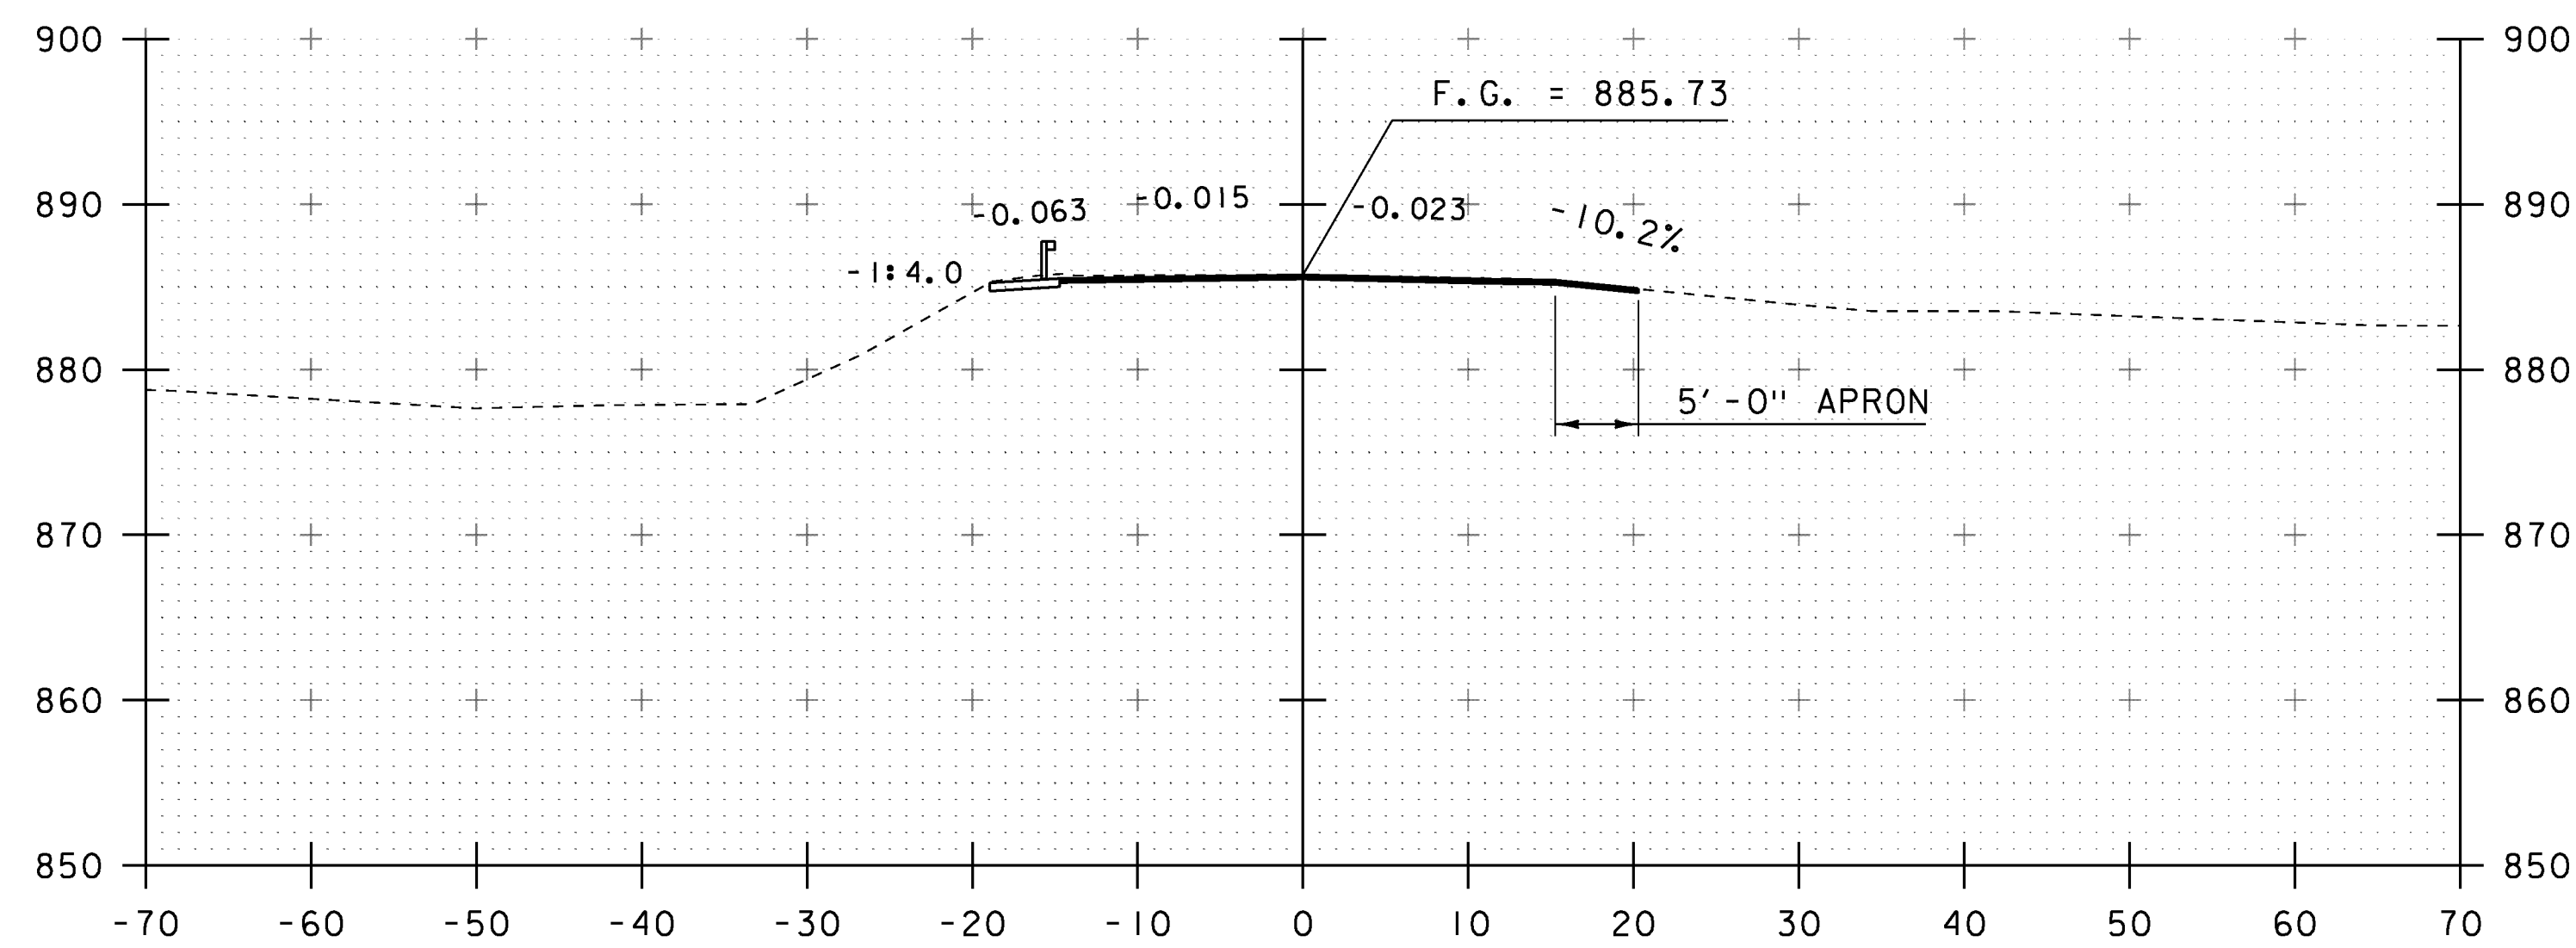

369+00
BEGIN APPROACH

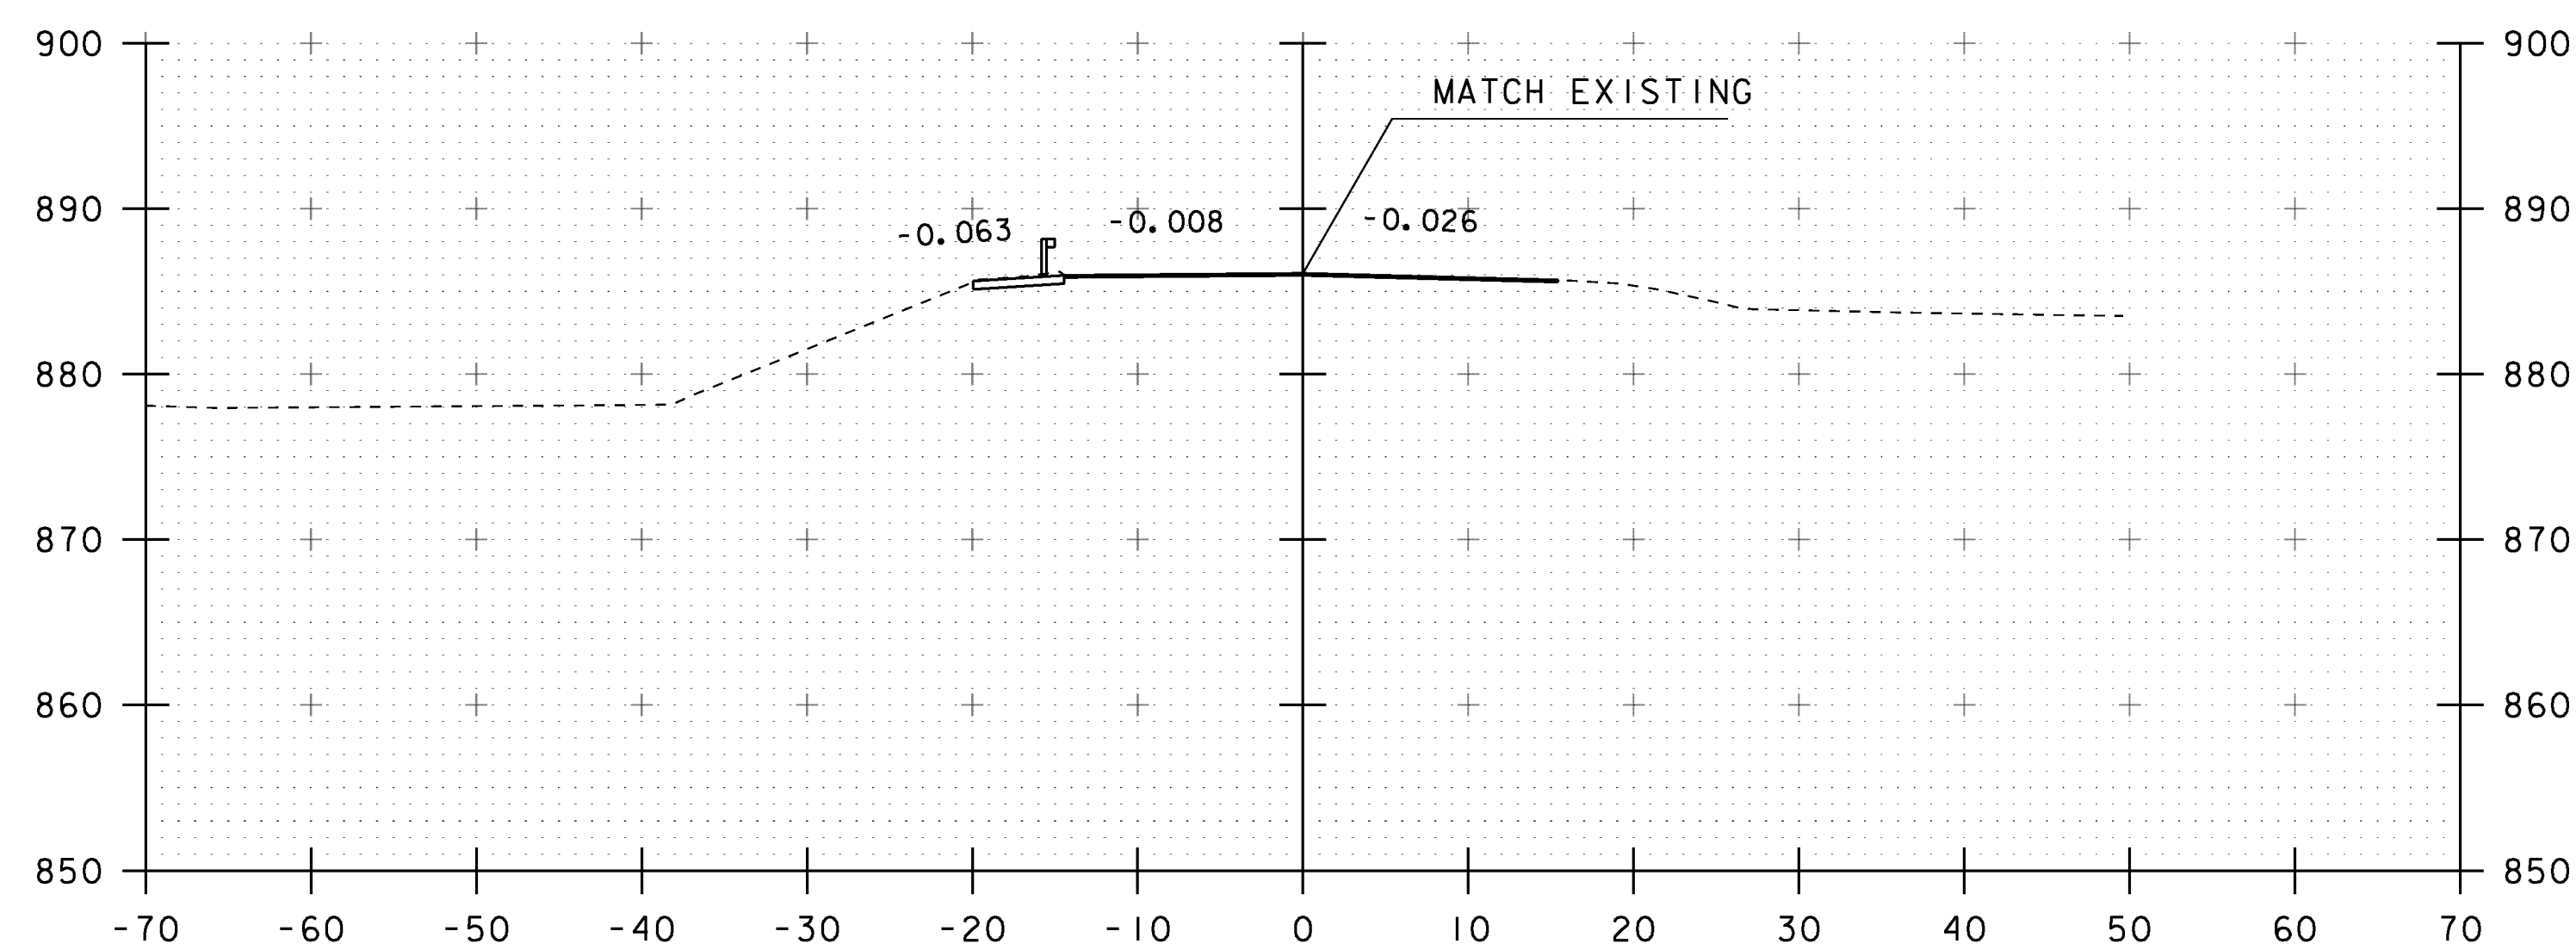

369+50
BEGIN PAVEMENT

STA. 369+00 TO STA. 369+75

PROJECT NAME: BARNARD	
PROJECT NUMBER: ER BRF 0241(39)	
FILE NAME: sl0c410xsl.dgn	PLOT DATE: 29-AUG-2013
PROJECT LEADER: K. HIGGINS	DRAWN BY: J. GRIGAS
DESIGNED BY: W. LAMMER	CHECKED BY: J. SALVATORI
MAINLINE SECTIONS	SHEET 32 OF 39