




372+20

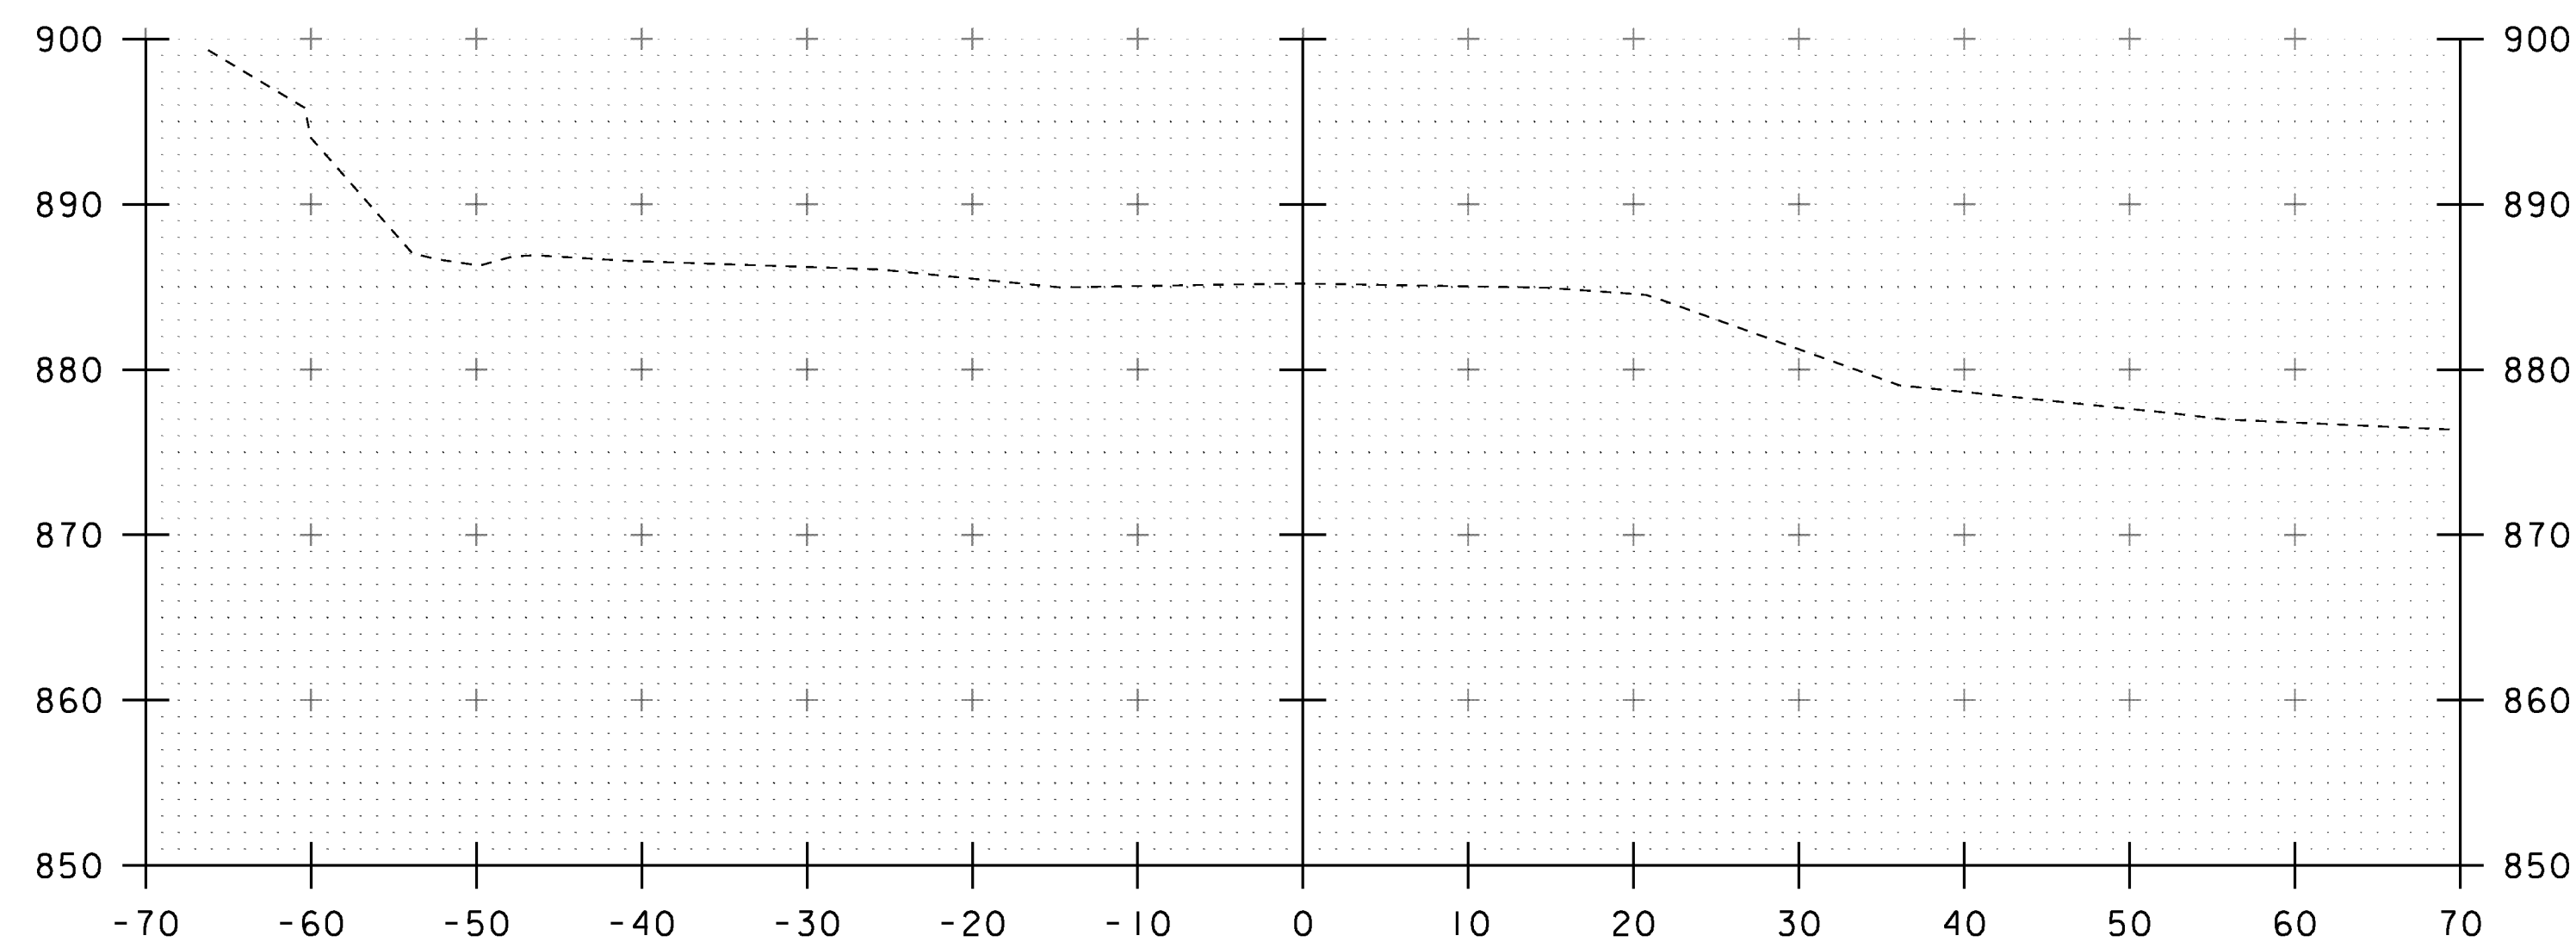

372+75
END APPROACH

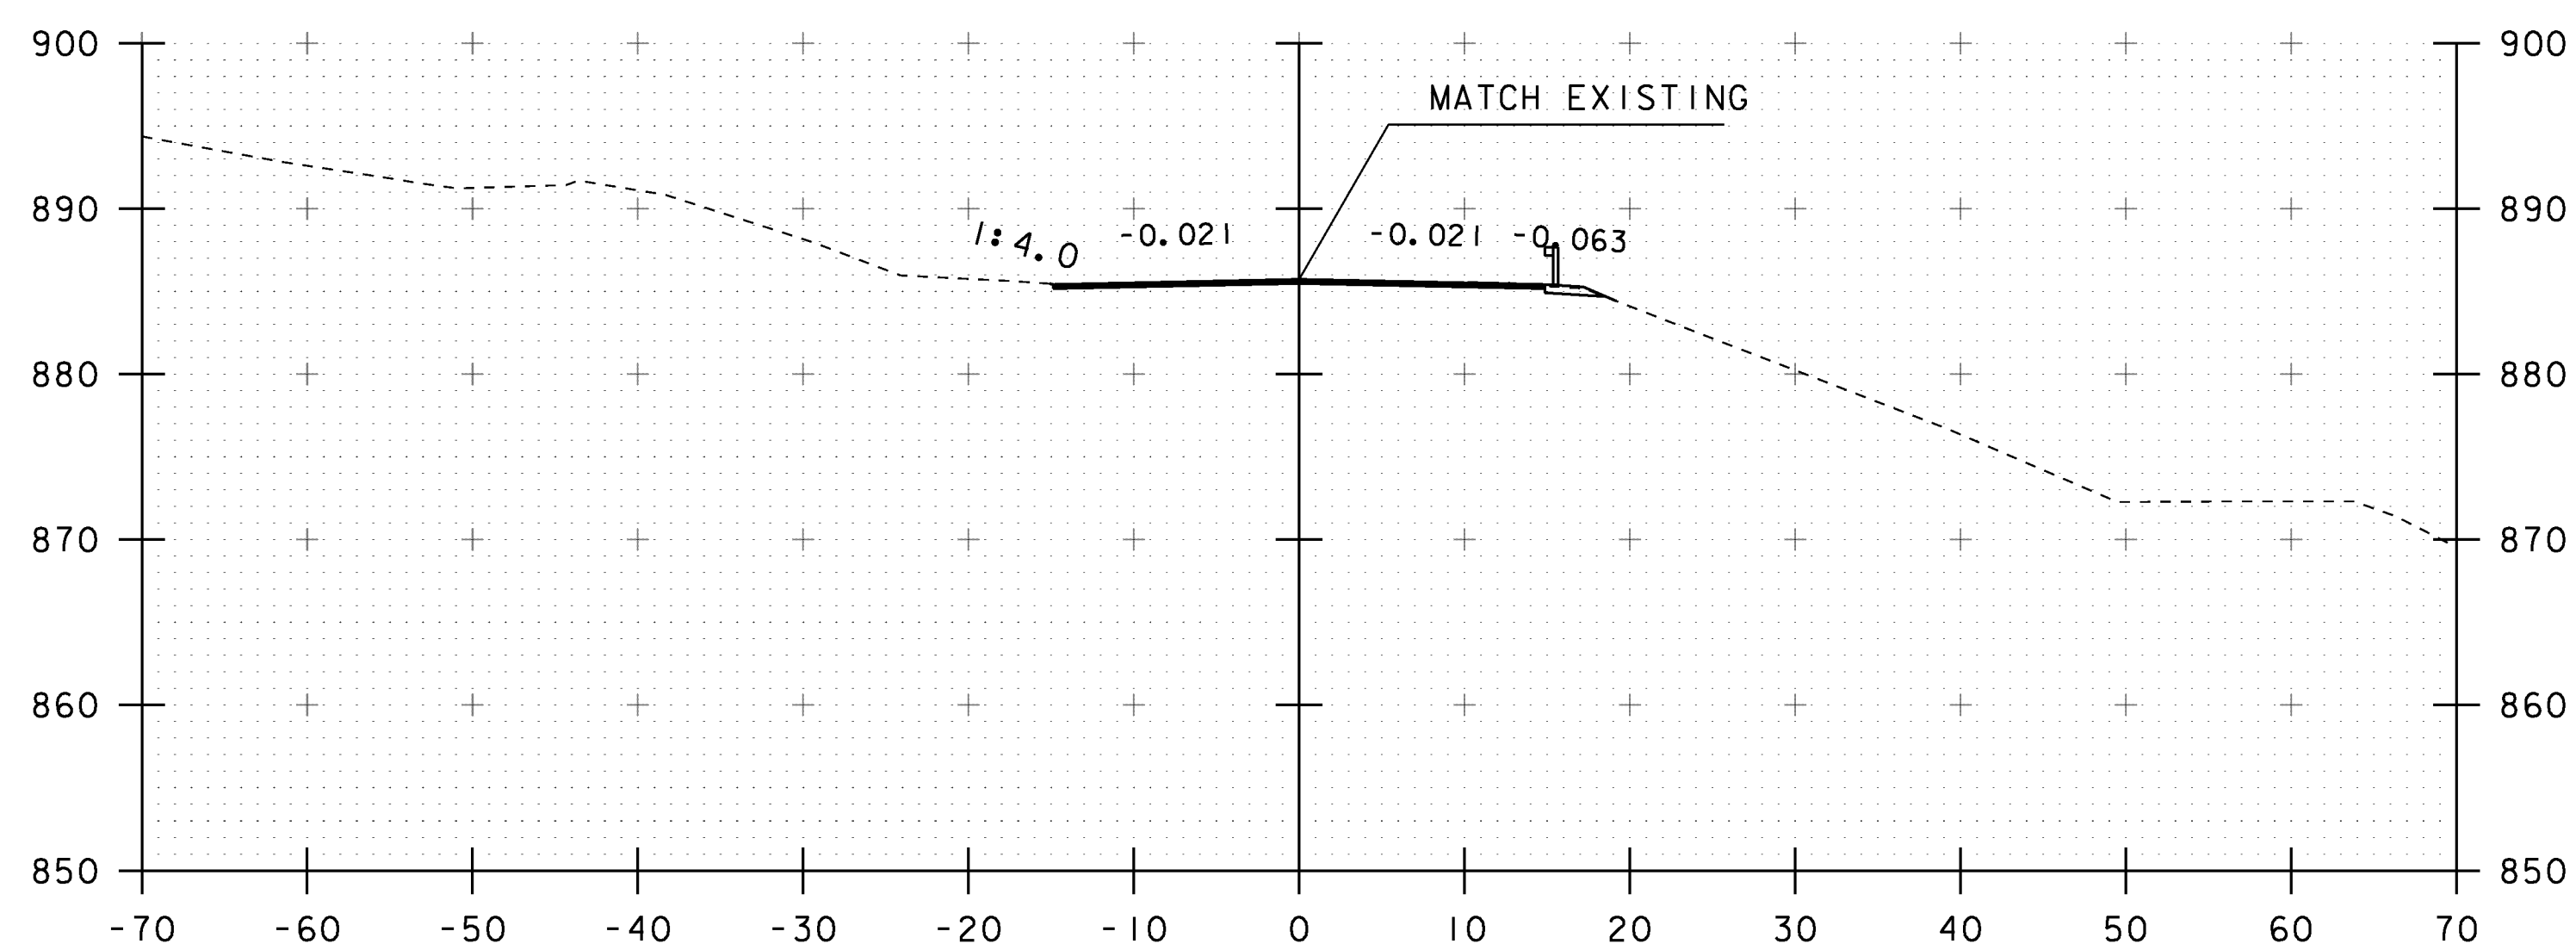

372+00
END PROJECT STA 371+85.00

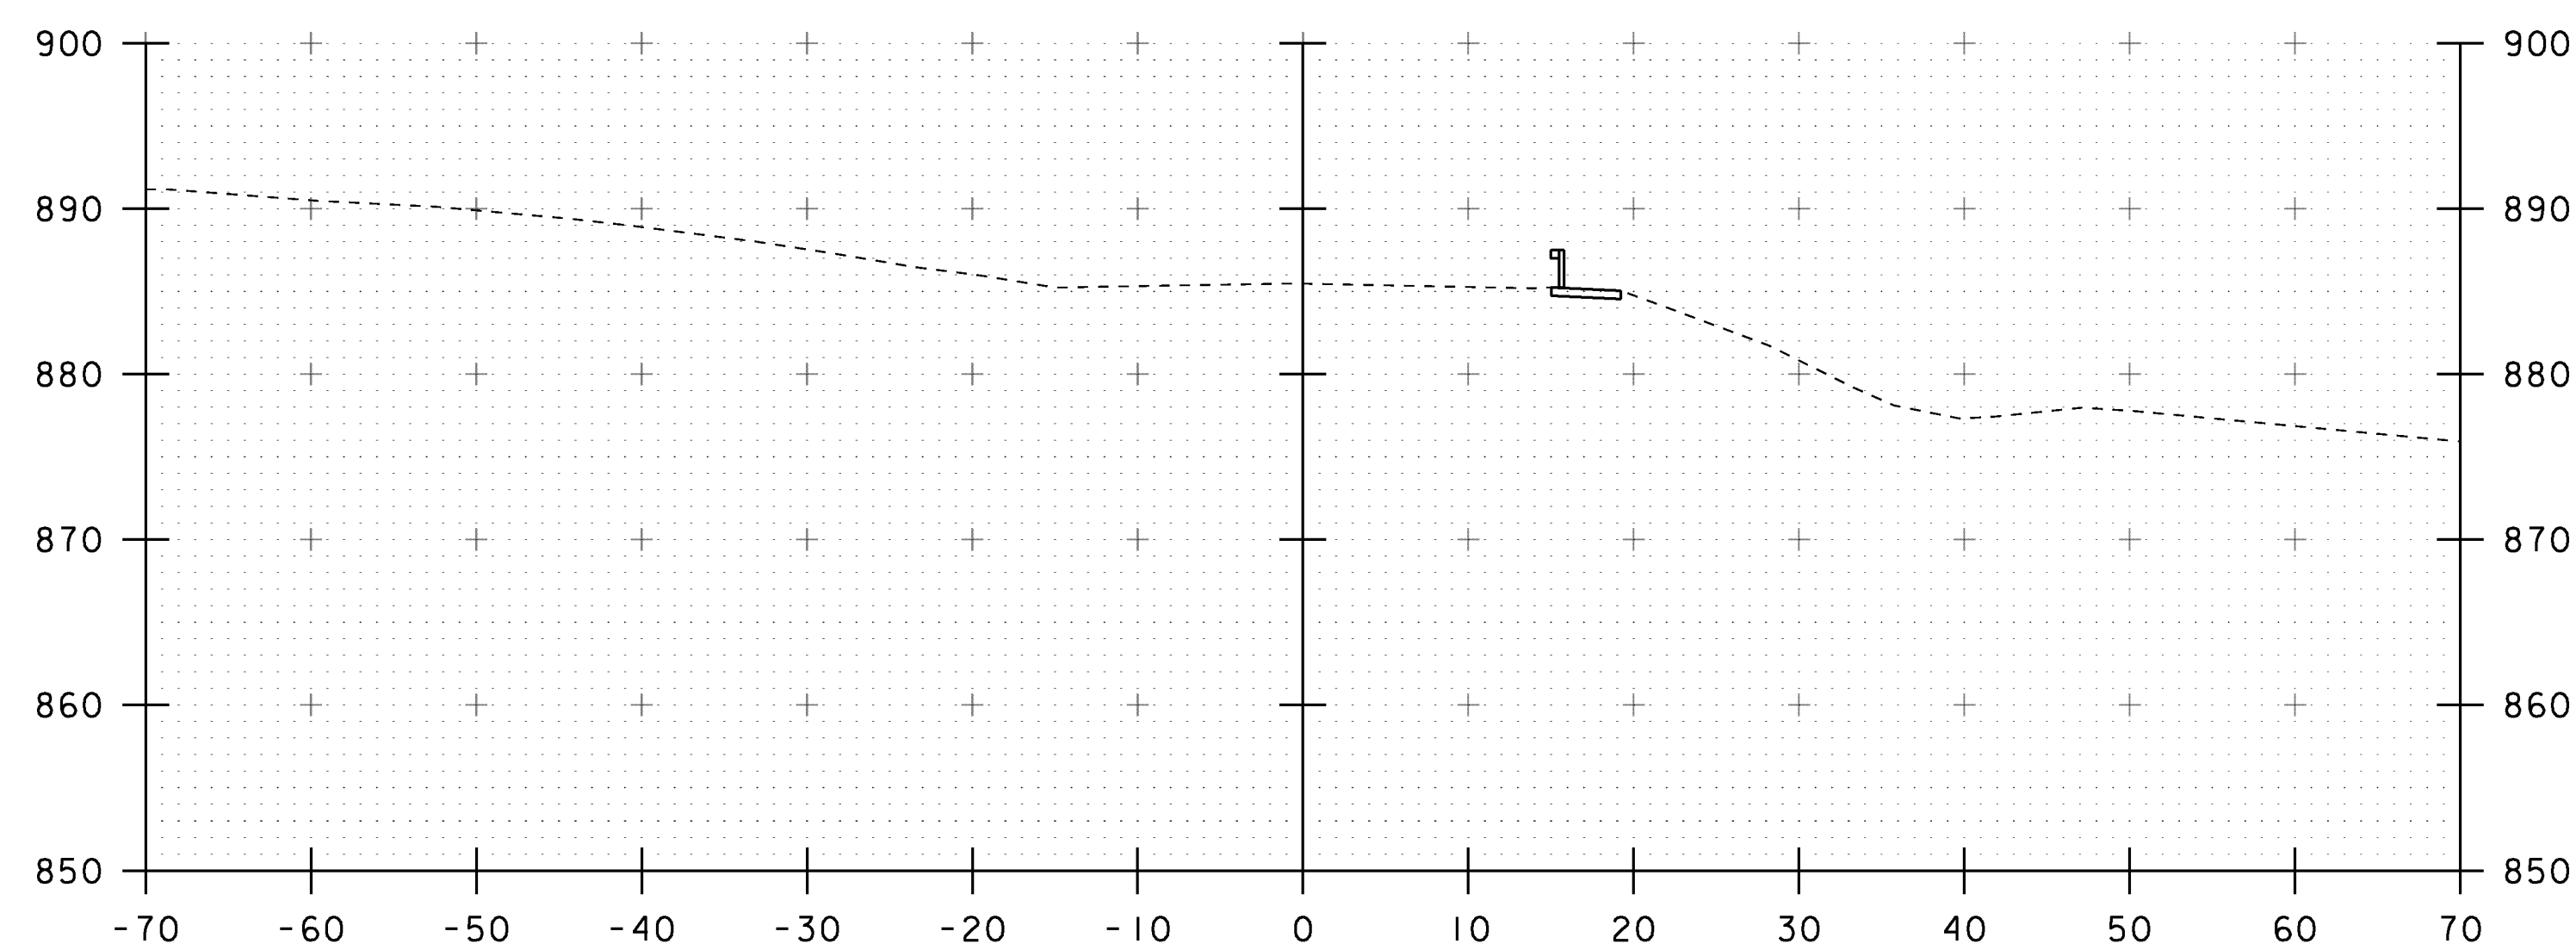

372+50
END PAVEMENT STA 372+35.00

PROJECT NAME: BARNARD	PLOT DATE: 29-AUG-2013
PROJECT NUMBER: ER BR 0241(39)	DRAWN BY: J.GRIGAS
FILE NAME: sl0c410xsl.dgn	CHECKED BY: J. SALVATORI
PROJECT LEADER: K. HIGGINS	SHEET 35 OF 39
DESIGNED BY: W. LAMMER	
MAINLINE SECTIONS	

STA. 372+00 TO STA. 372+75